

SURVEY OF
 LOT No. 3920
 NORTHEAST HEIGHTS ALLOT.
 BELLEFONTAINE, OHIO
 SCALE 1" = 20'


INDEXED ON MAP
 2580 IP
 INDEXED ON MAP

Surveyed by D. L. Dodson
 Reg. Surveyor No. 4270
 May 9, 1959

Lot 3920
 Bellefontaine, Ohio

Dodson
 Greenlin

May 18, 1959
 55

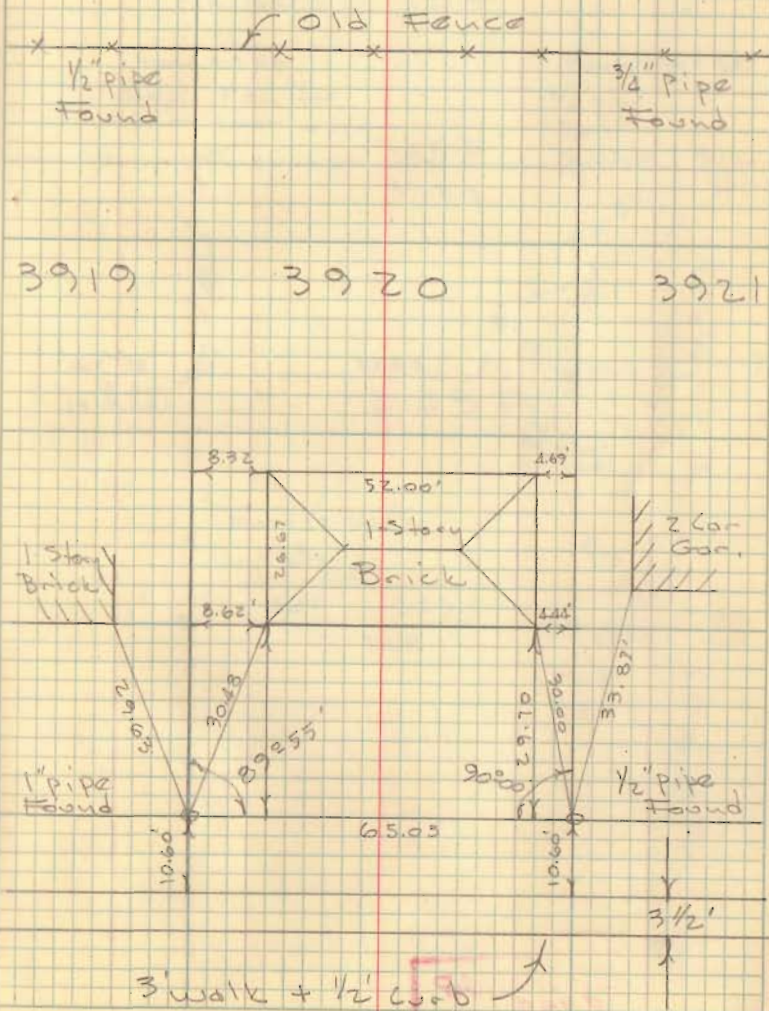

INDEXED ON MAP
 2580

Lot 3920.

Bk 3 pg 55

3921


3/4" Pipe Found

1/2" Pipe Found


4.69'

52.00'

8.72'

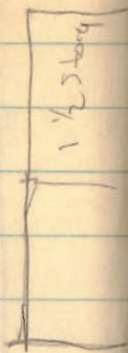




1-5 Story Building

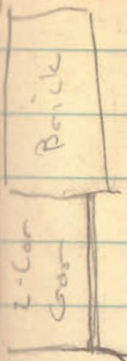

1-5 Story Building

24.82
21.85
5.32

3' walk
1/2" curb

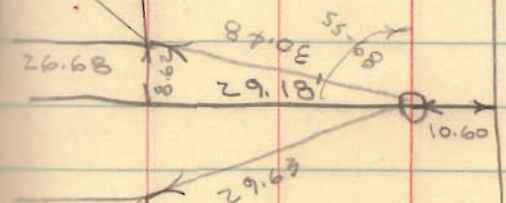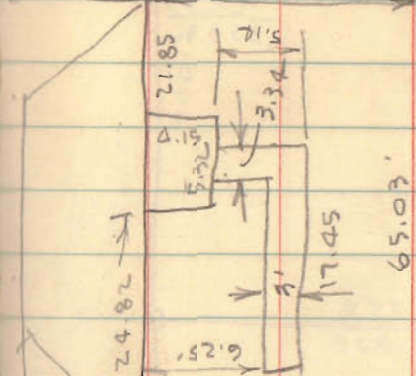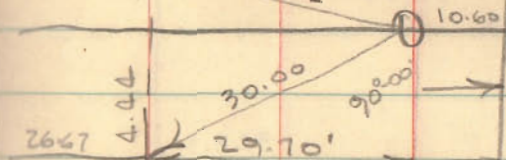

1" pipe Found

May 18, 58
16

INDEXED ON MAP
2580

INDEXED ON MAP