

WASHINGTON AVE. 50'

25'



Curb

Pipe


Pipe

50.0'

29.90'

5.15'

10.38

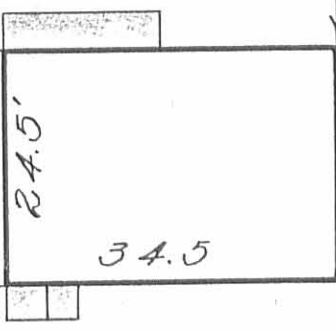

10.35

34.5

5.15'

3075

3073

3074

231.30

215.30'

52.50'

Pipe


Pipe



LOT 303074
BELMONT ADDITION
BELLEFONTAINE, OHIO
SCALE 1" = 20'

Dan L. Dodson
Surveyed by Dan L. Dodson
Registered Surveyor No. 4270
May 12, 1960

INDEXED ON MAP
2583 1P

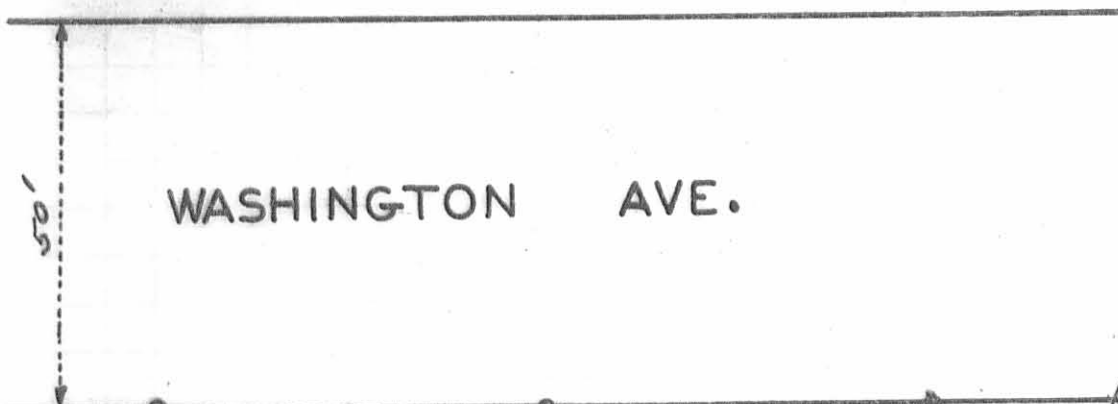

Scale 100' short

I find no encroachments on Lot 3075 February 10, 1954 Foster F. Wright

LOT 3075

ELMORE SURVEY

LOT 3075
BELMONT ADDITION

BELLEFONTAINE OHIO
FEBRUARY 1954 1"=25'
FOSTER F. WRIGHT

INDEXED ON MAP
2583 28


WASHINGTON AVE. 50'

25'

3074

3072

3073

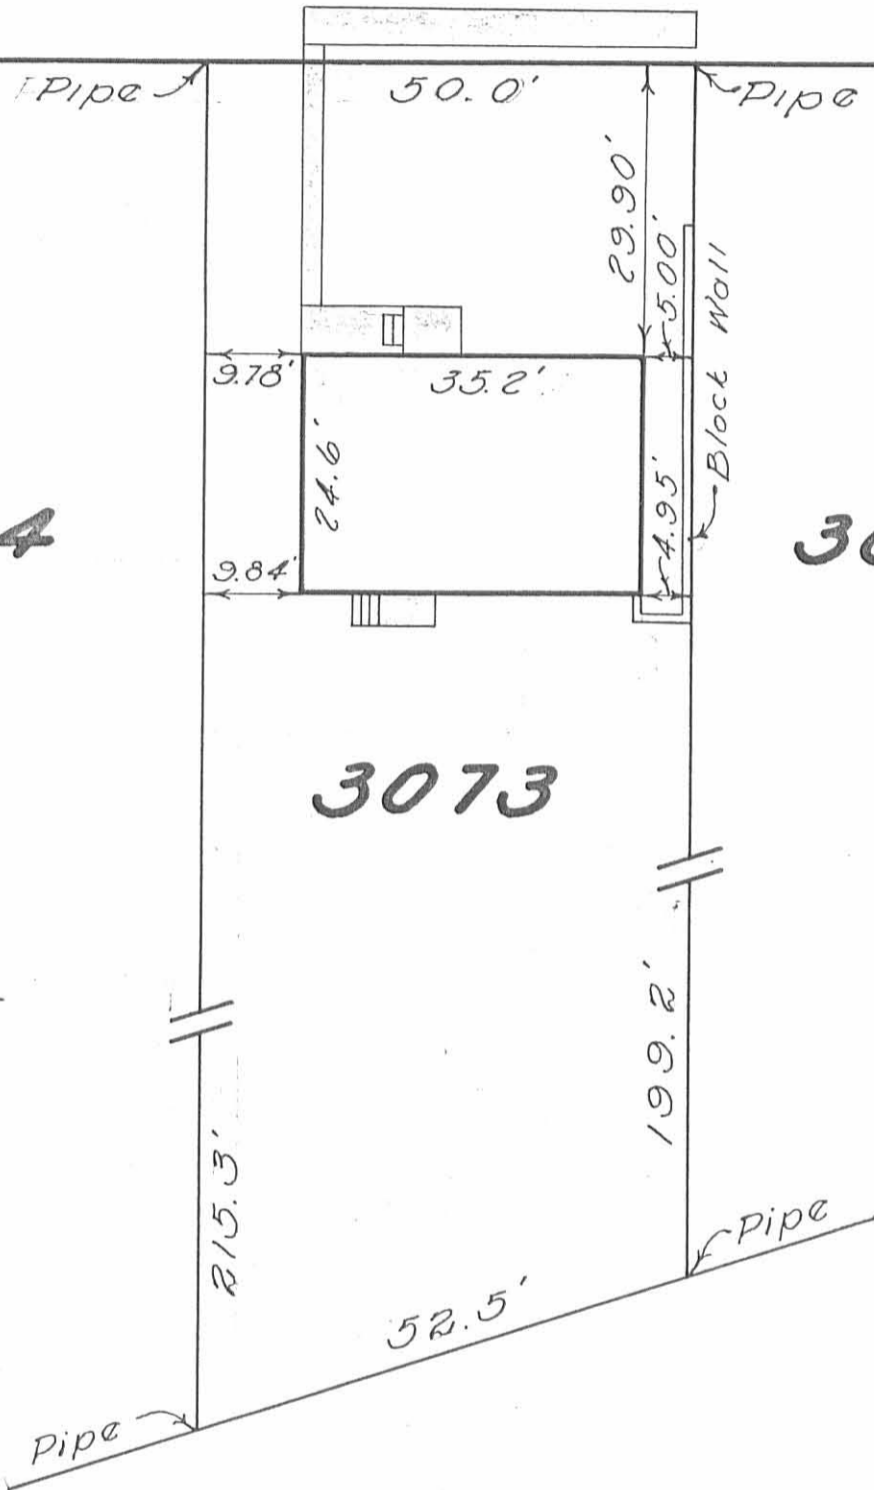

LOT 3073
BELMONT ADDITION
BELLEFONTAINE, OHIO
SCALE 1" = 20'



Dan L. Dodson

Surveyed by Dan L. Dodson
Registered Surveyor No. 4270
November 28, 1959

INDEXED ON MAP
2583 3P



WASHINGTON AVE.

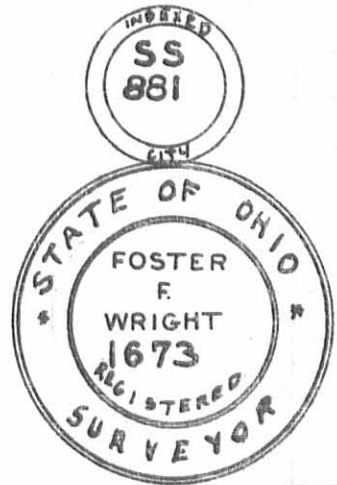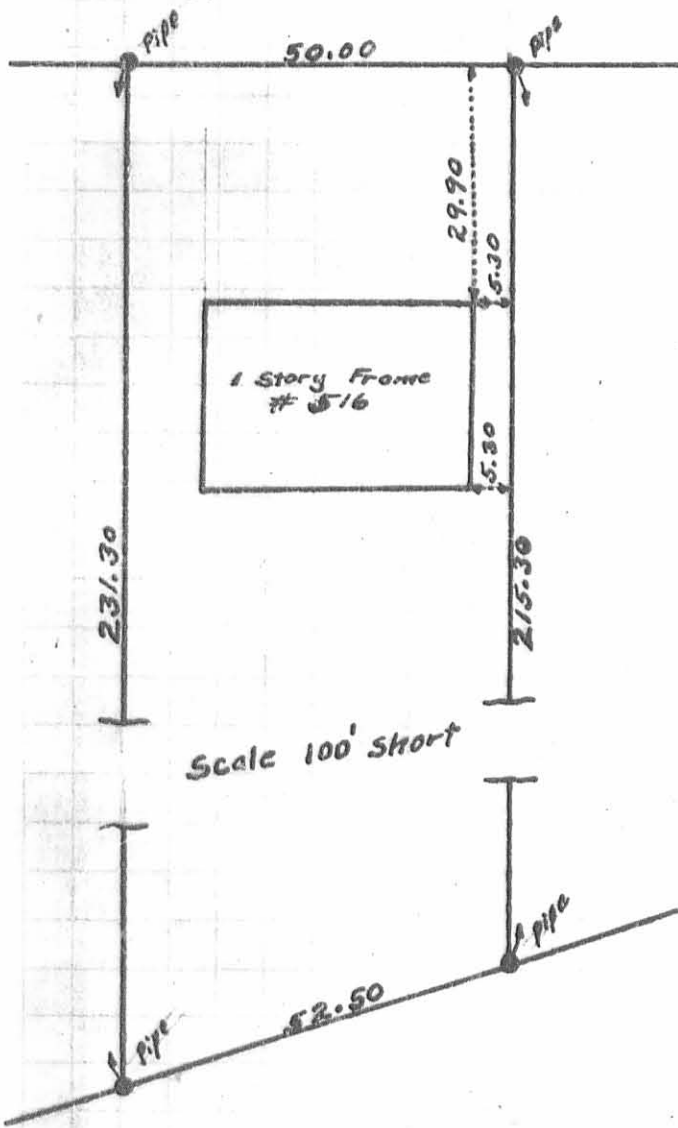

Field Book 262
Page 37

ELMORE SURVEY

LOT 3074
BELMONT ADDITION

BELLEFONTAINE OHIO
JULY 1954 1" = 25'

FOSTER F. WRIGHT


I find no encroachments on
Lot 3074 July 30, 1954

Foster F. Wright

INDEXED ON MAP
2583 4P


Lot 3073
Bellefontaine

INDEXED ON MAP
2583

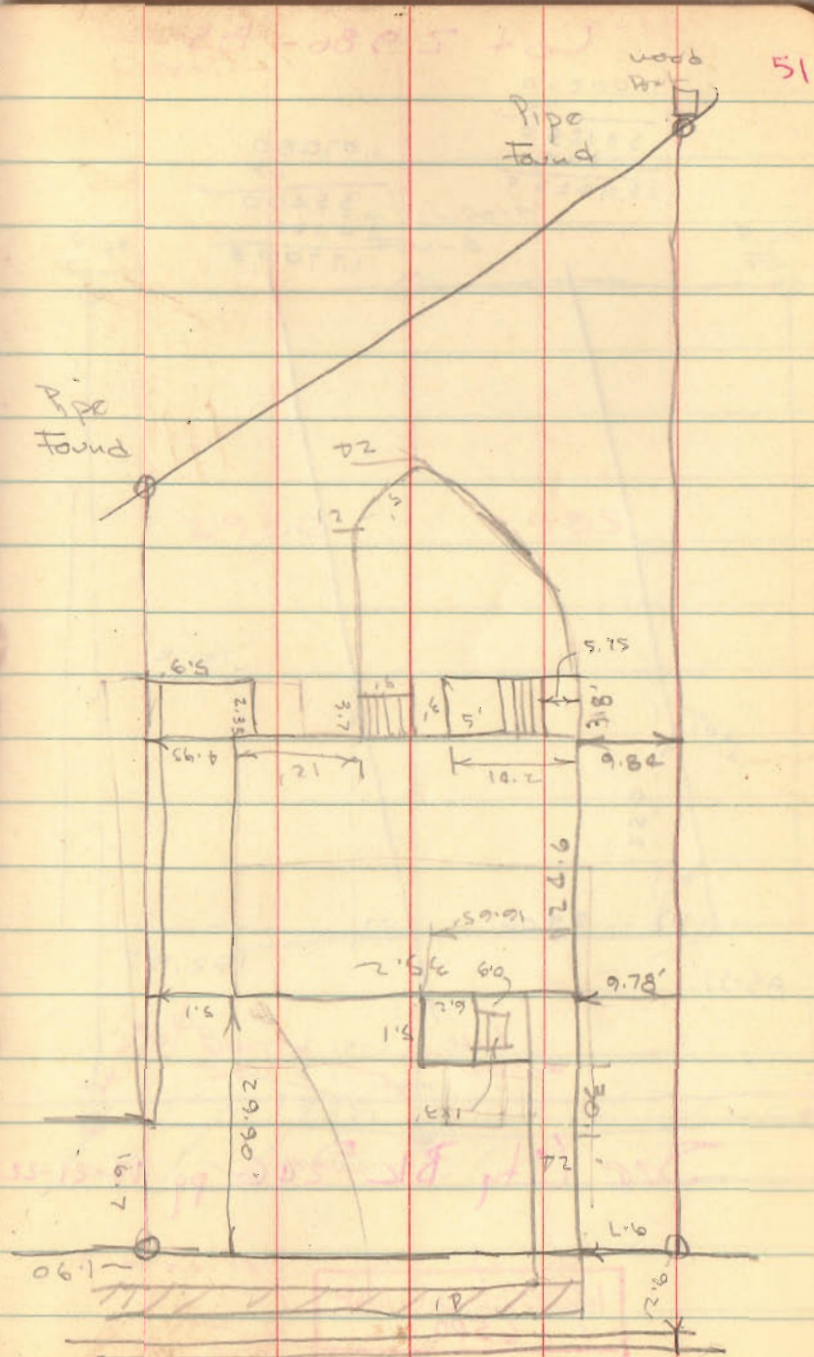

3074

Bellefontaine

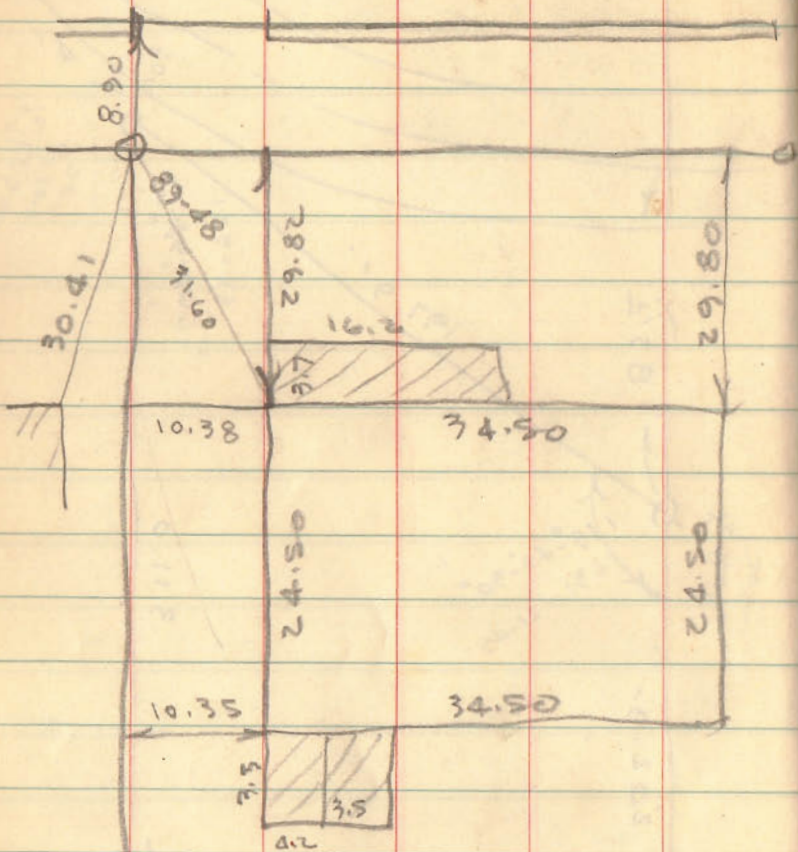

INDEXED ON MAP
2583