
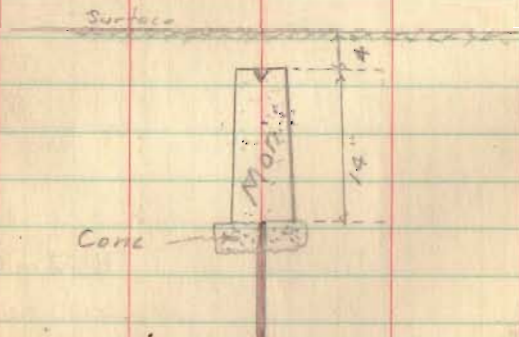


Sept. 22/43

Daily
Dyert
Burket
Knief

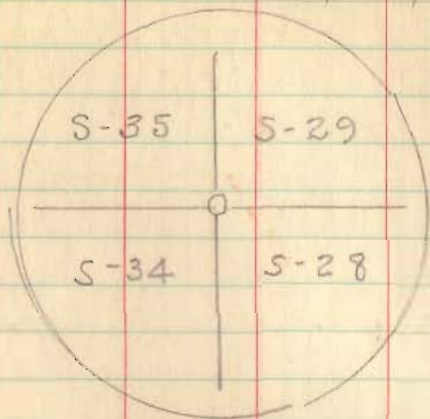

Drove iron bar straight down until it struck a big rock - would go no further
 Cut off man. to 14" len. placed directly over bar, set in conc. 4" below surface


35 | 29
 34 | 28
 T4R14

E. Columbus - Bellefontaine

20

Henning

Maxwell

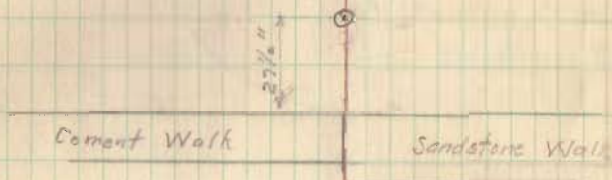

E. Columbus

Found Bar - Sec. Cor. - $27\frac{1}{2}$ " N. of sidewalk
 Set man directly over Bar

INDEXED ON MAP

2634 Bellefontaine

INDEXED ON MAP