

BRUBAKER SURVEY
V. M. S. 4399-LAKE TOWNSHIP
BELLEFONTAINE, OHIO


October 28, 1961

The following described real estate situated in the City of Bellefontaine, Lake Township, Logan County, Ohio and being part of Virginia Military Survey 4399 and more particularly described as follows:

Beginning at the southeast corner of Lot 3708 of Brookwood Addition to the City of Bellefontaine as shown on designated in the Logan County Recorders Plat Book 4, Volume D, Page 65; thence with the east line of said lot 3708, N. 17°-57' W. 89.2 feet to the northeast corner of said lot and in the center of Blue Jacket Creek, passing an iron pipe at 54.4 feet; thence with the center of said Creek, Northeasterly, 131.7 feet to the west line of Brookwood Drive; thence with the west line of said street, South, 91.5 feet to an iron pipe at the northeast corner of C. E. Lundy's 0.02 acre tract; thence with the north line of said tract, S. 83°-56' W. 103.7 feet to the place of beginning.

Containing 0.24 of an acre more or less.

INDEXED ON MAP
2719 ID

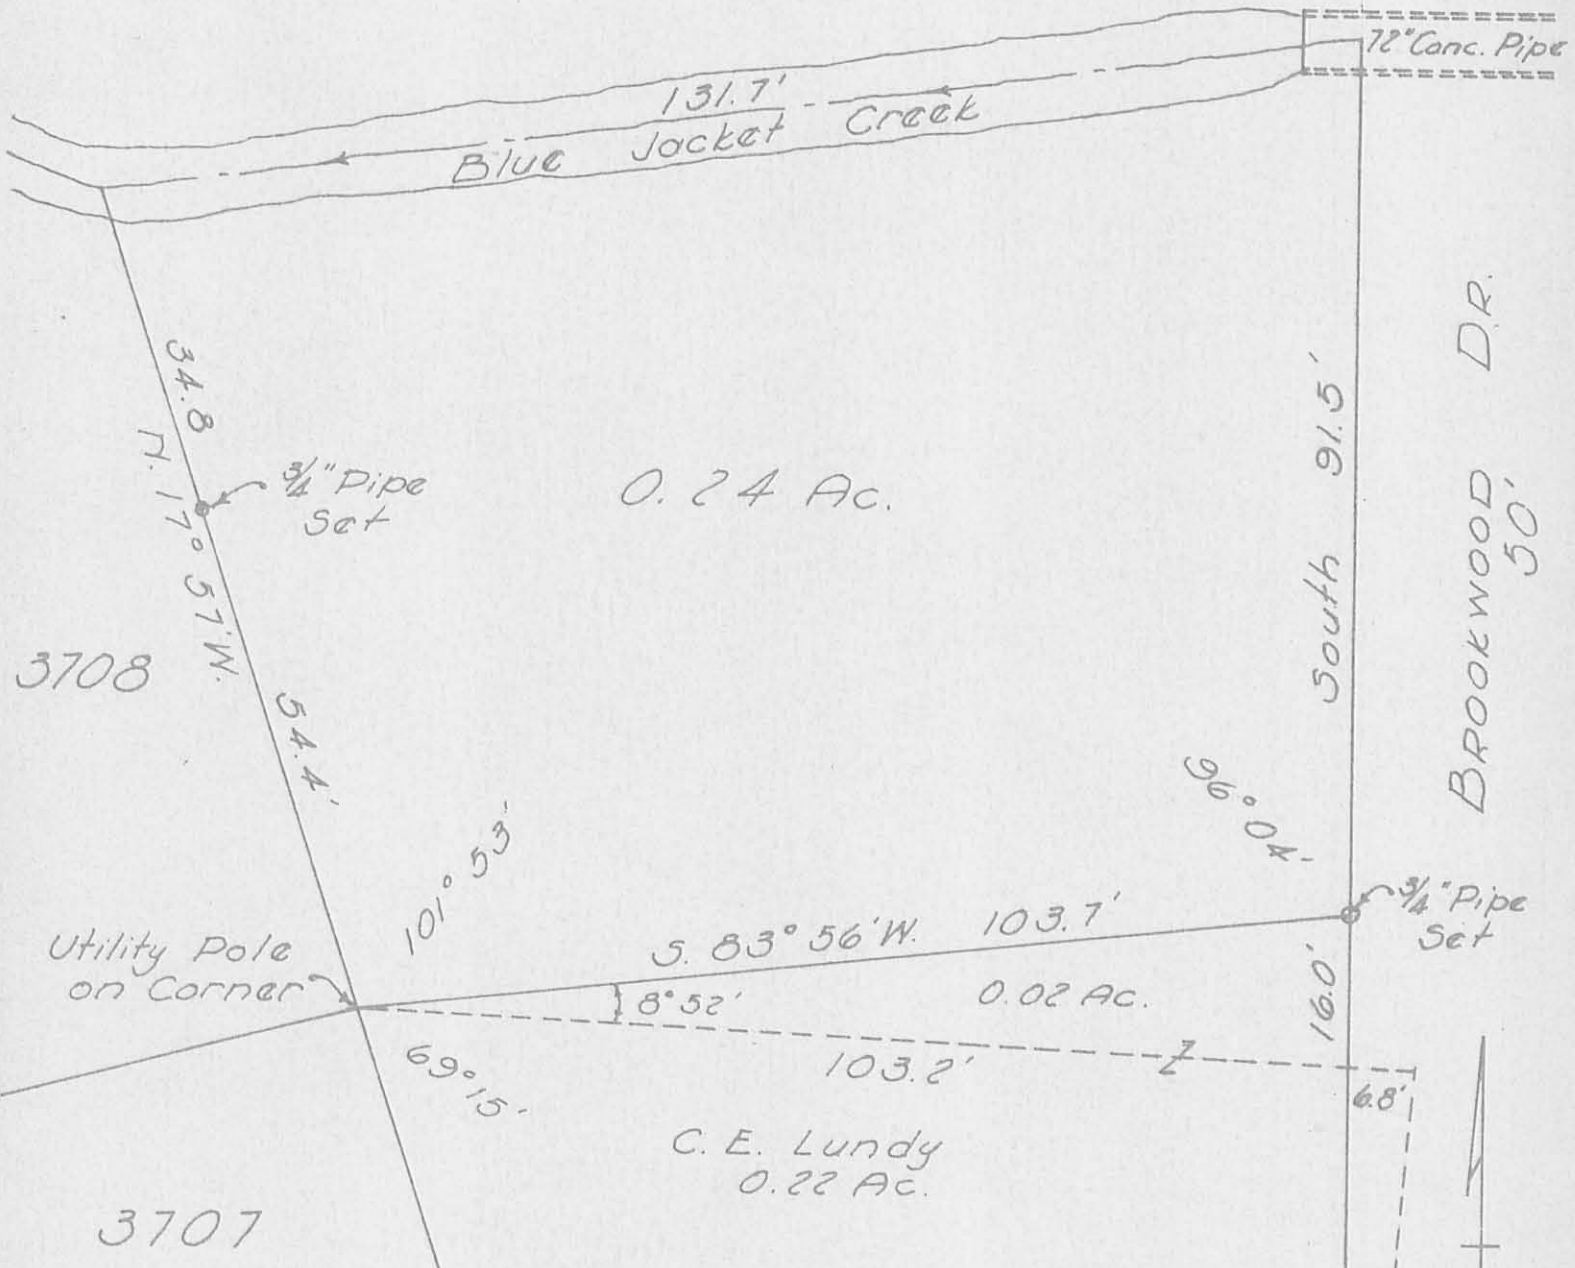

BRUBAKER SURVEY
 V. M. S. 4399
 BELLEFONTAINE, OHIO
 OCTOBER 28, 1961
 SCALE 1" = 20'

Dan L. Dodson
 Surveyed by Dan L. Dodson
 Registered Surveyor 4270

2719 IP

INDEXED ON MAP