

STO. OIL
N. MAIN

Co.

72 58
17 52
26 40
57 30
2 109


220.27
94.00
126.27

220.29
89
135.27

Man. Box @
Dowell Ave.

W. Main St.




INDEXED ON MAP
3793

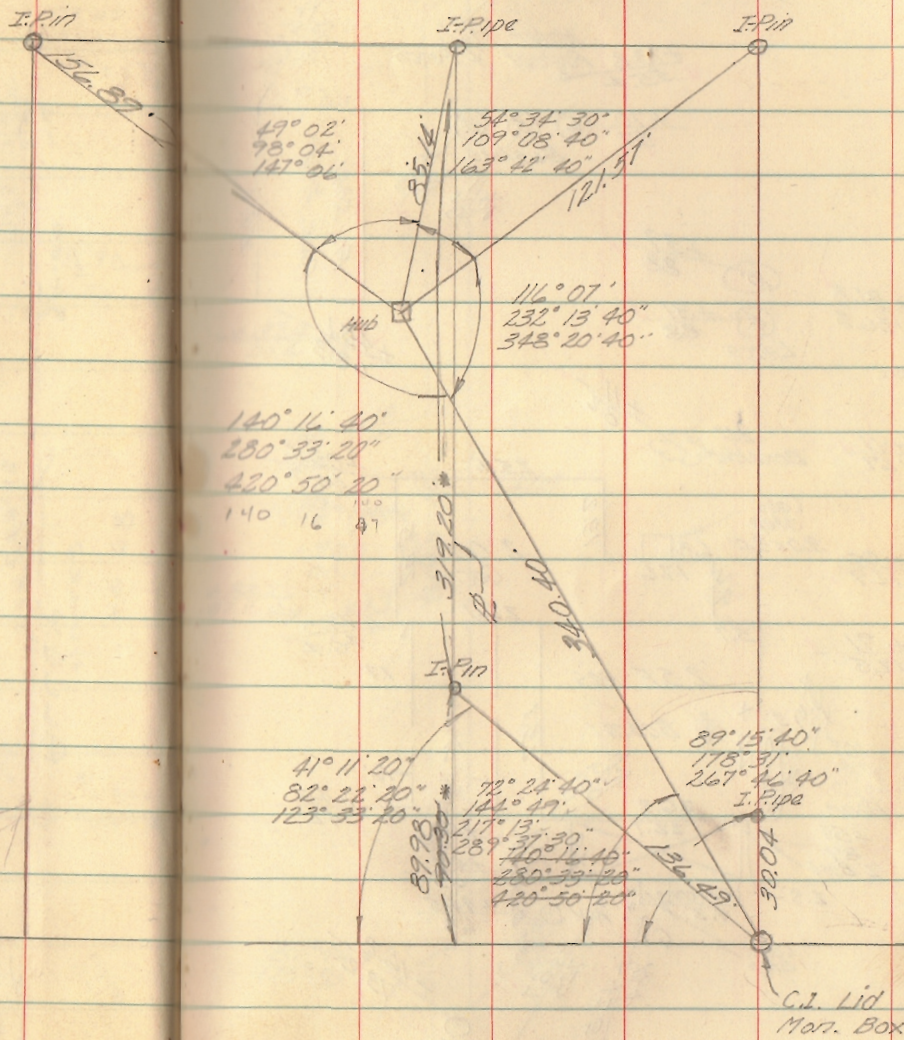

* Measured off Grid

E Grid

2+00

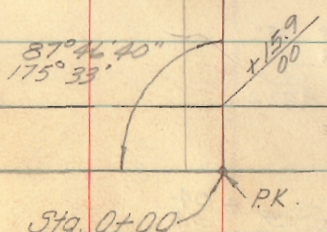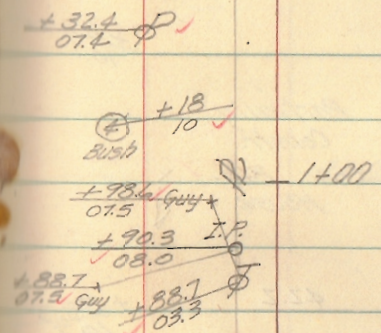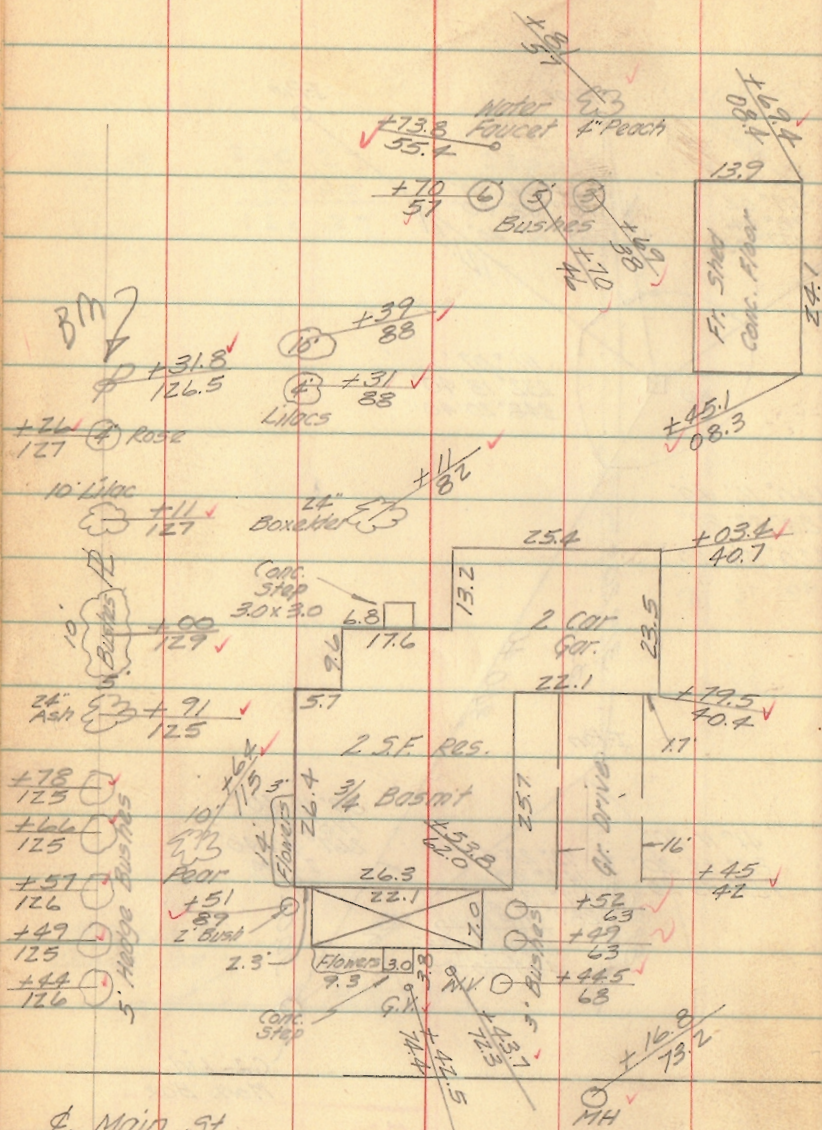

9+22

Sta. 0+00

P.K.

MOR. BOX

INDEXED ON MAP
3793

E Main St.

PAGE DAIRY CO

NO. MAIN ST,


BELLEVILLE

Dodson
Geolin

May 23, 1962

11

MAIN ST

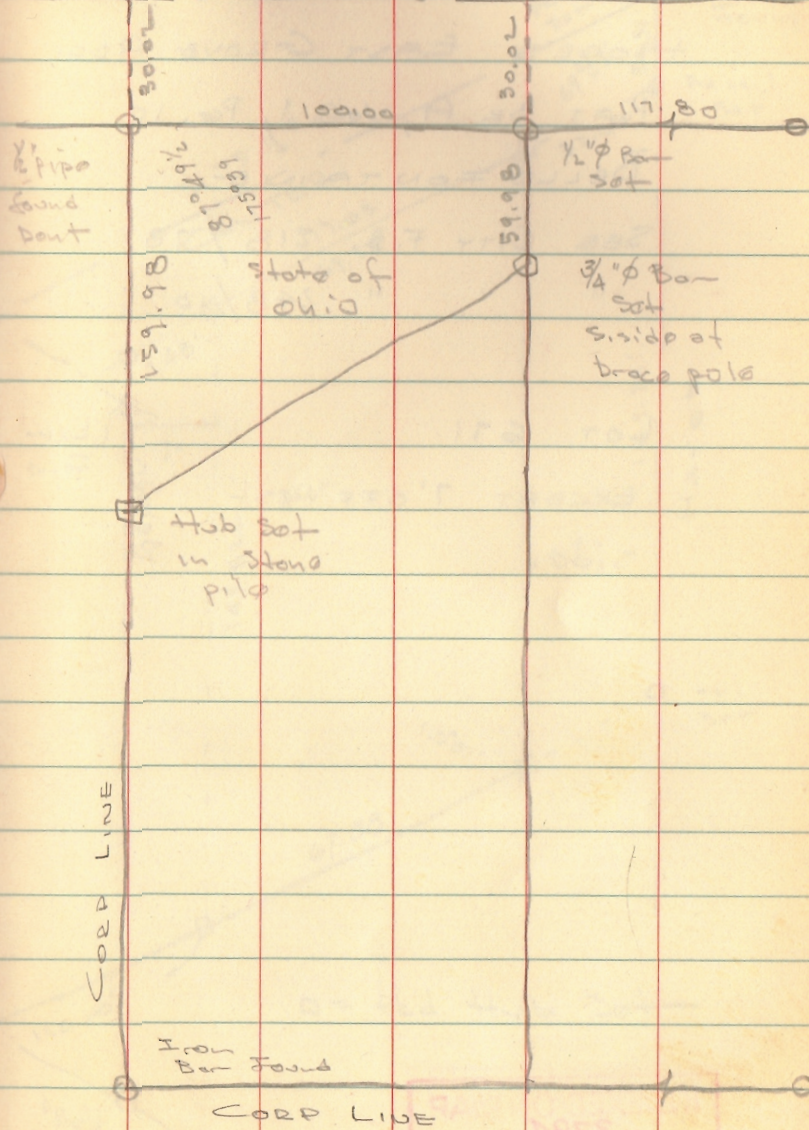

INDEXED ON MAP
3793