

Humble Description

March, 1965

Being situated in the City of Bellefontaine; and in V.M.S.  
#4990, Lake Township, Logan County, Ohio.

Beginning at a iron in the west right of way line of Green Street that bears N 19° - 00'W 100.0 feet from a iron at the intersection of the west right of way line of Green Street and the north right of way line of East Sandusky Avenue.

Thence S 69° - 50'W 60.5 feet to a iron.

Thence N 19° - 00'W 120.0 feet to a iron.

Thence S 69° - 50'W 6.0 feet to a iron.

Thence N 19° - 00'W 39.0 feet to a point in the creek, passing thru a iron at 20.0 feet.

Thence N 69° - 50'E 66.5 feet to a chisled cross on the bridge abutment.

Thence S 19° - 00'E 159.0 feet to the place of beginning.

Containing 0.23 of an acre more or less.

---


Owen K. Shirk  
Surveyor 4271

O. K. Shirk  
8/19/65  
D.E.C.

INDEXED ON MAP

3816

10

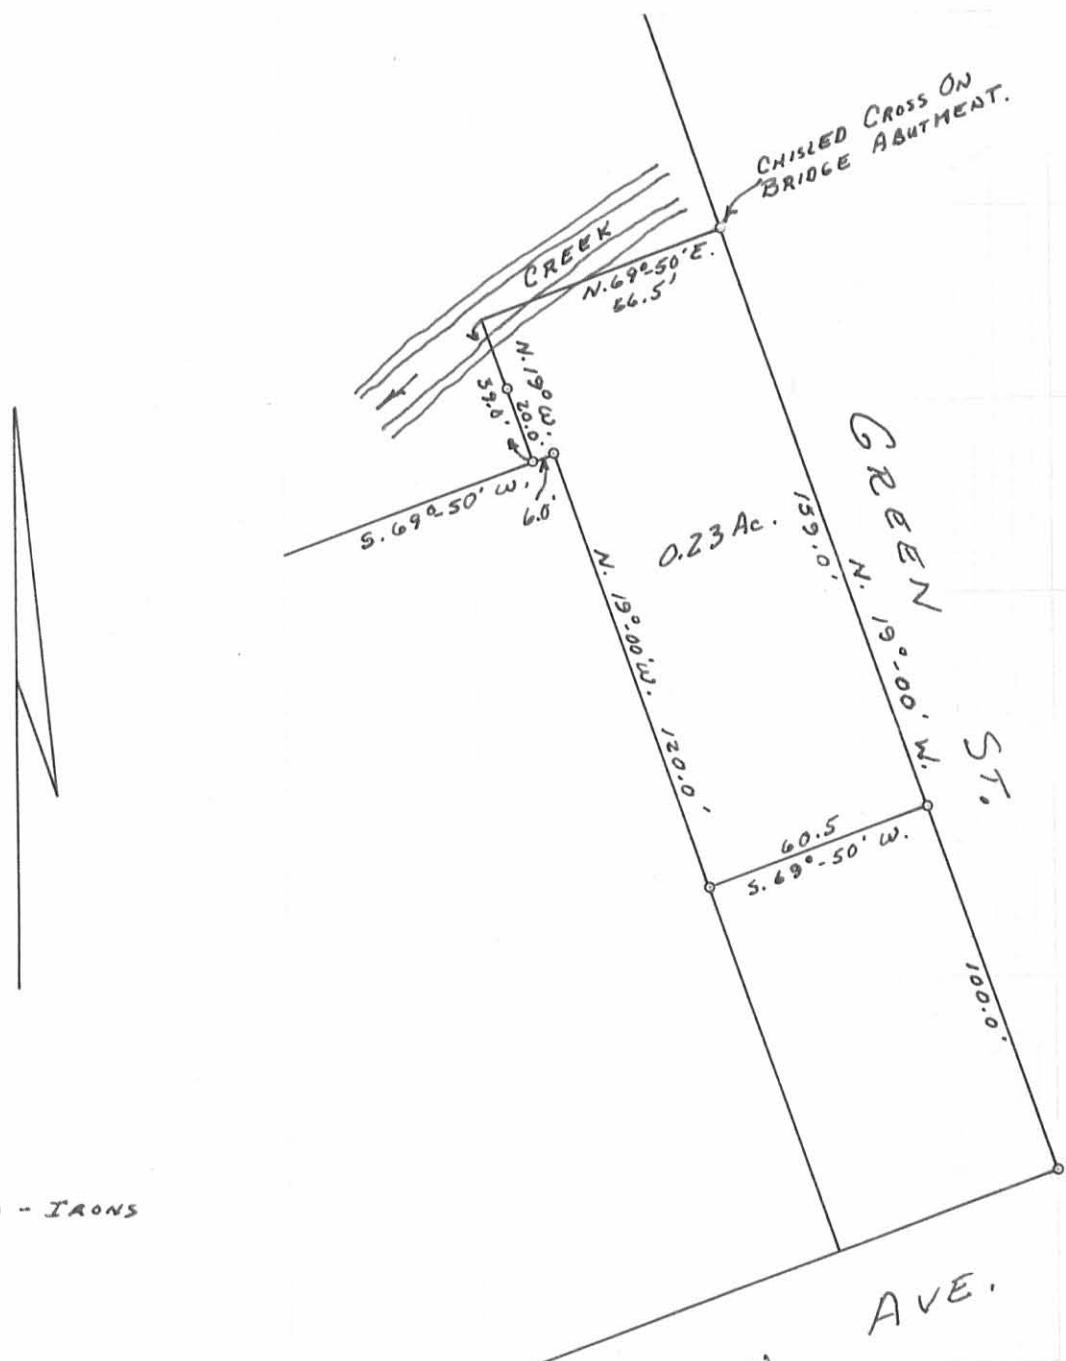

O - IRONS

HUMBLE SURVEY  
 V.M.S. 4990  
 CITY OF BELLEFONTAINE  
 LAKE TOWNSHIP  
 LOGAN COUNTY, OHIO  
 SURVEYED BY O.K. SHIRK #4271  
 MARCH 1965  
 SCALE 1" = 50'  
 3816  
 INDEXED ON MAP

DRAWN BY D.E.G.  
 8/20/65