

LOT 3858
 BELLE-AIR ESTATES
 BELLEFONTAINE, O.
 SEPT. 13, 1965
 SCALE 1"=50'

0 = 1/2" Bar Set

ON PLAT BOOK
 12-12-66
 DCC

4004 IP
 INDEXED ON MAP

Dan L. Dodson
 DODSON SURVEYS
 Dan L. Dodson
 Reg. Surveyor 4270
 Bellefontaine, Ohio

REFERENCE:
 Belle-Air Estates A
 Addition No. 2
 Plat Bk. D, Vol. 4, Pg. 12
 F.B. 14, Pg. 33

LOT 3858

BELLE AIR No. 2
BELLEFONTAINE, O.

- A = 1/2" ϕ Rebar Found
- B = 1/2" ϕ Bar Set
- C = 1/2" pipe Found
- D = 1/2" ϕ Bar Set
- E = " " "
- F = Old Hub Found - Set 1/2" ϕ Bar
- G = " " " N.W. Cor 3856
- H = 1/2" ϕ Bar Set
- J = 1/2" ϕ Bar Set
- K = 1/2" ϕ Bar Set


INDEXED ON MAP

4004

Dodson
Geoslin

Sept. 13, 1965

33

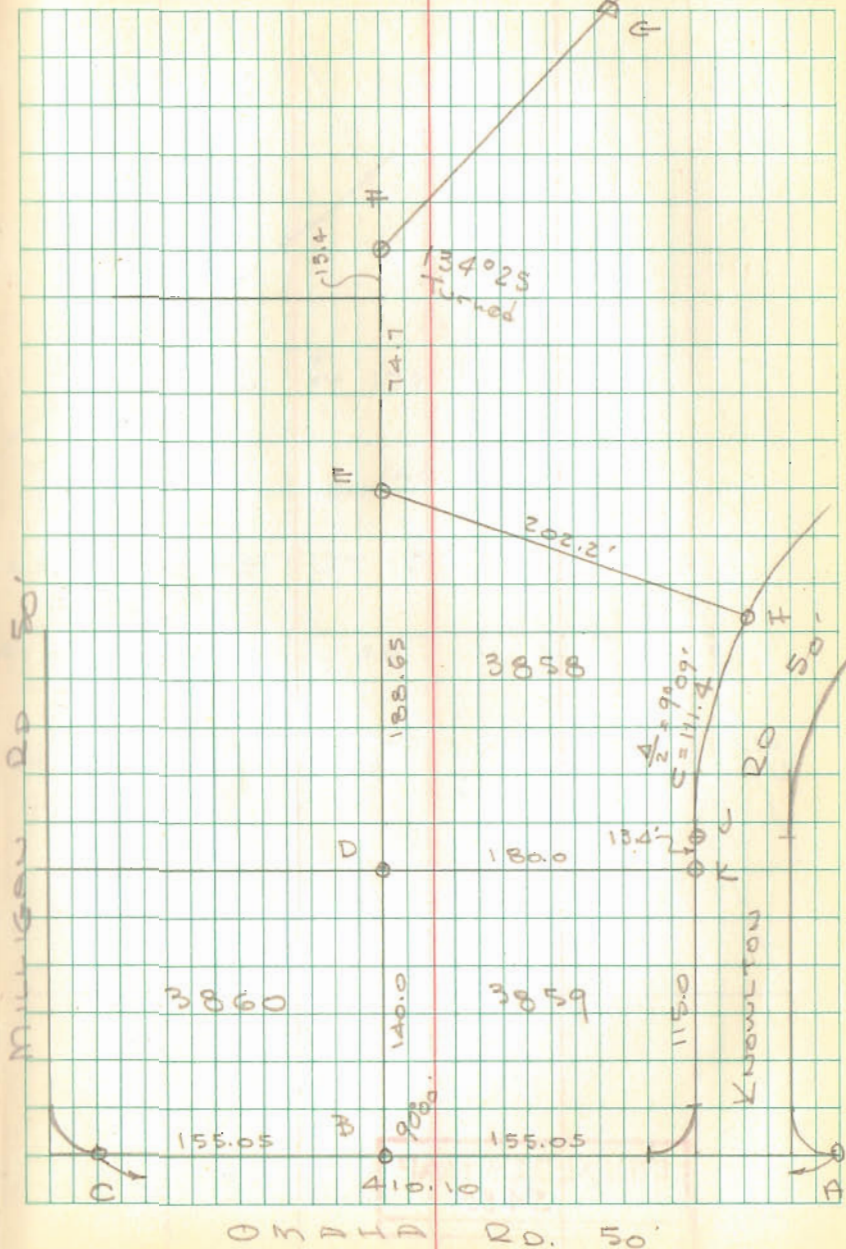

0 3 7 1 D RD. 50'