


LOT 780 - BELLEFONTAINE, OHIO
HARRISON TWP., - LOGAN CO.
SECTION 4; TOWN 3; RANGE 14

• Denotes irons

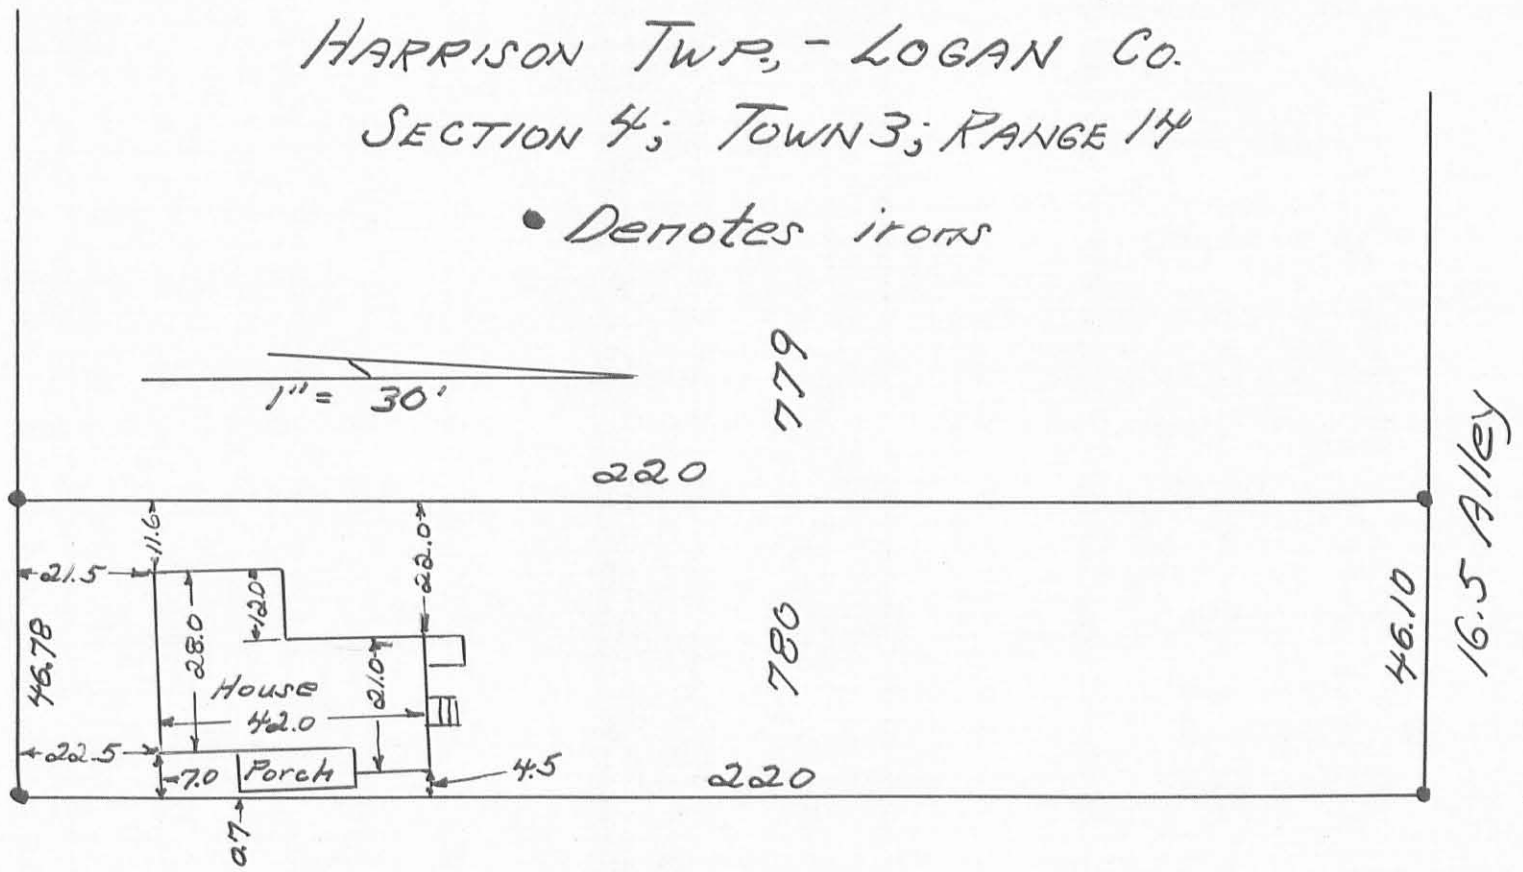

CHILICOTHE AVE. 60.0

ST. PARIS ST. 60.0

INDEXED ON MAP
4755 1P

¹⁸¹
Owen K. Shirk
OWEN K. SHIRK
SURVEYOR 4271