




ORGAN STREET - 50'

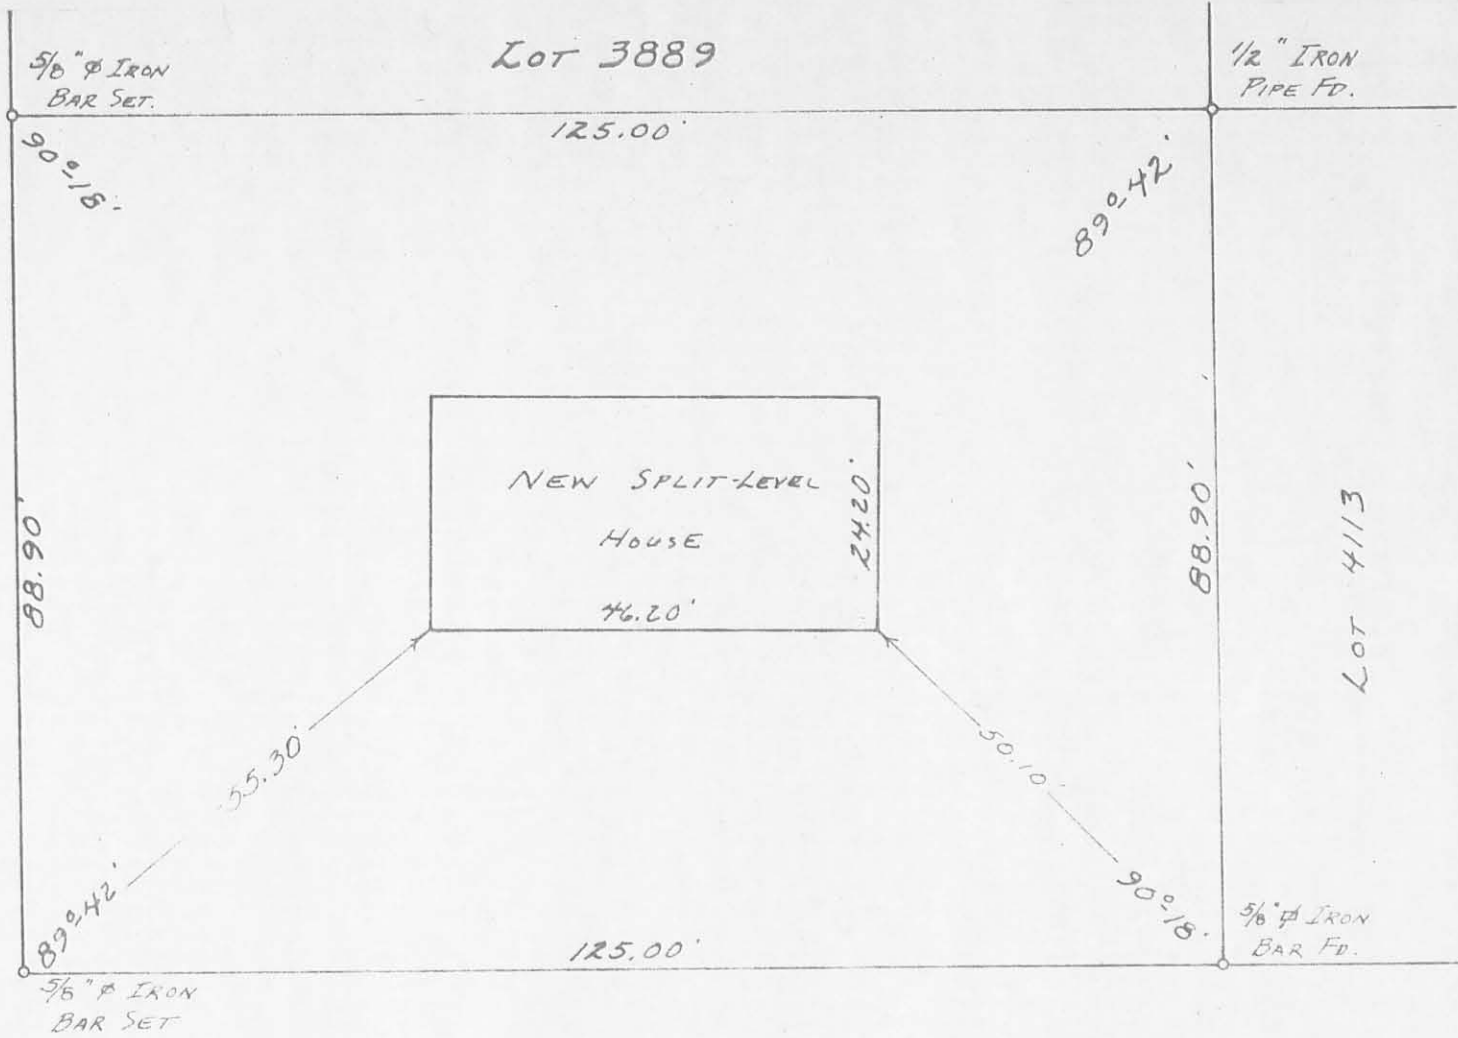

TERRENCE DRIVE - 50'

REFERENCE:
 HUMBLE ALLOT. No. 1.
 PLAT BOOK 4 VOL. D. PAGE 103.

SURVEY OF LOT 4106
 HUMBLE ALLOTMENT No. 1
 V.M.S. No. 4478
 CITY OF BELLEFONTAINE
 LAKE TOWNSHIP
 LOGAN COUNTY, OHIO
 APRIL 7, 1973

SURVEYED AND PLATTED BY:
 DANIEL E. GILBERT, P.S.
 REG. SUR. No. 5402
 1041 N. MAIN ST.
 BELLEFONTAINE, OHIO 43501



5378 IP

INDEXED ON MAP

SCALE: 1"=20'