


OPPY SURVEY: LOT 1065  
 525 COOPER; BELLEFONTAINE, O.

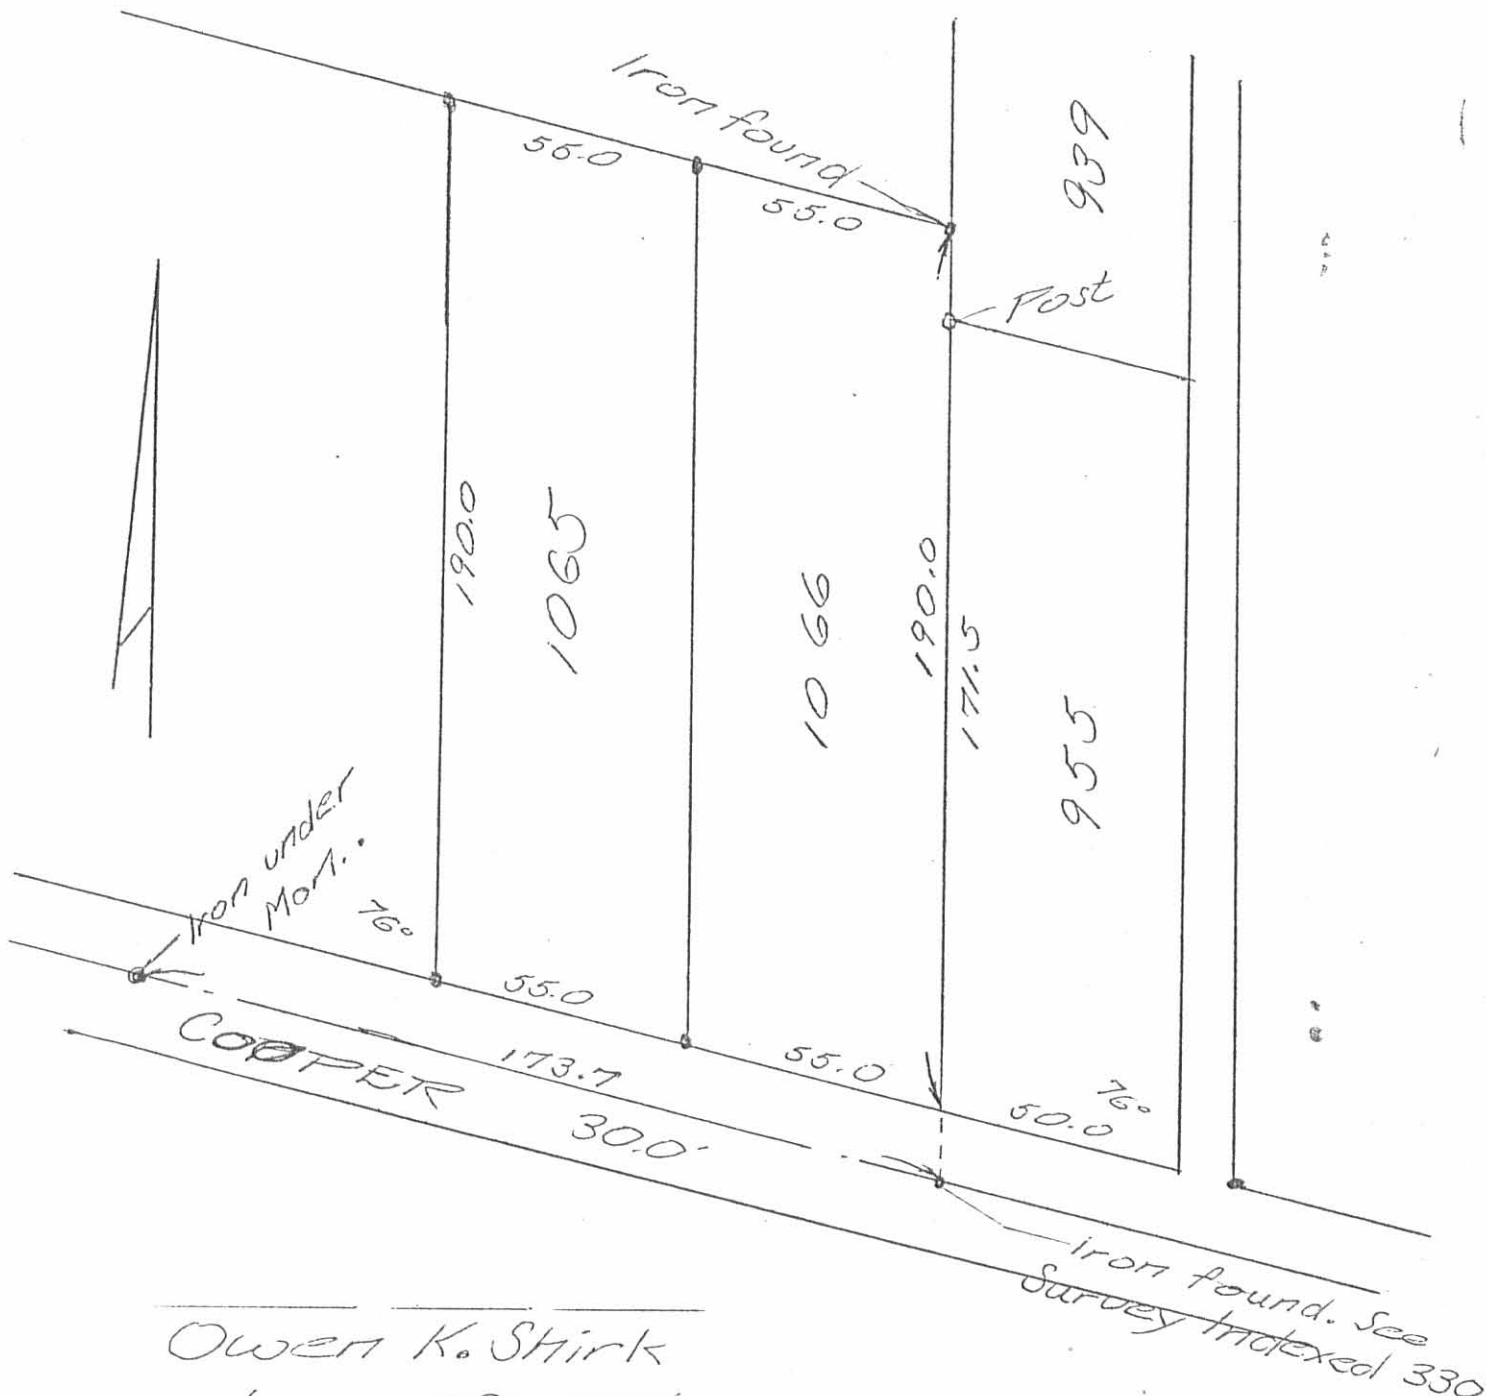

Owen K. Shirk  
 June 28, 1976  
 Surveyor 4271

6096 IP

INDEXED ON MAP