


LOTS 2424 & 2425  
 BELLEFONTAINE, OHIO

NOTES:

- (1) • Denotes irons
- (2) Contours are at a 2' interval.
- (3) † Denotes Utility Poles
- (4) Contours are copied from city maps.

MAIN STREET

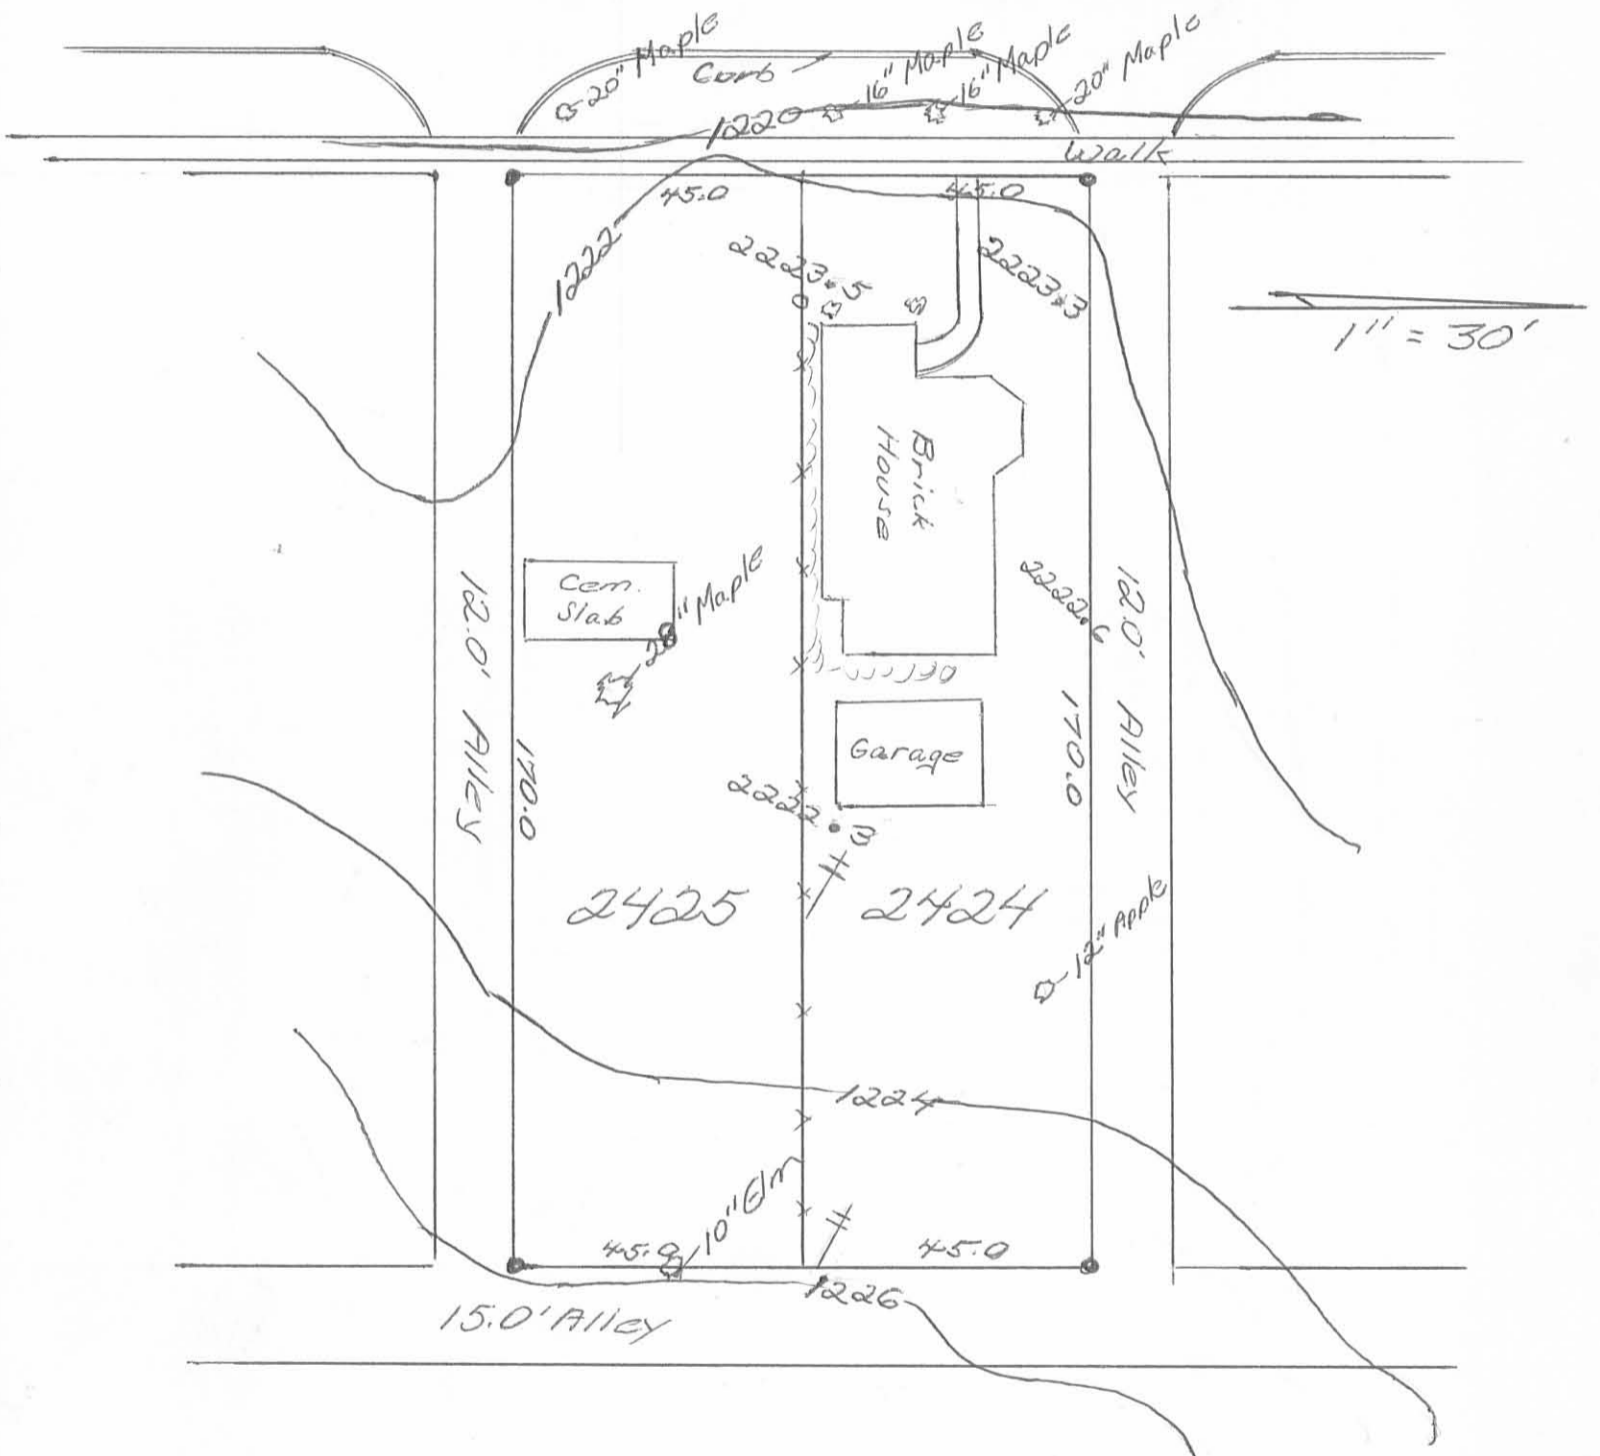

I hereby certify that the above plat represents a true survey of lots 2424 & 2425 of Tehran Addition as shown in Book A, Vol. 1, page 45 in the Logan Co. Records Office made by me.

IP  
 6103

Owen K. Shirk  
 Surveyor 4271  
 9-4-75

INDEXED ON MAP