


N

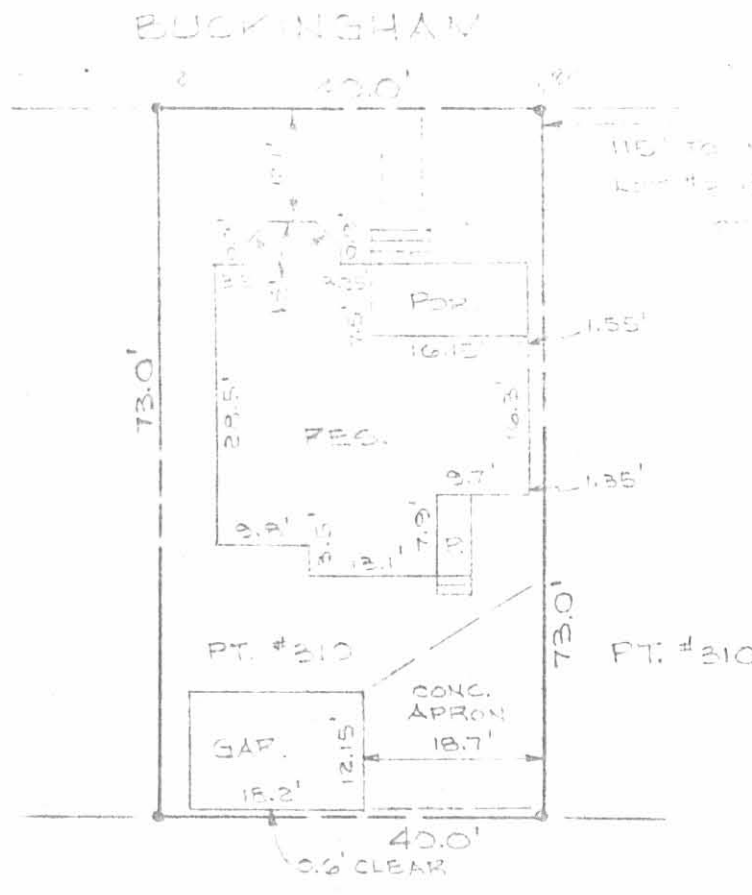

6187 IP

THIS PLOT PLAN IS CERTIFIED TO BE TRUE & ACCURATE.

REGISTERED

[Handwritten signature]

PLOT PLAN
 PART OF LOT #210
 202 BUCKINGHAM
 BELLEFONTAINE, OHIO
 APR 22 1979

FOR MORTGAGE
LOAN PURPOSES ONLY