



PCD 5 30-06 GMM DLK

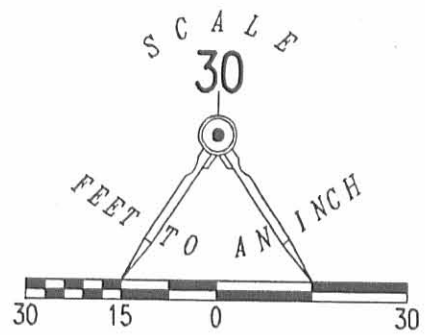

- LEGEND:
- 1 INCH IRON BAR FOUND IN A MONUMENT BOX
 - 5/8 INCH IRON ROD SET

RETRACEMENT SURVEY OF THE
 MATTHEW T. PICKERING
 LOTS 2406, 2407 AND 2408
 FAIRVIEW ADDITION
 PLAT CABINET A, SLIDE 45
 OFFICIAL RECORD 664, PAGE 307
 CITY OF BELLEFONTAINE
 LAKE TOWNSHIP
 LOGAN COUNTY, OHIO

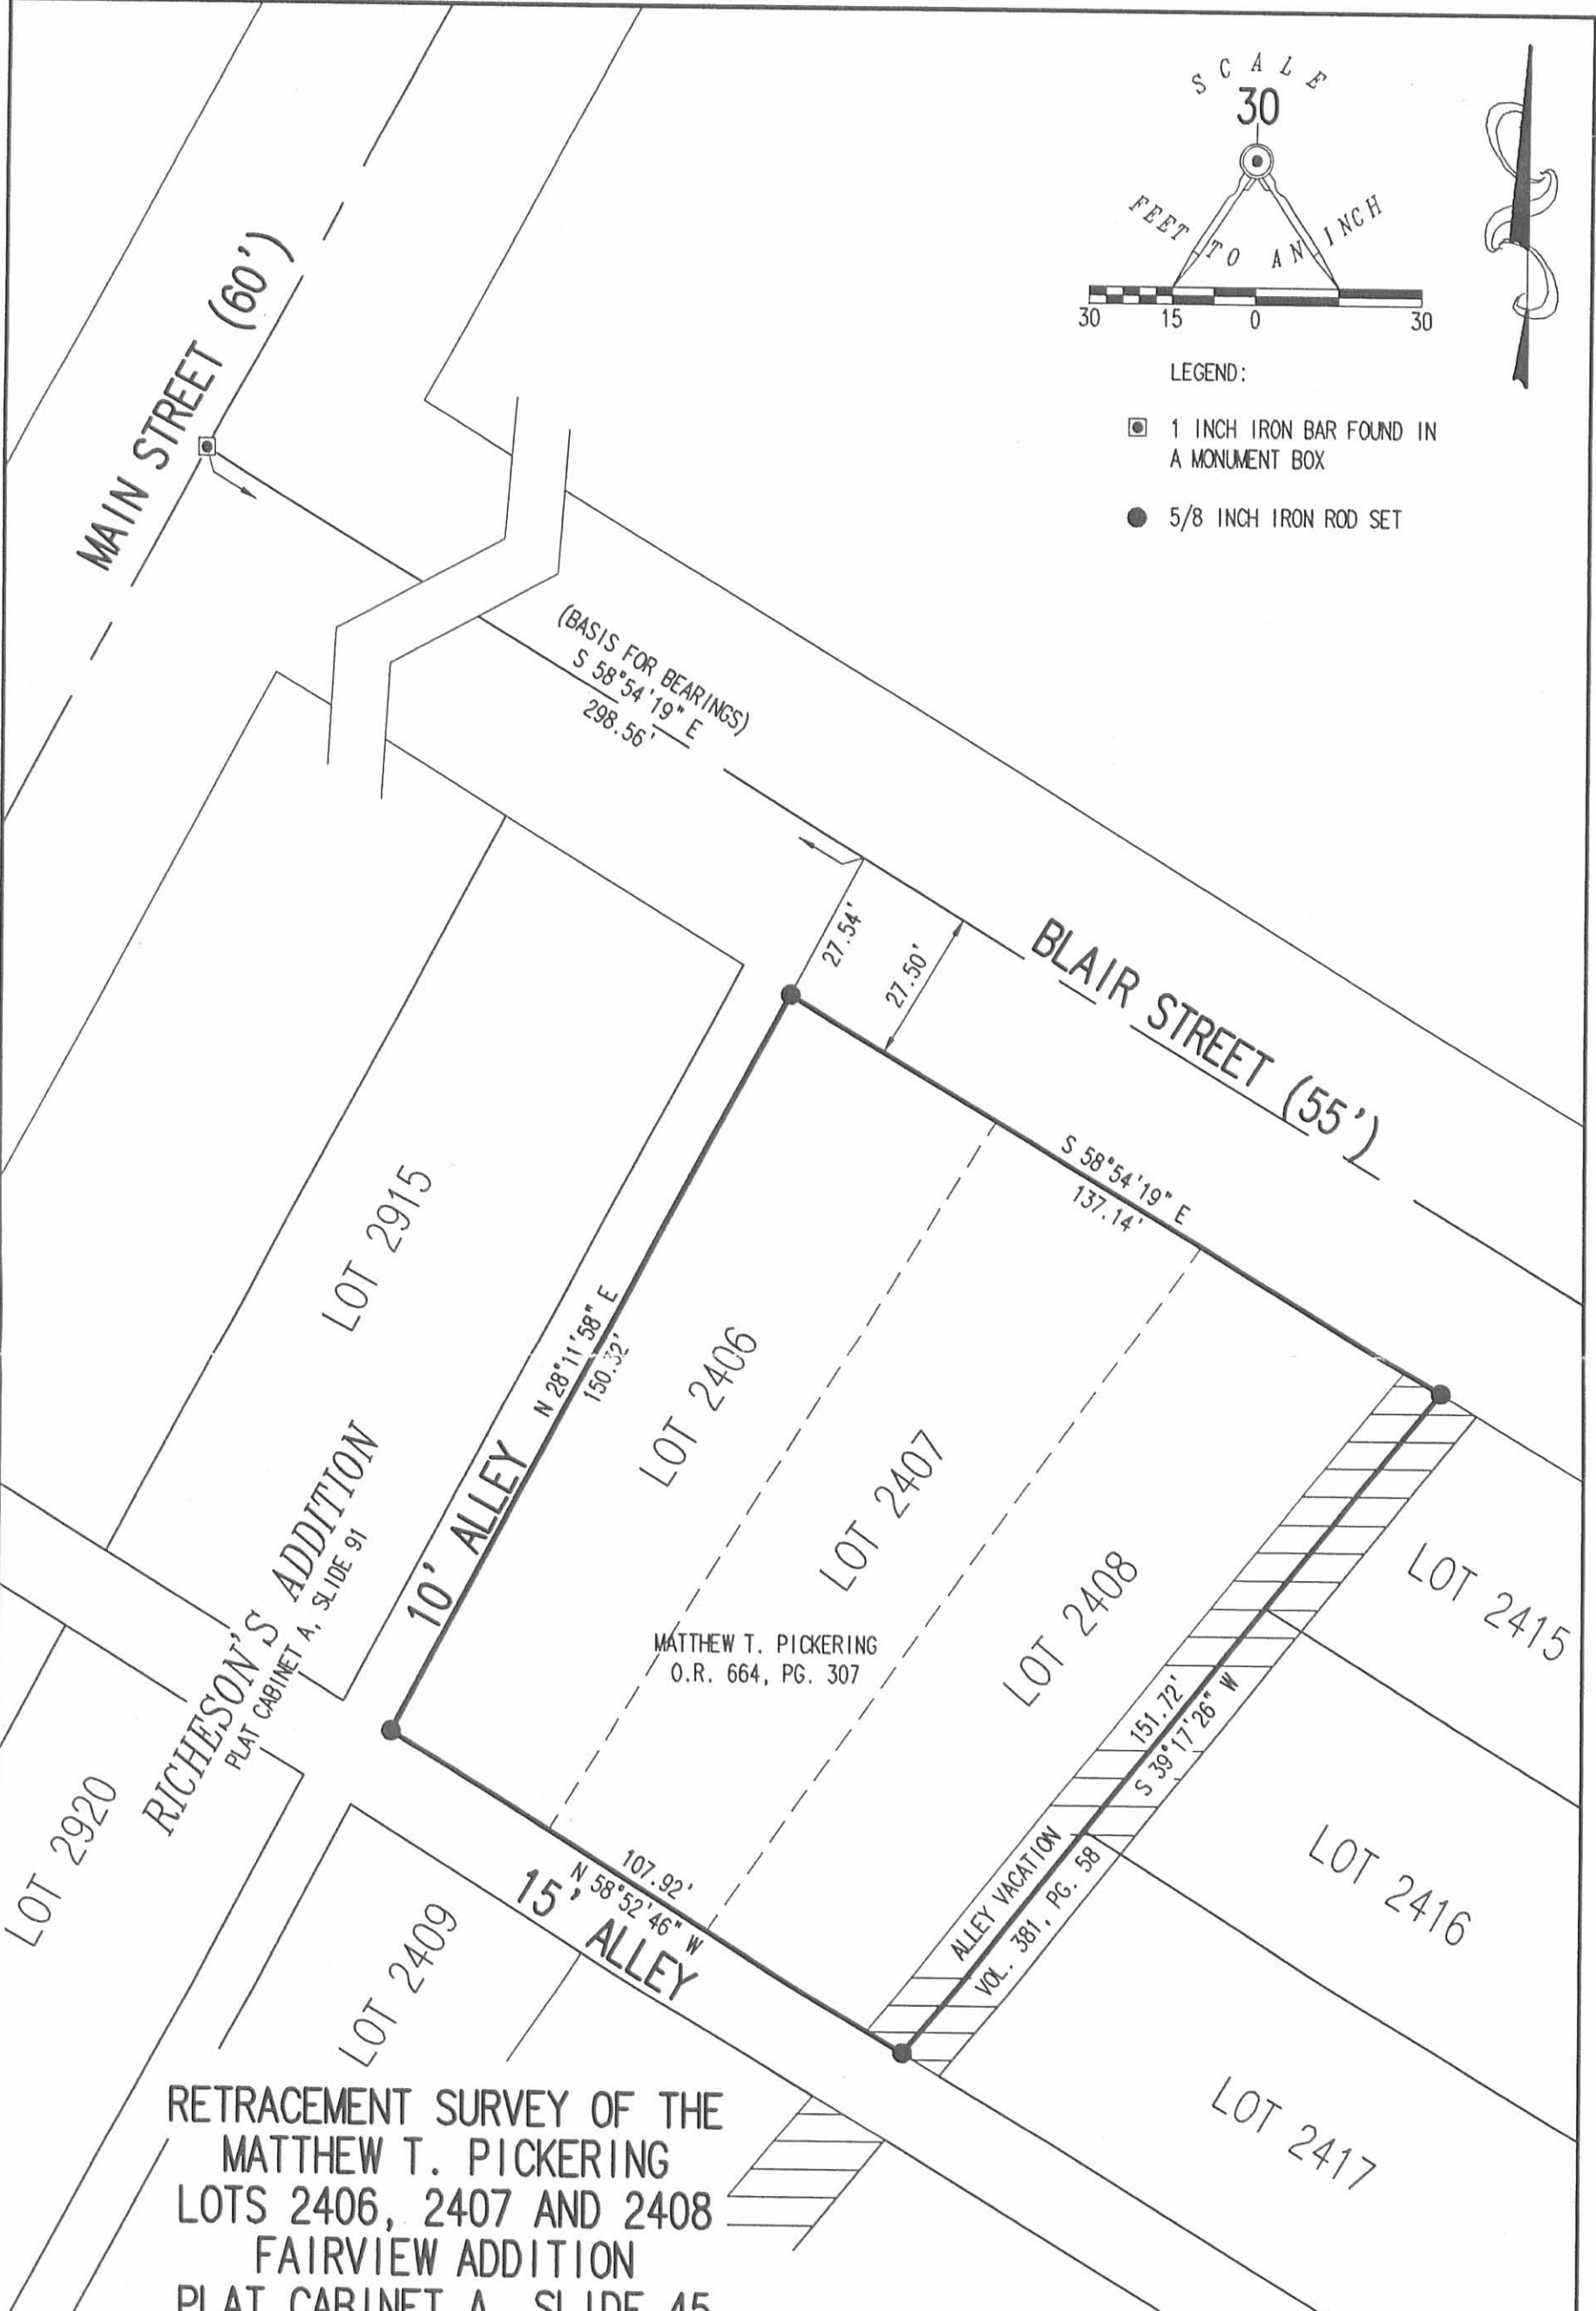

SURVEYED BY:

 JEFFREY I. LEE
 PROFESSIONAL SURVEYOR 6359
 MAY 26, 2006

COPYRIGHT 2006 BY:
 LEE SURVEYING & MAPPING CO., INC.
 117 North Madriver Street
 BELLEFONTAINE, OHIO 43311
 (937) 593-7335


2 WORKING DAYS
BEFORE YOU DIG
 CALL TOLL FREE 800-362-2764
 OHIO UTILITIES PROTECTION SERVICE.

INDEXED ON MAP
 0201 1P

KSR D0506 4253056 L-4253-3


Caldwell Survey

Bellefontaine

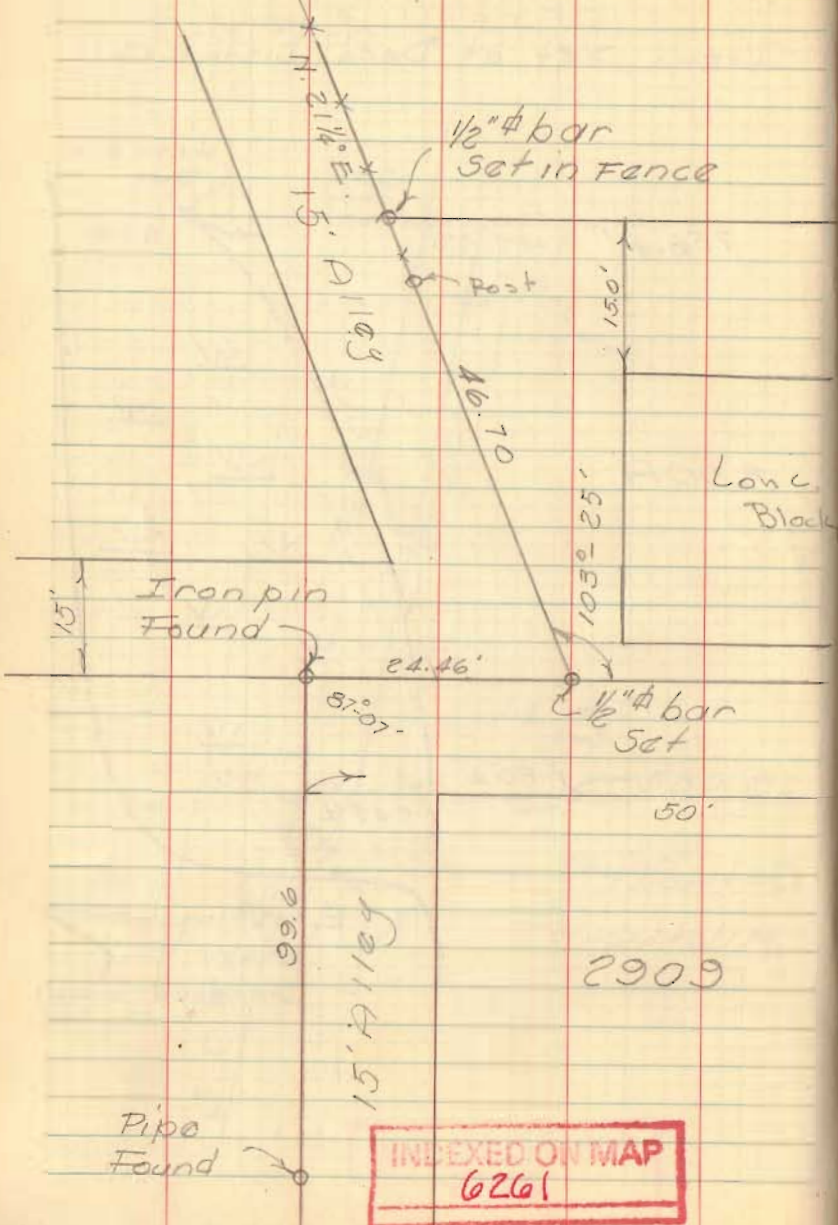

Dodson
Geoslin

Oct. 12, 1957 38

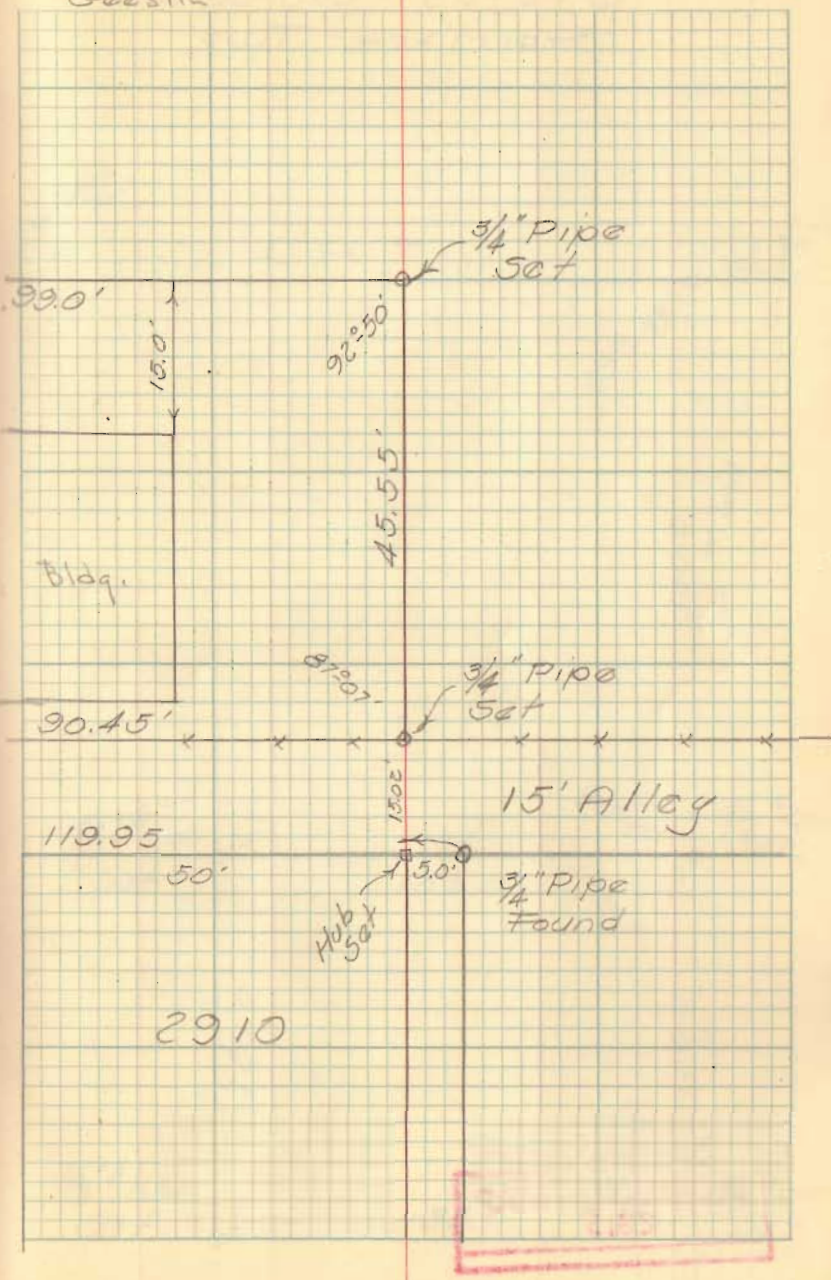


INDEXED ON MAP
6261

INDEXED ON MAP
6261

Caldwell Survey
Bellefontaine

Used fence for
line

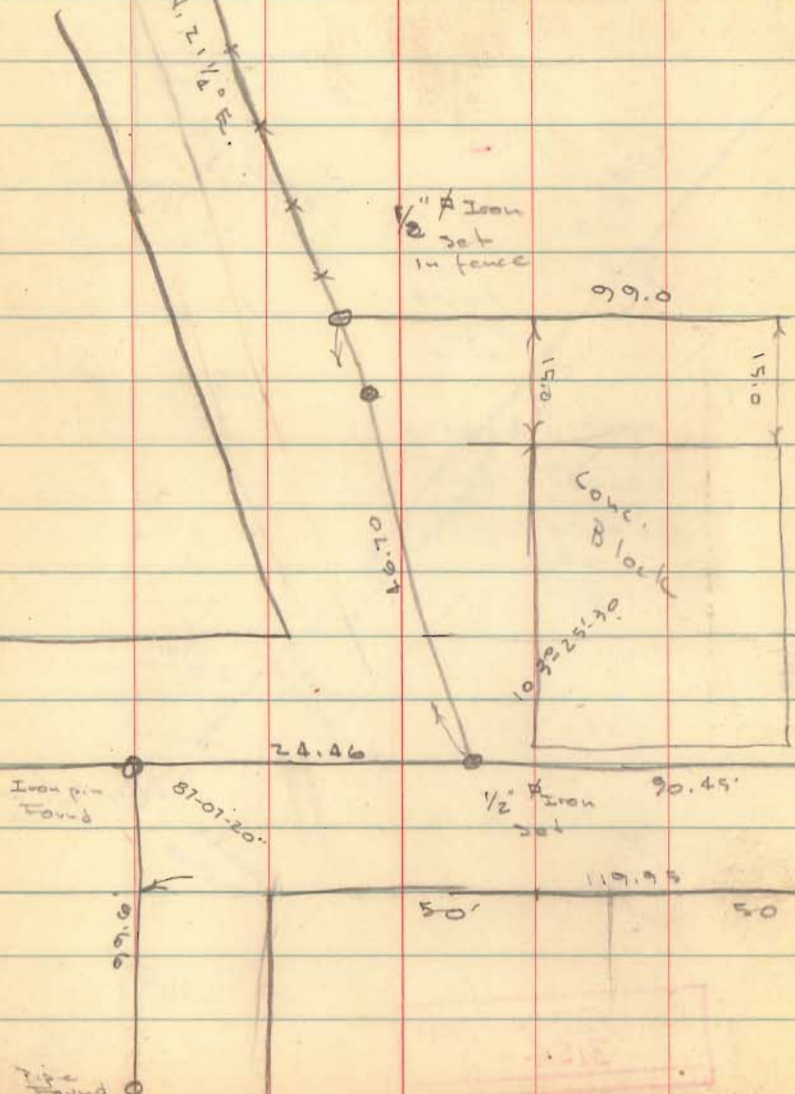


Dodson
Georgia

Oct. 12, 1997 25

0.10

Bk 3 pg 38

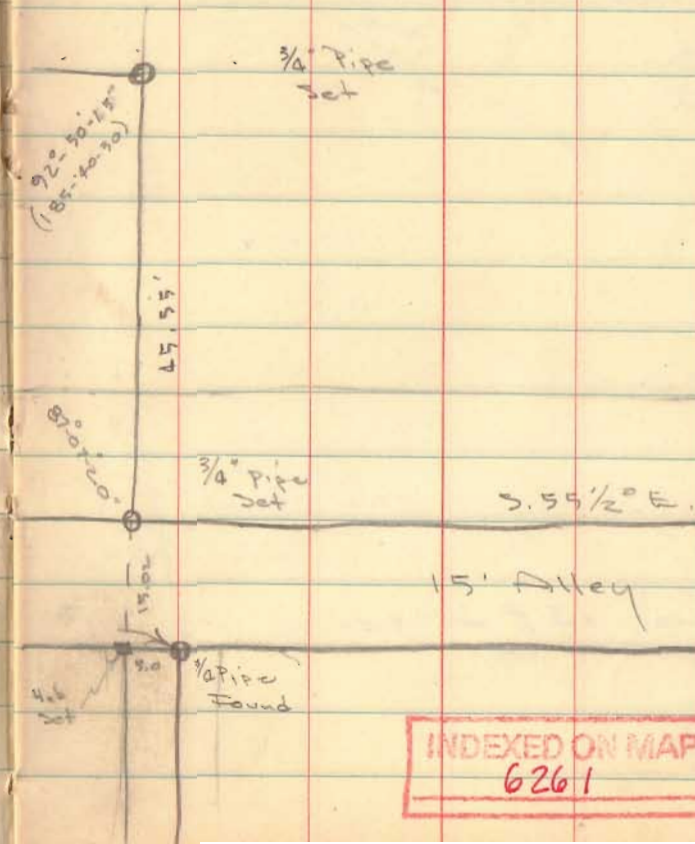

INDEXED ON MAP
6261