


JOHN RAUCH SURVEY  
320 E. CHILLICOTHE AVE, BELLEFONTAINE, OHIO

1" = 100'

• DENOTES IRONS

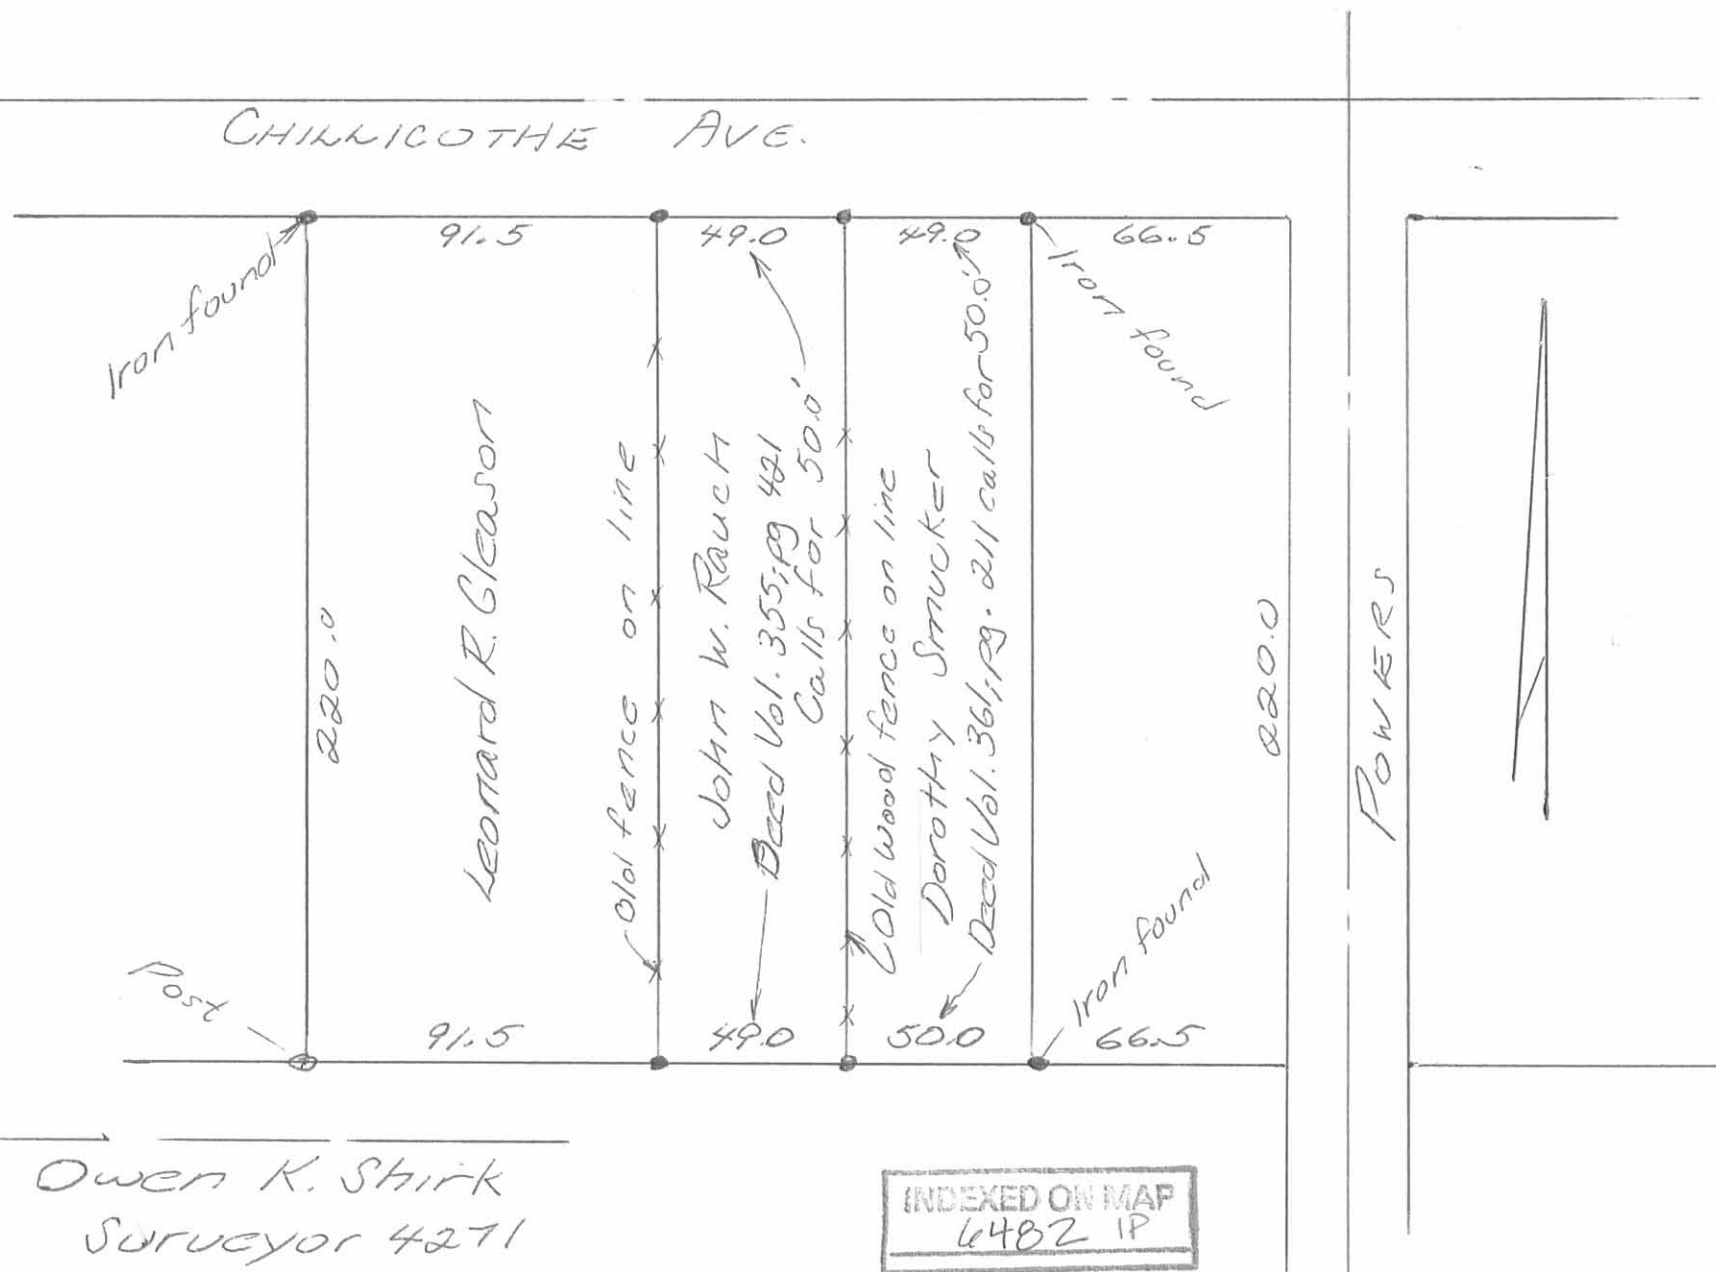

Owen K. Shirk  
Surveyor 4271  
4-2-76

INDEXED ON MAP  
6482 IP

OK Shirk No. 5


Pg. 28

Dec. 27, 57

28

748	749	750	751	752	753	754	755	756	757
50	50	50	50	50	50	54	50	50	50

CHILKICOTHE

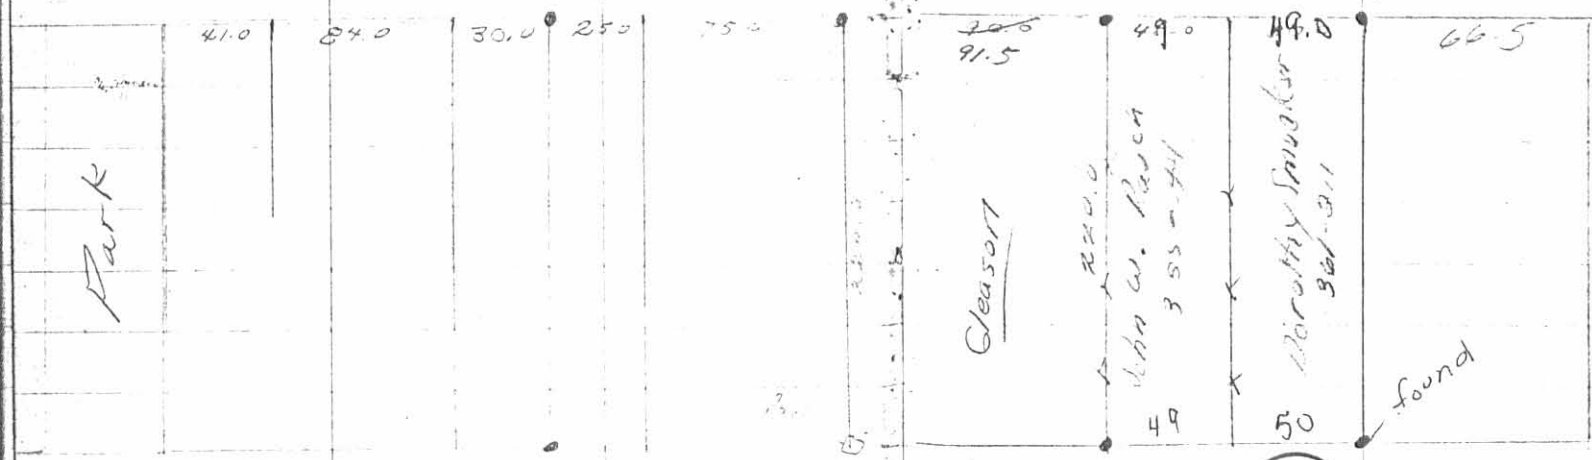

6482 2P  
INDEXED ON MAP