

N

LOTS 2627-2630

IRON PIPE FD.

G. PARKER KENNEDY
0.631 AC.
CHORD - 120.10'

● - 5/8" IRON BARS SET.

15' ALLEY

2668

2667

2666

2665

2664

VACATED ALLEY

IRON PIPE FD.

IRON BAR FD.

IRON BAR FD.

IRON PIPE FD.

IRON BAR FD.

← TO MAIN ST

15' ALLEY

RICHARD AVE.

40'



SURVEY OF LOTS 2666-2668
CITY OF BELLEFONTAINE
LAKE TOWNSHIP
LOGAN COUNTY, OHIO
SCALE: 1" = 40'

6725 IP

INDEXED ON MAP

SURVEYED AND PLATED BY:
DANIEL E. GILBERT, P.S.
REG. SUR. No. 5402
1041 N. MAIN ST.
BELLEFONTAINE, OHIO 43311

APRIL 17, 1982

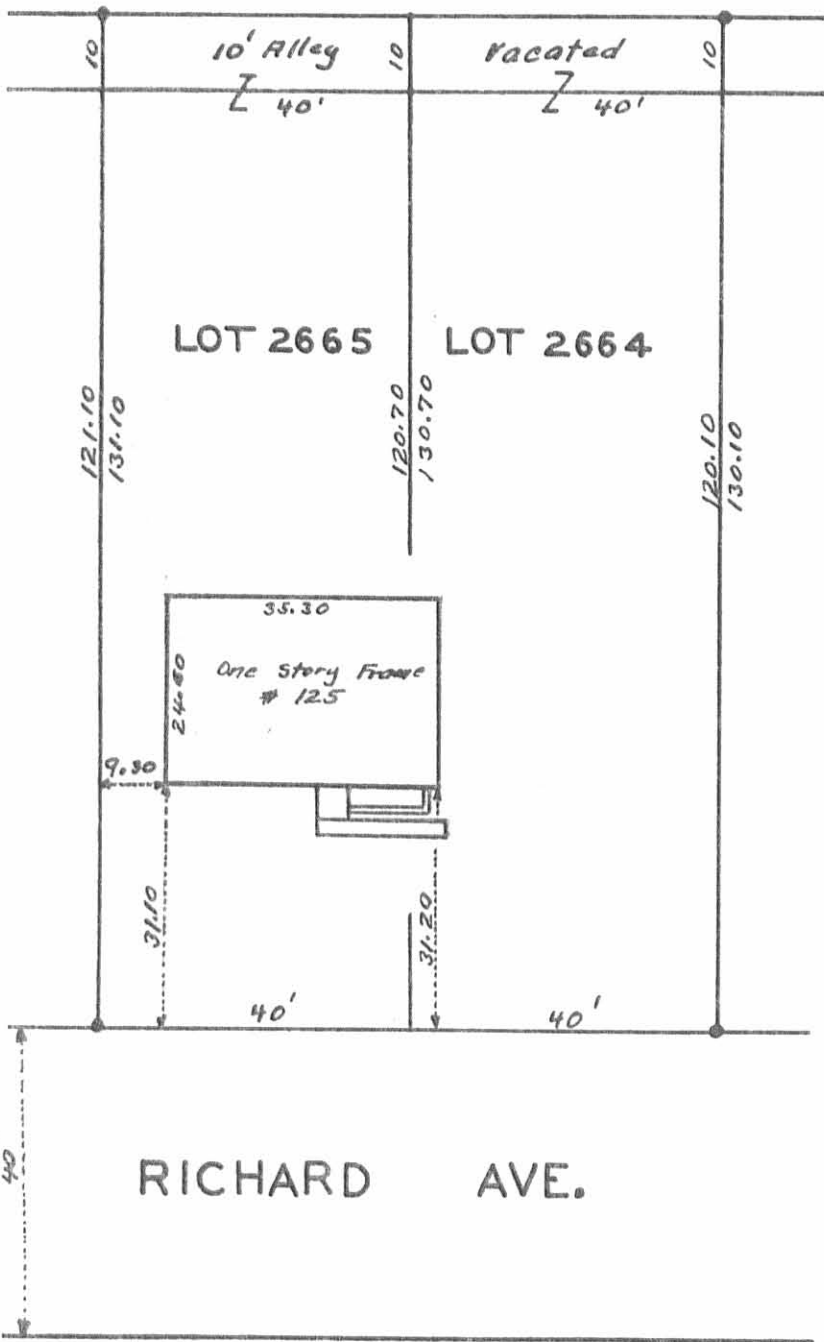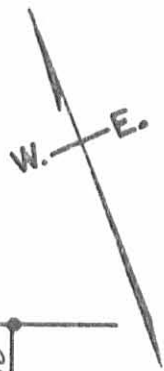

● Indicates Irons

I find no encroachments on Lots
2664 - 2665 August 6 1954

Foster F. Wright



Field Book 290

6725 2P

INDEXED ON MAP

RICHARD AVE.

ELMORE SURVEY
 LOTS 2664-2665
 IRON CITY HEIGHTS ADDITION
 BELLEFONTAINE OHIO
 AUGUST 1954 1" = 25'
 FOSTER F. WRIGHT