



Alley between
Detroit & Elm
Bellefontaine

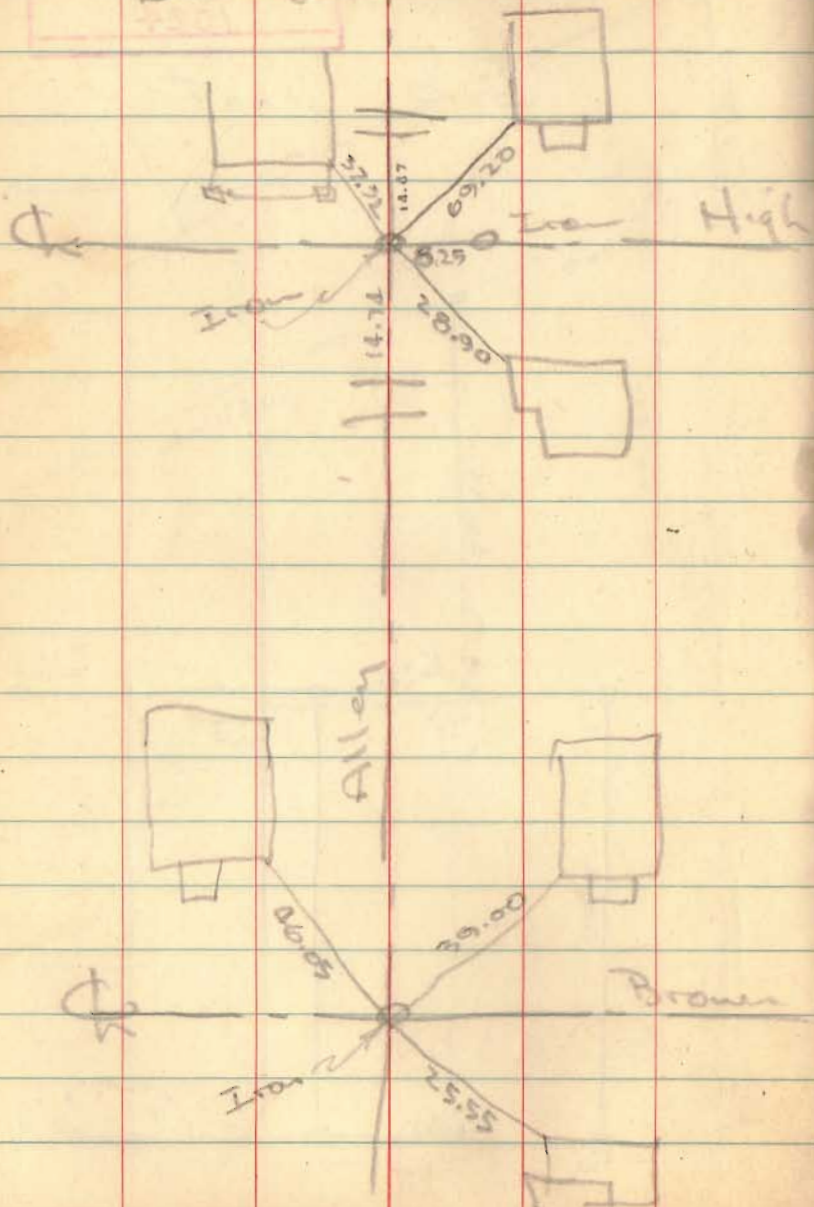

Luther Hurley Survey
W. High St. Bellefontaine

4551.15
188
233.17

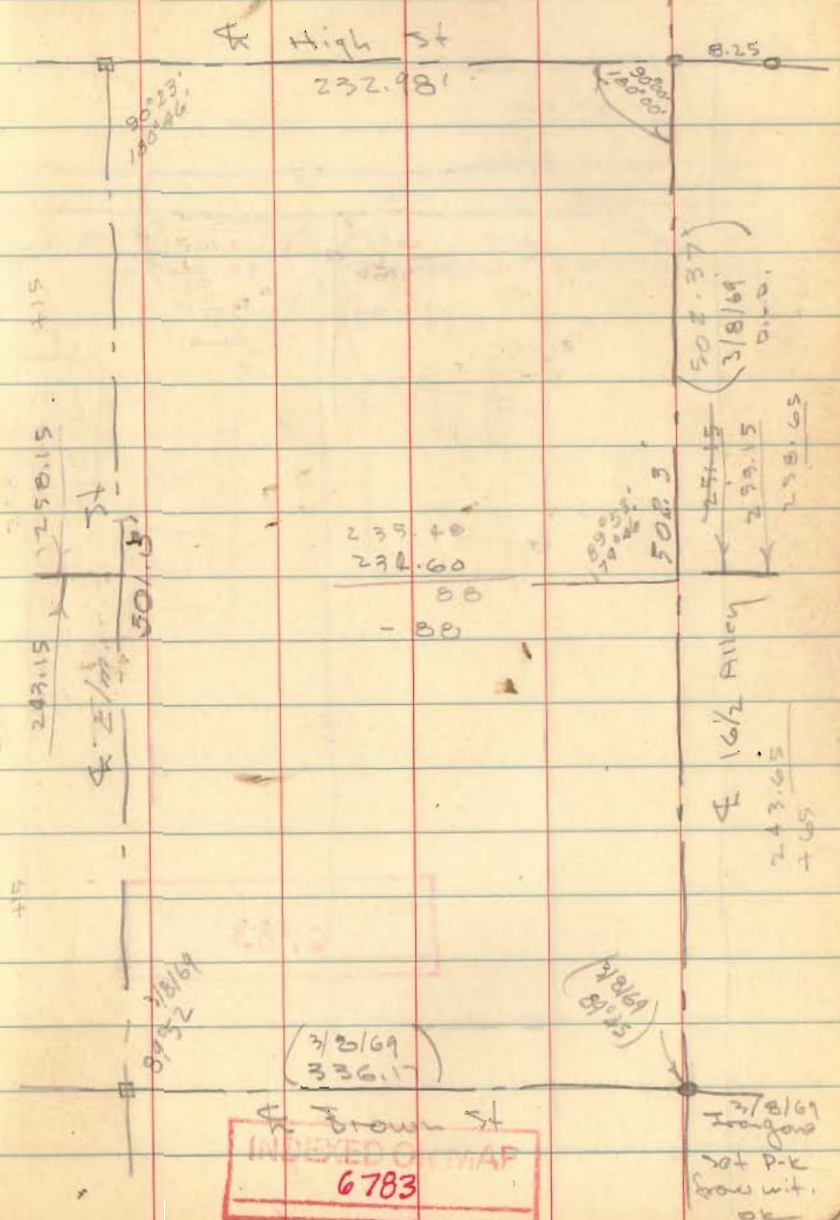

INDEXED ON MAP
6783

3/8/69
Set P-K
row with
OK

Hurley Survey (cont'd)

$\square = \frac{1}{8}'' \#$ Iron set

Sept. 22, 1956

Josiah Goodin 46

