

REFERENCE

CITY ENG. F.B. No.	184	Pg.	85
" " " "	187	Pg.	107
INSKEEP F.B. No.	8	Pg.	37
COUNTY ENG. FILE No.	1816		
DEED RECORD		Pg.	
343		81	
367		775	
322		350	
364		751	
330		633	
373		85	
78		11	

JOHNSON SURVEY
 PART OF LOT NO. 24 OF MATTHEW WHITES
 SUBDIVISION OF V.M.S. 4990
 BELLEFONTAINE, OHIO
 MAY 6, 1978
 SCALE 1" = 20'

DAN L. DODSON
 REG. SURVEYOR 4270
 BELLEFONTAINE, OHIO

JOHNSON SURVEY
E. SANDUSKY AVE

GREEN

- A = Iron Bar Found - City Mon - Lurolow Line
- B = 1" ϕ Bar Found
- C = Stone Found - $\frac{3}{4}$ " pipe 0.5' north
- D = $\frac{1}{2}$ " pipe Found
- E = $\frac{1}{2}$ " pipe Found
- F = $\frac{5}{8}$ " ϕ Bar Set - $\frac{3}{4}$ " pipe 0.53' North
- G = $\frac{5}{8}$ " ϕ Bar Set
- H = 1' Pipe Found 0.25 E. of line "I-G"
- I = $\frac{5}{8}$ " ϕ Bar Set
- J = $\frac{5}{8}$ " ϕ Bar Set
- K = Iron Bar Found - City Mon - E Green St.

$\frac{1}{2}$ " pipe @ "D" should be 0.26' EAST
 1" ϕ @ "A" should be 0.45' WEST

PROJECTED LINE "B-D" EAST & SET F & G

See City Eng. F.R. 184 pg. 85
 " " " " 187 pg. 107
 DRAWER R - 1816
 INSET BE 8 pg. 37

INDEXED ON MAP
7010

4/29/78

Dodson


McCurdy

5/6/78

Dodson

McCurdy

49

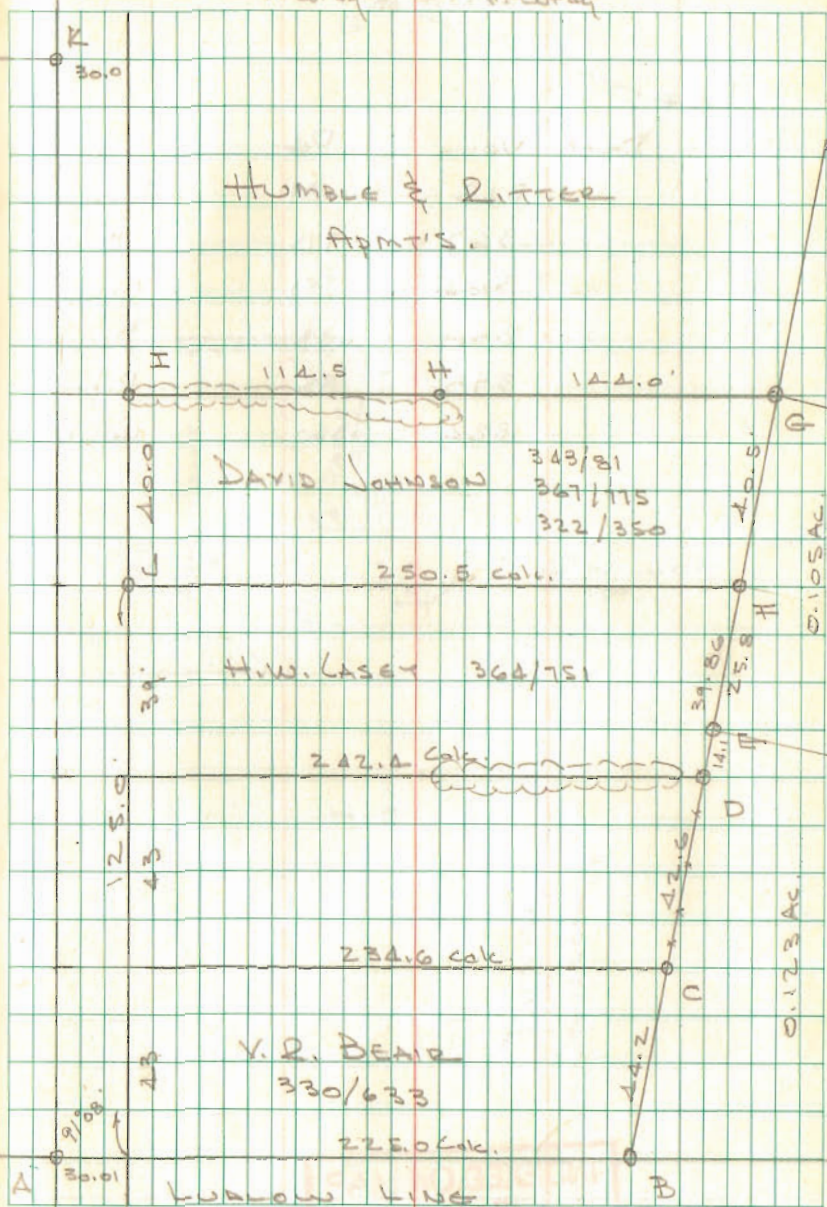

JOHNSON SURVEY
CONT'D.

REF:

DEED	VOL	PG.	
	343	81	Johnson
	367	75	"
	364	75)	Losey
	330	633	Beair
	373	85	Ritter
	322	350	Humble

INDEXED ON MAP
7010

5/6/78

50

