


RUSH STREET (74')

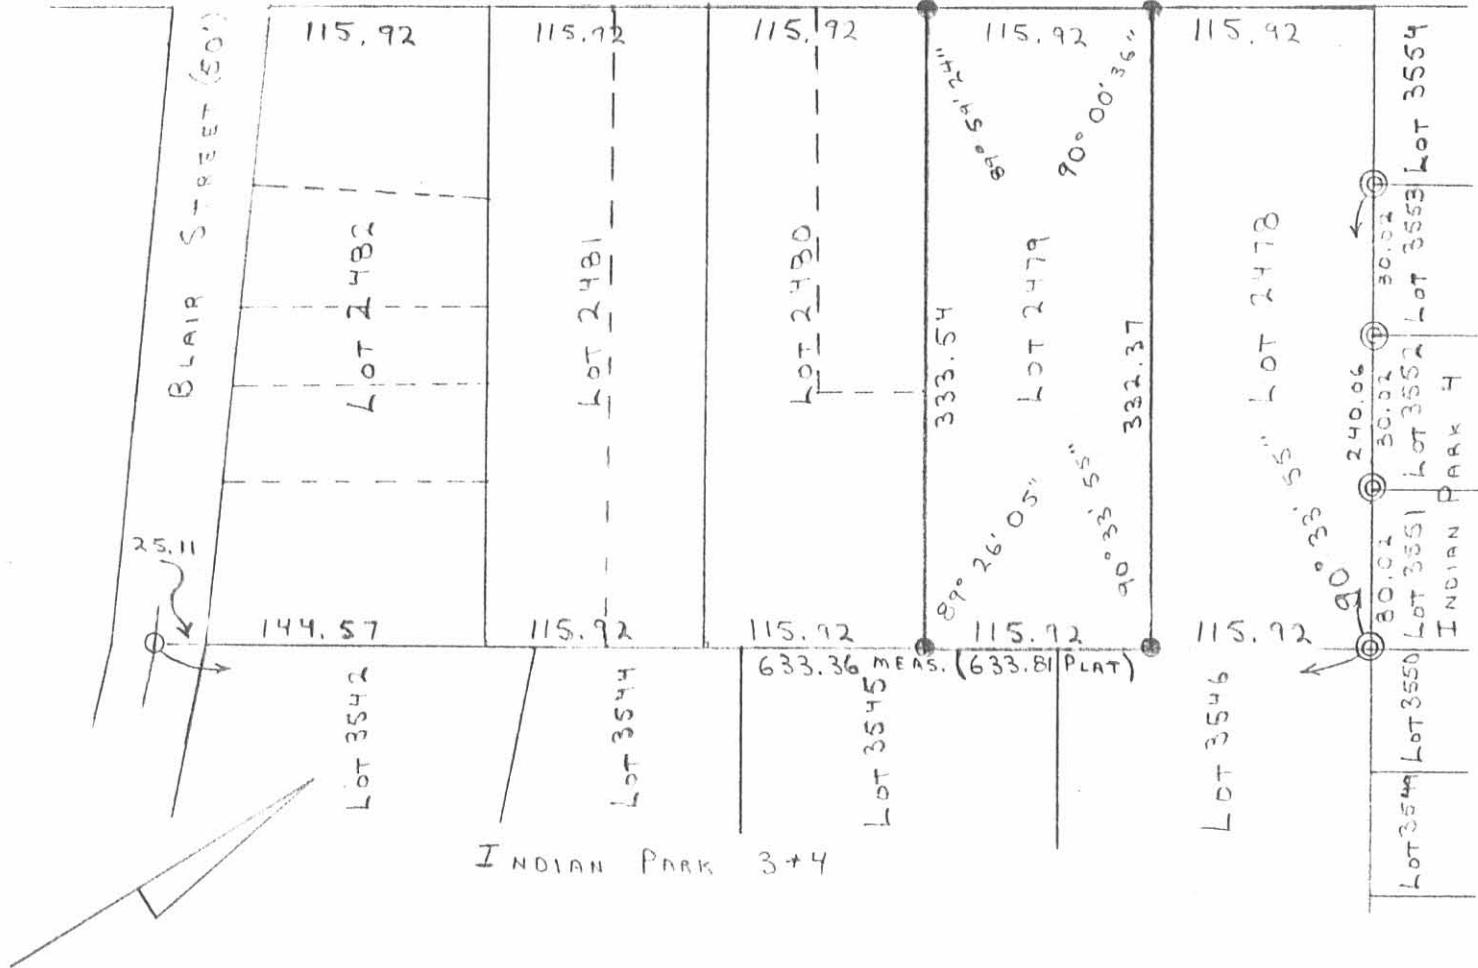

SCALE: 1" = 100'

LEGEND:

○ = 1" IRON BAR FO.  
(AXLE)

◎ = IRON PIPE FO.

● = 5/8" BAR SET

SURVEY OF LOT 2477 IN HAMILTON ALLOTMENT,  
BELLEFONTAINE, LAKE TWP., LOGAN CO., OHIO  
FOR MARVIN ROCKHOLD. AUGUST 1988



INDEXED ON MAP  
7847 IP

*Leslie H. Geeslin*  
LESLIE H. GEESLIN  
RUSHSVLVANIA, OHIO