




Map Room

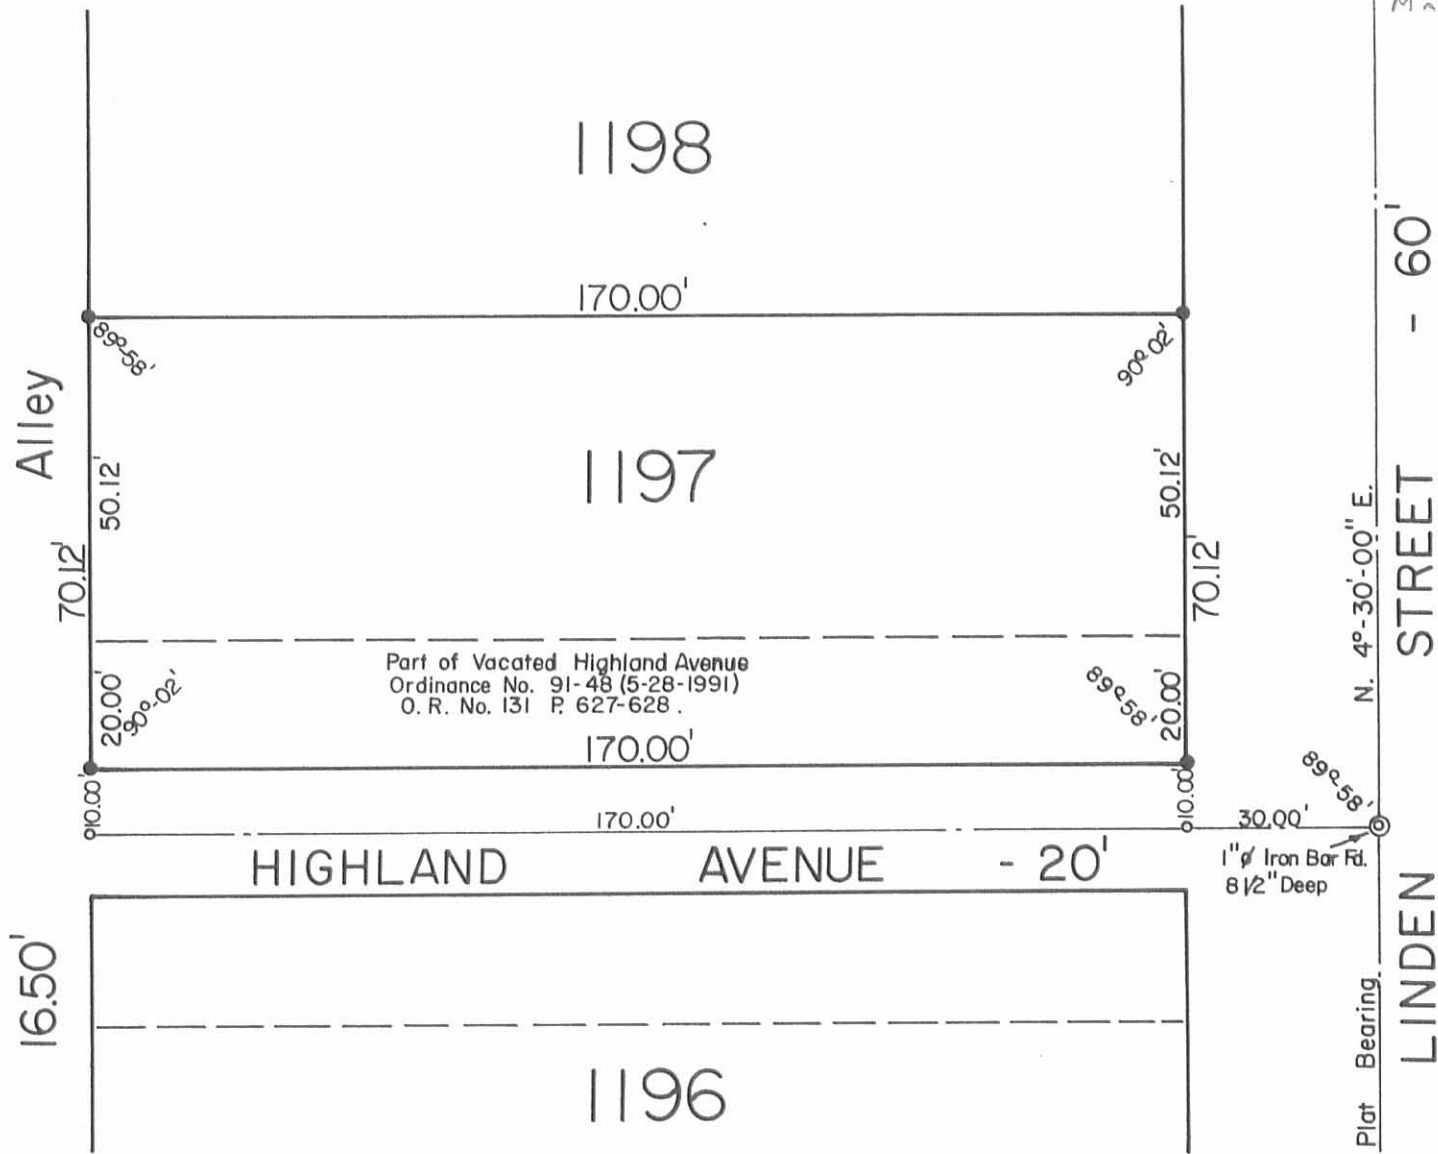

SYMBOLS:

- - P. K. Nails Set.
- - 5/8" x 30" Rebars Set.


Daniel E. Gilbert

Daniel E. Gilbert, P.S.
 Reg. Sur. No. 5402
 400 N. Park St.
 Bellefontaine, Ohio 43311



INDEXED ON MAP
 8366 1P

Survey of Lot No. 1197
 City of Bellefontaine
 Lake Township
 Logan County, Ohio
 September 27, 1991

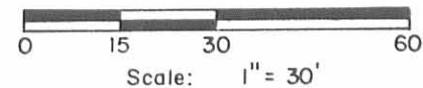

091-046