


RECEIVED 8-5-94 S.W.Y. DL

15' Alley

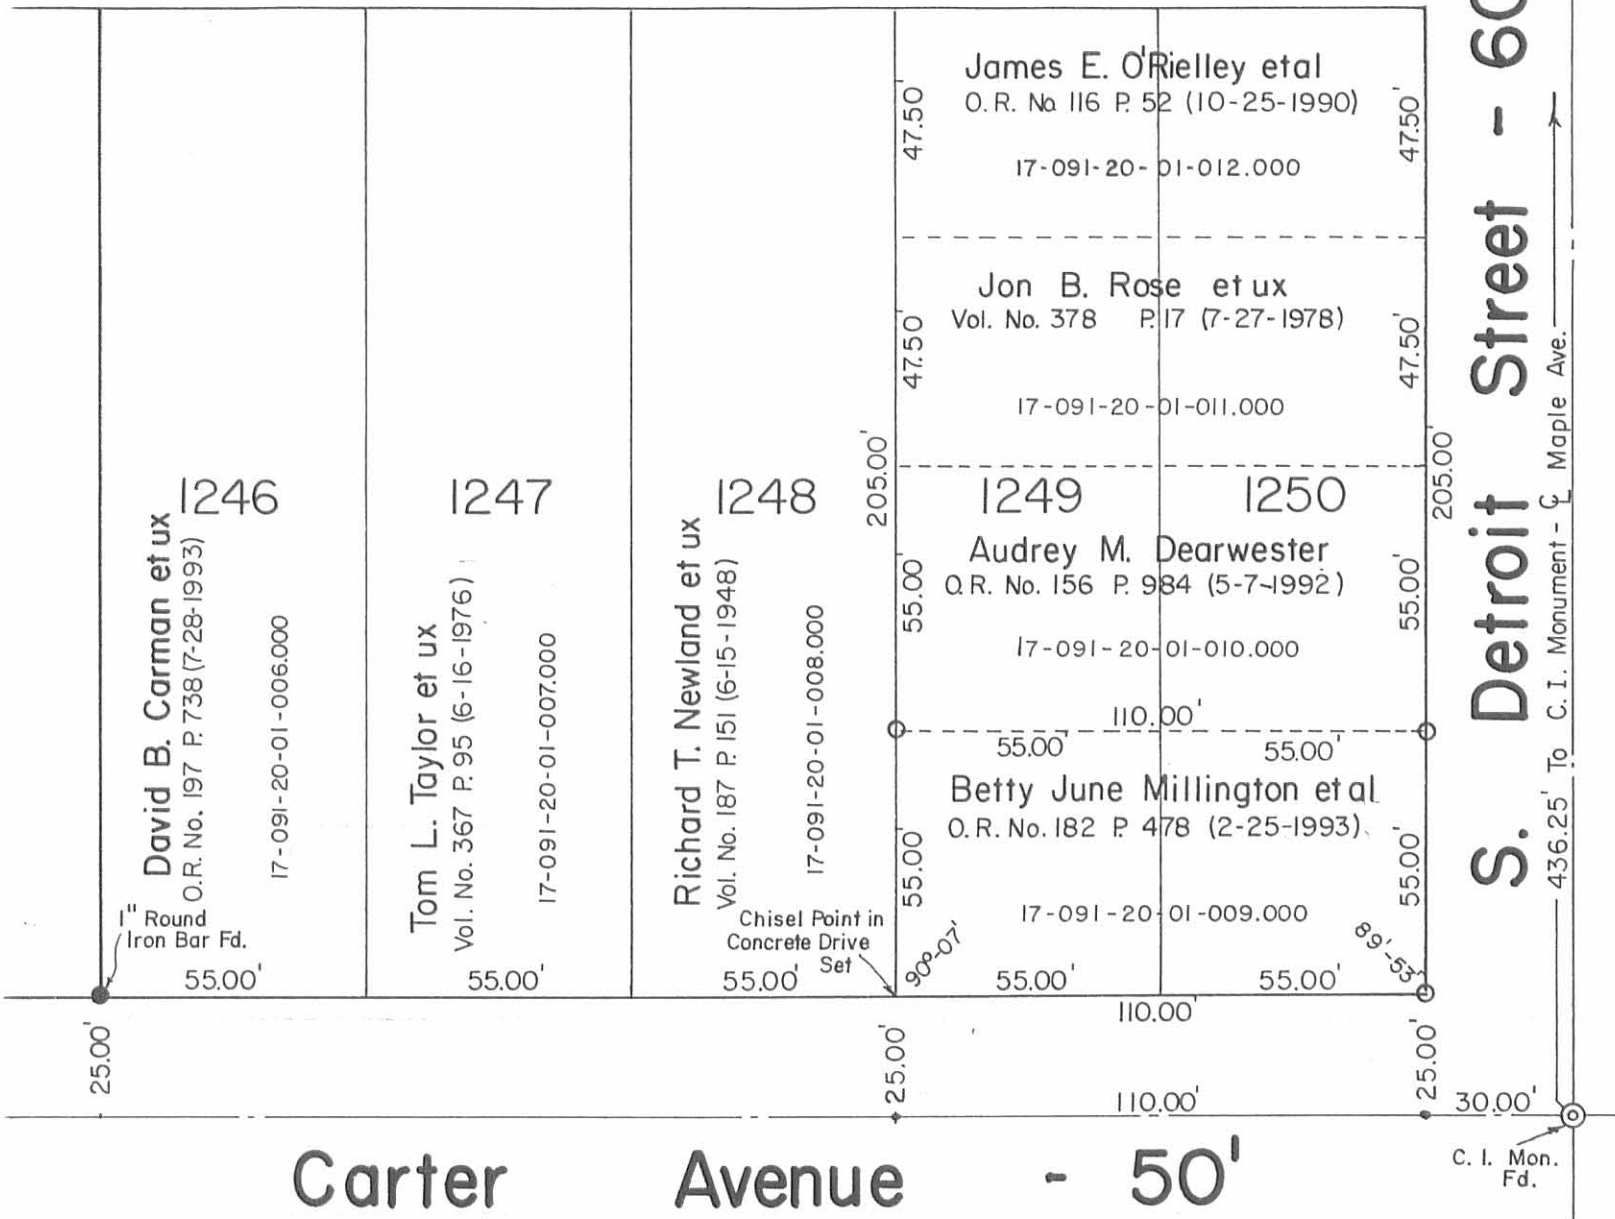

Reference:

CARTER SOUTH ADDITION.  
Plat Cabinet A, Slide 19.



*Daniel E. Gilbert*  
 DANIEL E. GILBERT, P.S.  
 REG. SUR. NO. 5402  
 400 N. PARK ST.  
 BELLEFONTAINE, OHIO 43311  
 TELEPHONE: 1 (513) 593-1428

INDEXED ON MAP  
 2938 IP

SYMBOLS:

- - P.K. Nails Set.
- - 5/8" x 30" Rebars Set.

MILLINGTON SURVEY  
 Lots No. 1249 Pt.-1250 Pt.  
 City of Bellefontaine  
 Lake Township  
 Logan County, Ohio  
 August 3, 1994



Scale: 1" = 40'