


REC'D 4-1-96 SMY OK

MAP ROOM

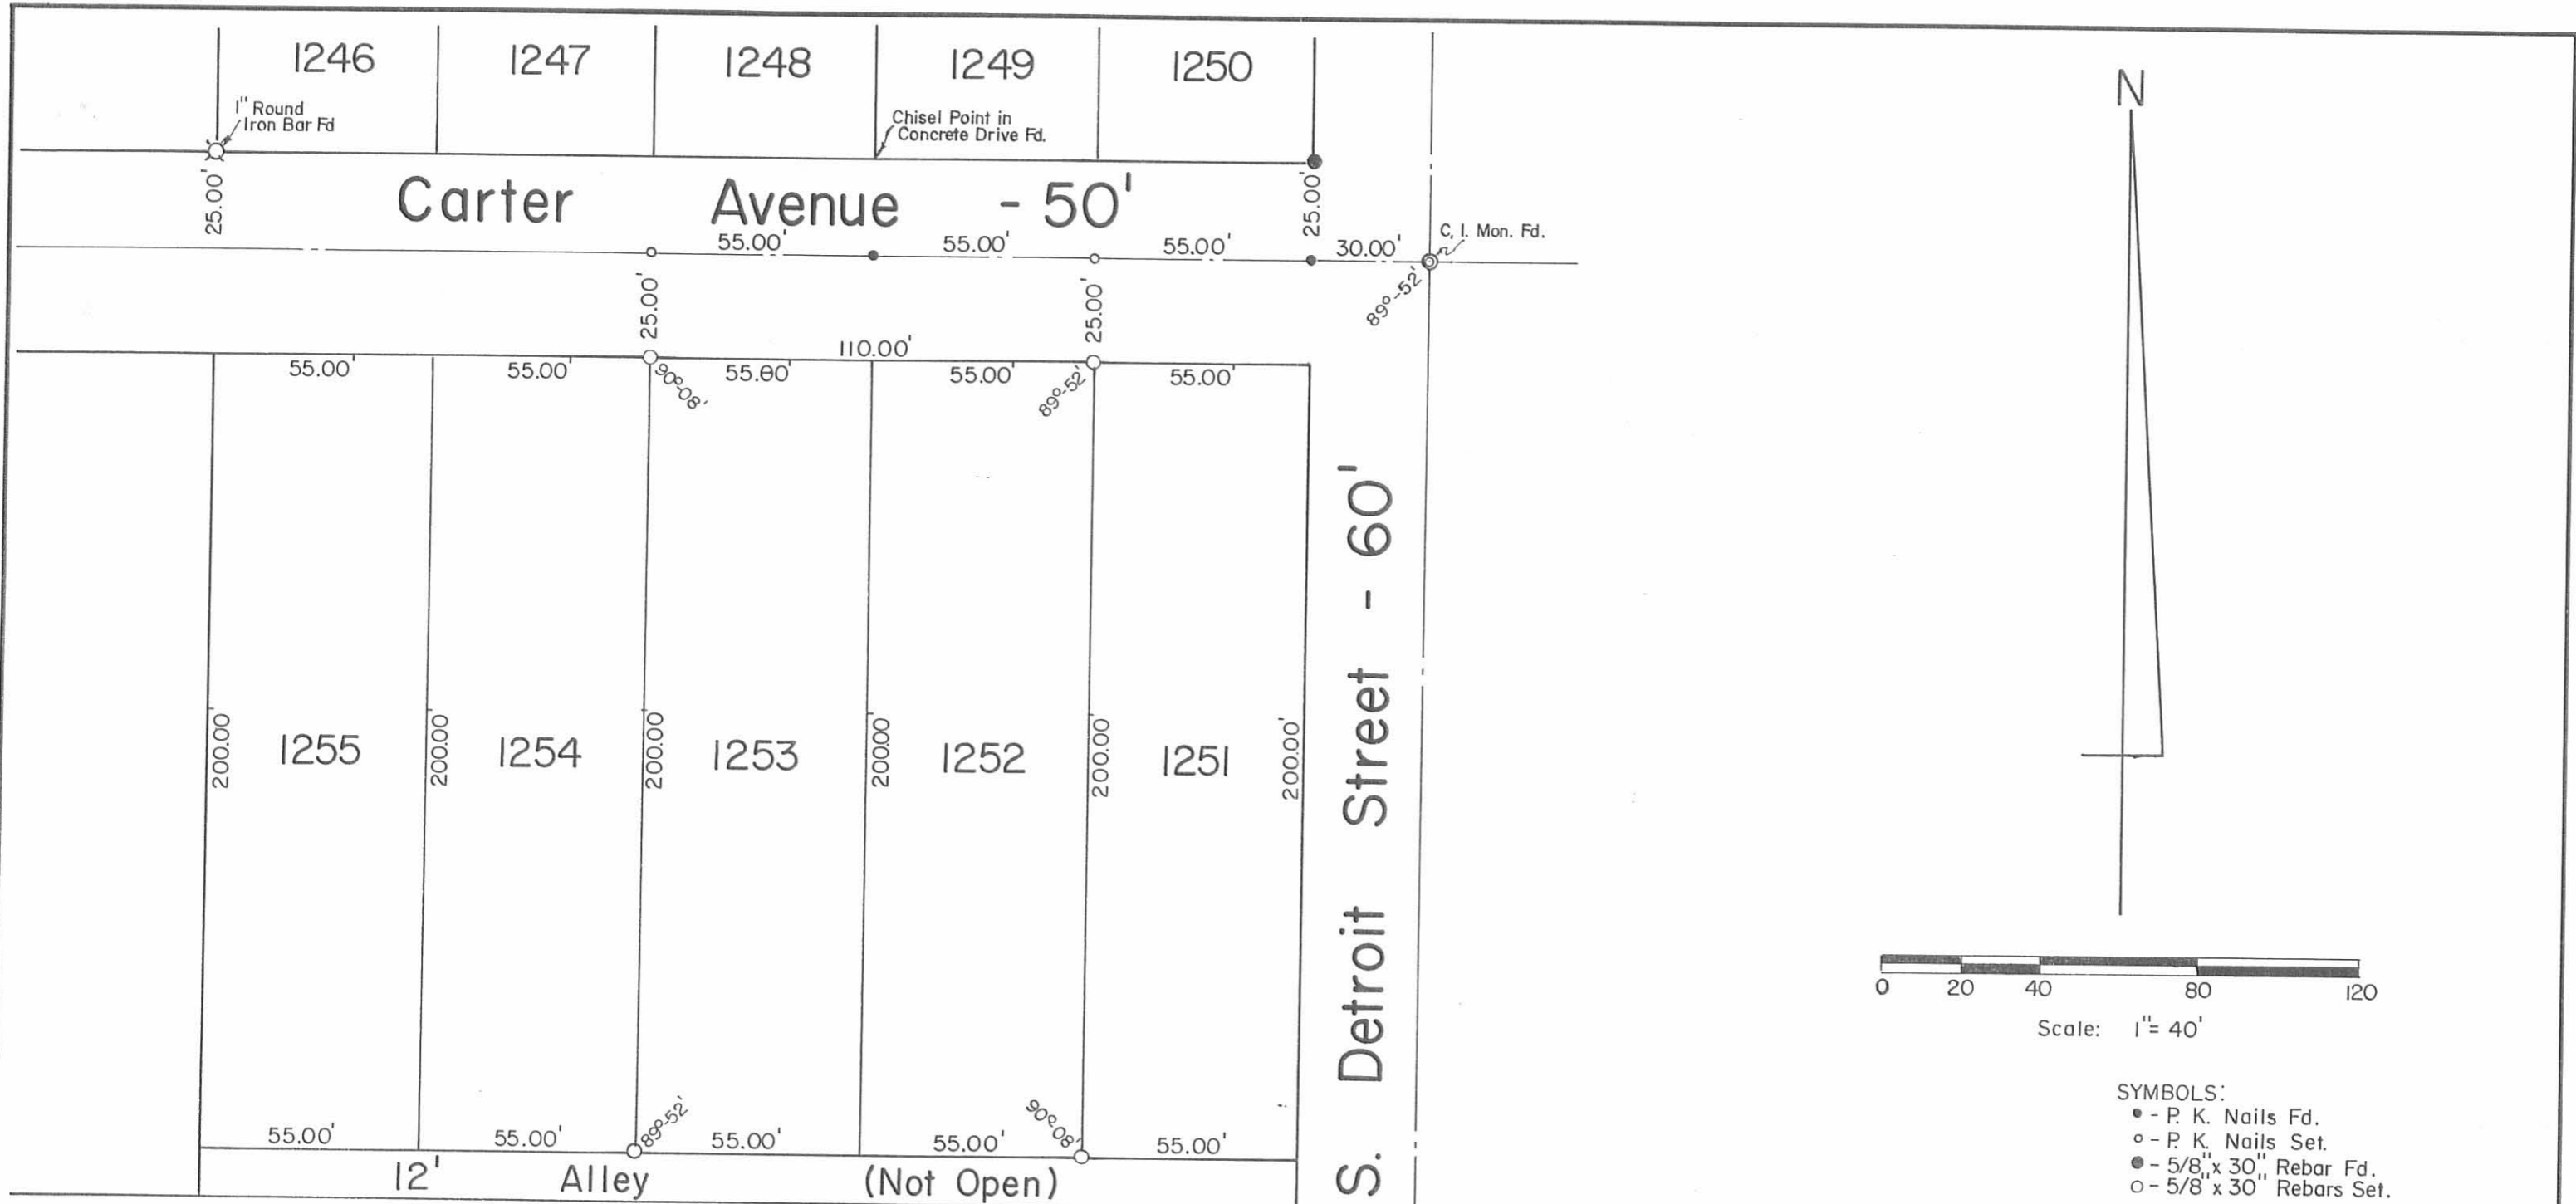

Scale: 1" = 40'

- SYMBOLS:
- - P. K. Nails Fd.
  - - P. K. Nails Set.
  - - 5/8" x 30" Rebar Fd.
  - - 5/8" x 30" Rebars Set.

Reference:  
Carter South Addition,  
Plat Cabinet A, Slide 19.

**RUTHERFORD SURVEY - LOTS NO. 1252-1253,**  
City of Bellefontaine, Lake Township,  
Logan County, Ohio.

SCALE: 1" = 40'	APPROVED BY:	DRAWN BY: DEG
DATE: 3-27-1996		REVISED:

*Daniel E. Gilbert*

Daniel E. Gilbert, P.S.  
Reg. Sur. No. 5402

DRAWING NUMBER  
**096-020**

INDEXED ON MAP  
9063 IF

