
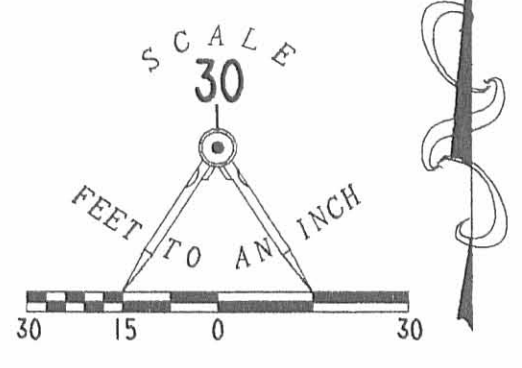


REC'D 8-29-00 8/29/00

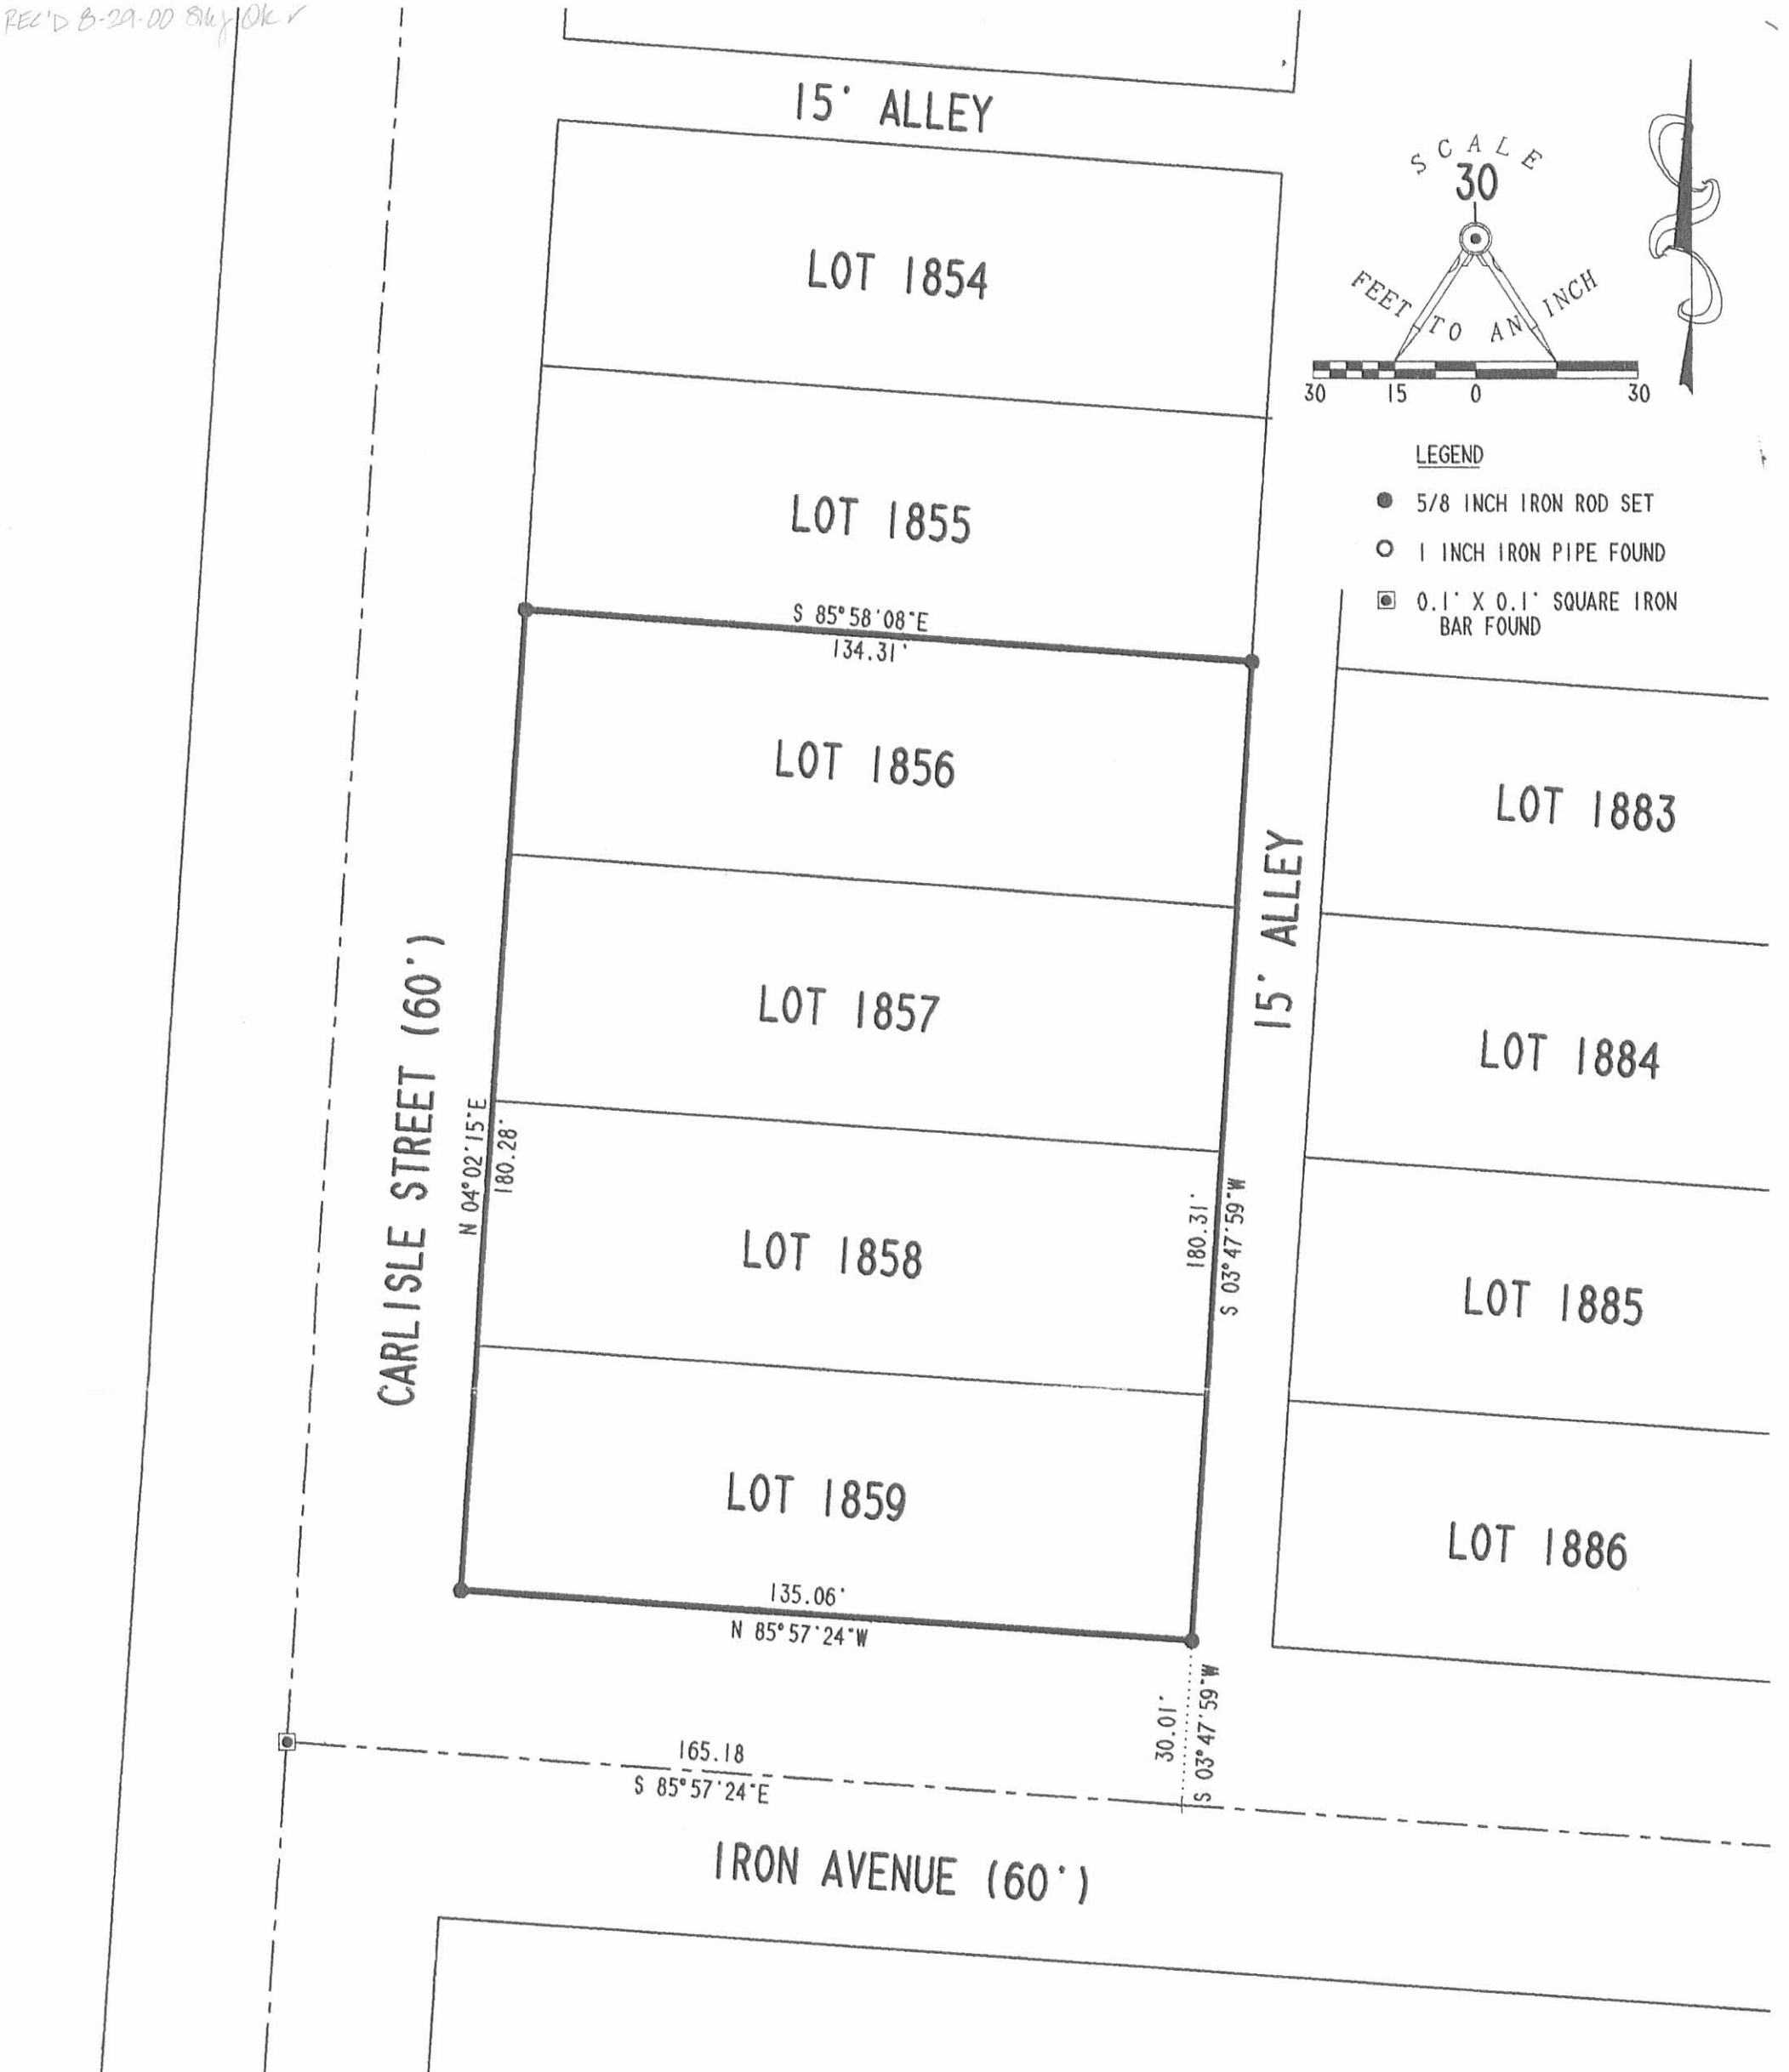

- LEGEND**
- 5/8 INCH IRON ROD SET
 - 1 INCH IRON PIPE FOUND
 - ◻ 0.1' X 0.1' SQUARE IRON BAR FOUND

RETRACEMENT SURVEY OF
 LOTS 1856, 1857, 1858 AND 1859
 OF IRON CITY ADDITION
 PLAT CABINET A, SLIDE 29
 SECTION 33, TOWN 4, RANGE 14
 CITY OF BELLEFONTAINE
 LAKE TOWNSHIP
 LOGAN COUNTY, OHIO

2 WORKING DAYS
BEFORE YOU DIG
 CALL TOLL FREE **800-362-2764**
 OHIO UTILITIES PROTECTION SERVICE.

INDEXED ON MAP
 9333 IP



ORIGINAL STAMP IN GREEN

SURVEYED BY:
William K. Bruce
 WILLIAM K. BRUCE
 PROFESSIONAL SURVEYOR 7437
 AUGUST 17, 2000

COPYRIGHT 2000 BY:
LEE SURVEYING & MAPPING CO., INC.
 117 North Madriver Street
 BELLEFONTAINE, OHIO 43311
 (937) 593-7335