


EXHIBIT B TO DECLARATION AND BYLAWS OF LUDLOW BRIDGE CONDOMINIUMS - PHASE IX

6.04 ACRE TRACT, 1.00 ACRE TRACT, 8.05 ACRE TRACT OFFICIAL RECORD 710, PAGE 550, TRACTS I, II AND III
0.868 ACRE TRACT OFFICIAL RECORD 740, PAGE 620

VIRGINIA MILITARY SURVEY 4990 CITY OF BELLEFONTAINE LAKE TOWNSHIP LOGAN COUNTY, OHIO

| CURVE | DELTA ANGLE | RADIUS | ARC LENGTH | CHORD BEARING | CHORD LENGTH |
|-------|-------------|--------|------------|---------------|--------------|
| C1 | 15°04'58" | 88.00 | 23.17 | S 76°42'24" E | 23.10 |
| C2 | 33°57'12" | 100.00 | 59.26 | S 22°03'33" W | 58.40 |
| C3 | 18°45'04" | 50.00 | 16.36 | S 14°27'29" W | 16.29 |
| C4 | 35°40'10" | 88.00 | 54.78 | S 22°55'02" W | 53.90 |
| C5 | 18°35'57" | 62.00 | 20.13 | S 14°22'37" W | 20.04 |
| C6 | 16°59'17" | 88.00 | 26.09 | S 49°14'46" W | 26.00 |
| C7 | 74°50'42" | 62.00 | 80.99 | S 32°20'24" E | 75.35 |
| C8 | 20°09'21" | 62.00 | 21.81 | N 84°26'59" W | 21.70 |
| C9 | 49°12'53" | 62.00 | 53.26 | N 21°01'05" W | 51.63 |
| C10 | 51°52'12" | 112.00 | 101.39 | N 84°18'09" E | 97.97 |
| C11 | 52°29'51" | 88.00 | 80.63 | S 83°59'20" W | 77.84 |
| C12 | 24°19'33" | 112.00 | 47.55 | S 70°31'50" W | 47.20 |
| C13 | 21°40'03" | 62.00 | 23.45 | N 05°45'04" W | 23.31 |
| C14 | 15°24'21" | 162.00 | 43.56 | S 12°47'08" W | 43.43 |

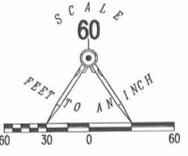

- LEGEND:
- ⊗ 1-1/4 INCH IRON PIPE FOUND
 - 5/8 INCH IRON ROD SET
 - 5/8 INCH IRON ROD FOUND
 - ⊙ MAG NAIL SET
 - ⊘ MAG NAIL FOUND
 - ⊙ RAILROAD SPIKE SET
 - ⊘ RAILROAD SPIKE FOUND
 - ▨ LIMITED COMMON AREA
 - [] UNIT NUMBER


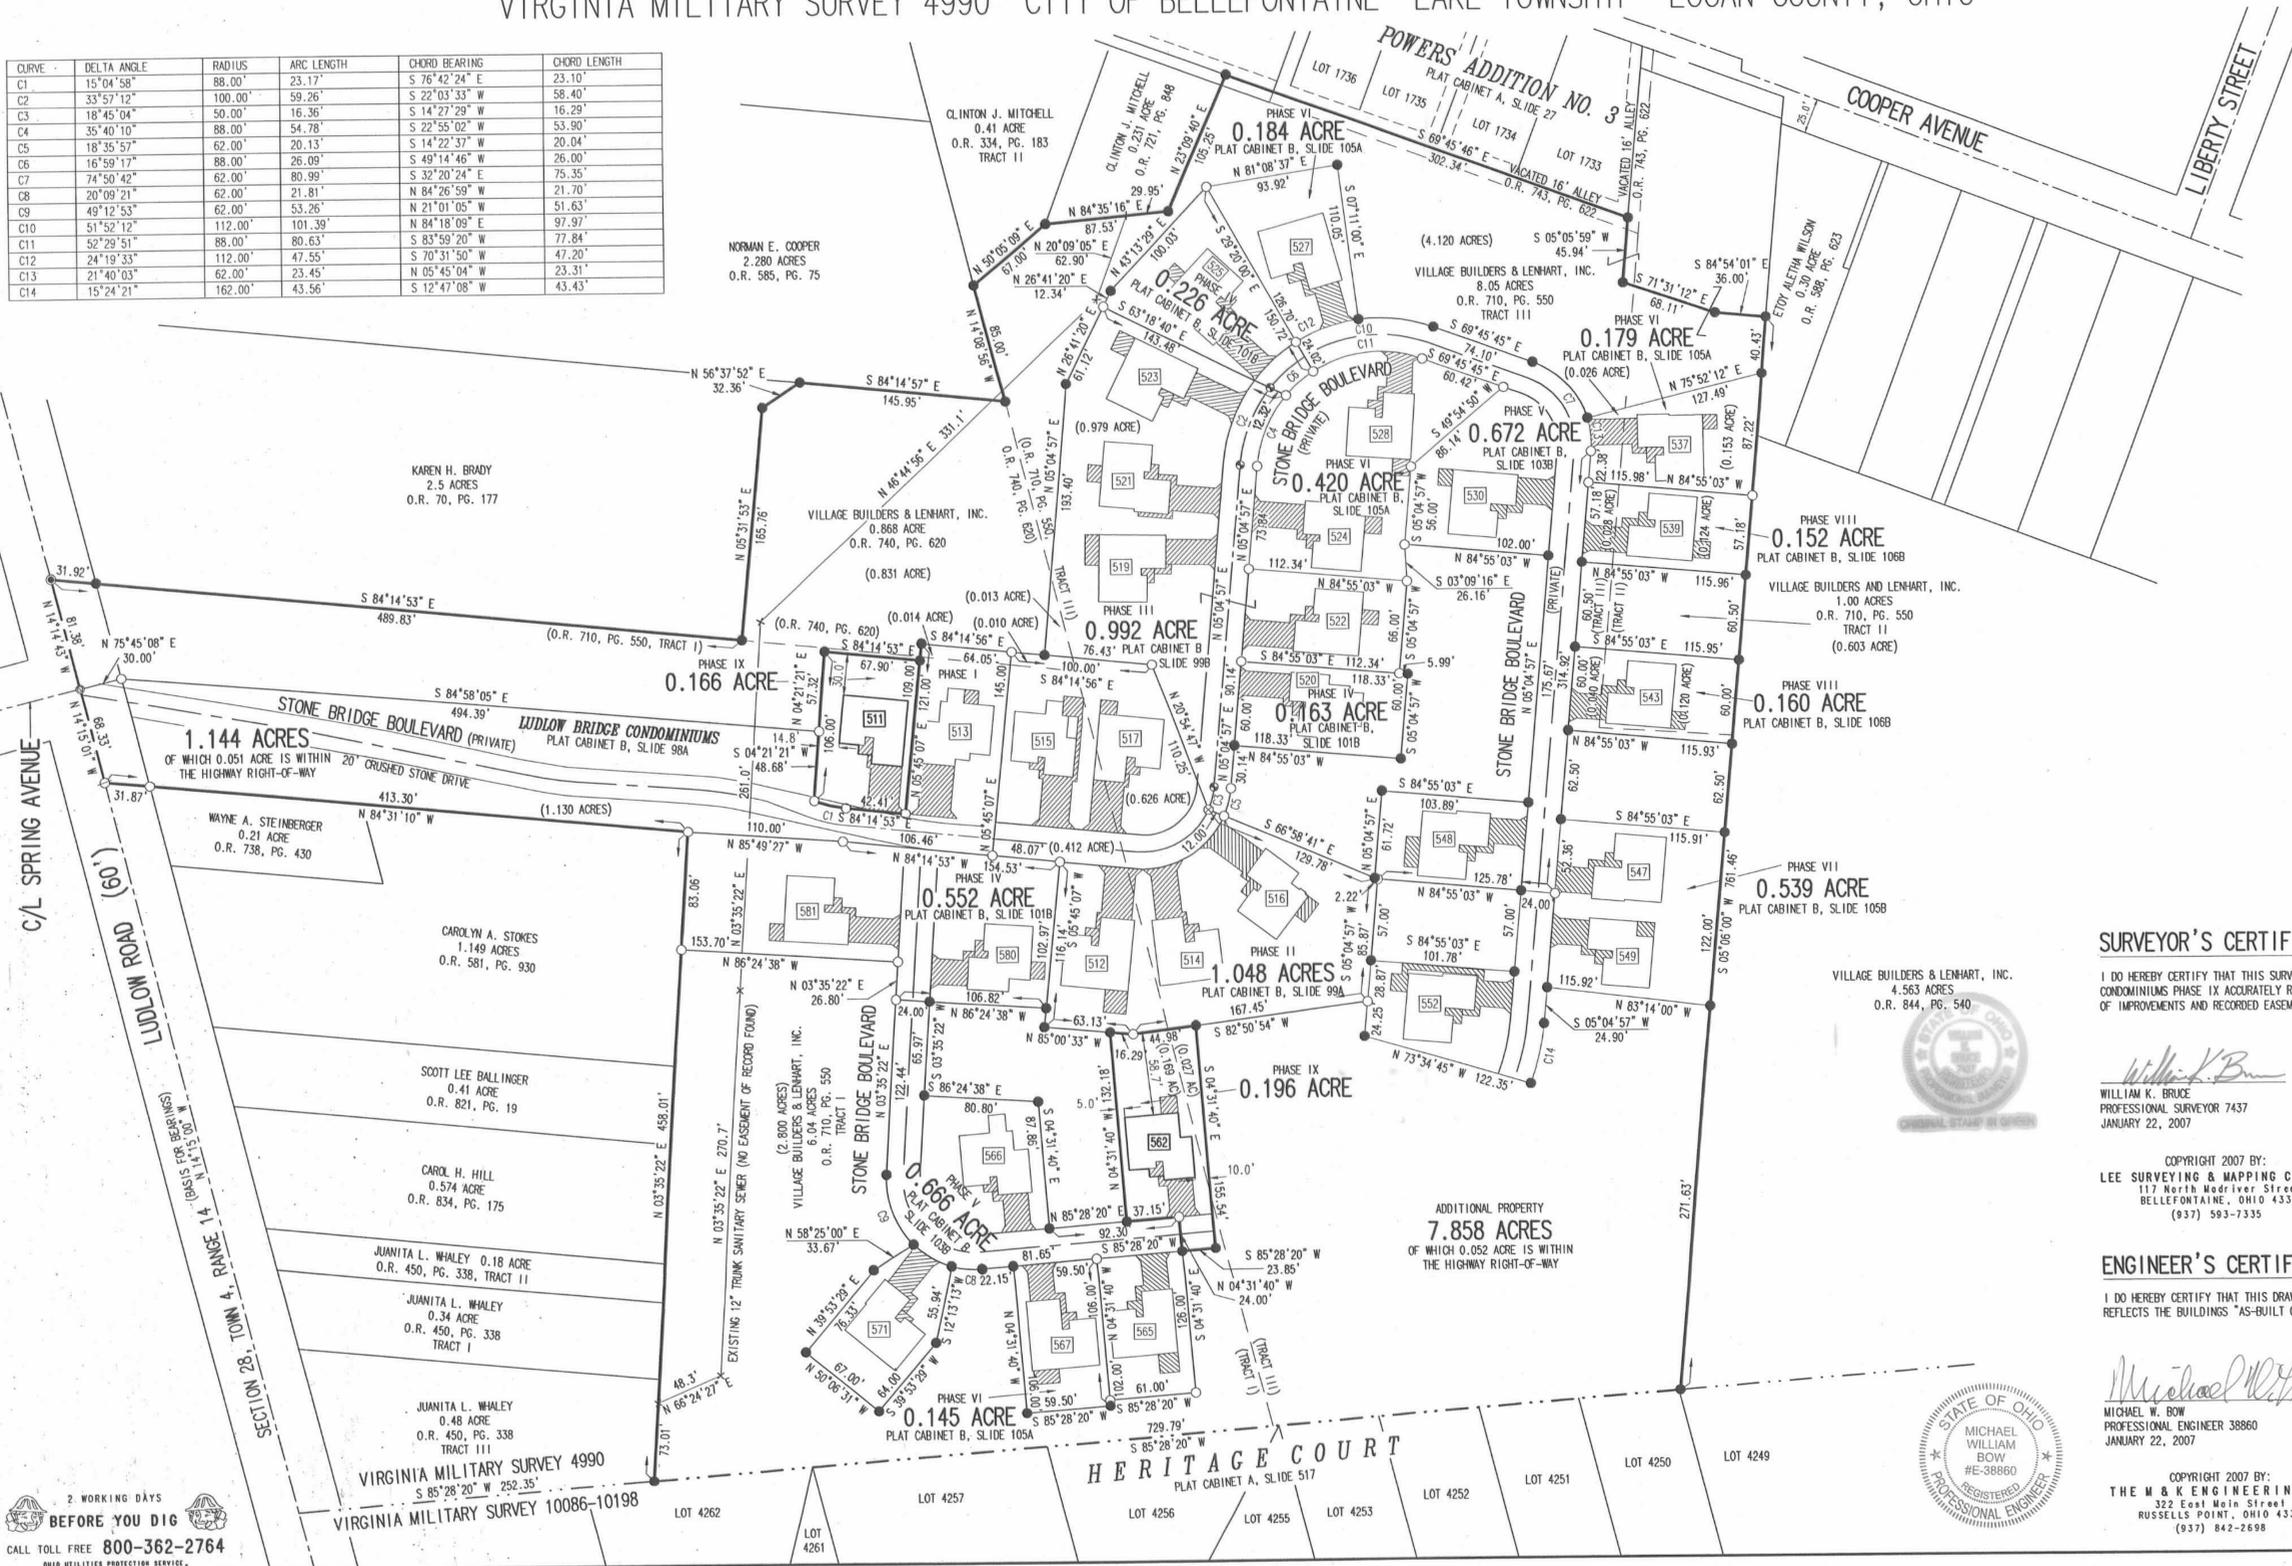


EXHIBIT B TO DECLARATION AND BYLAWS OF LUDLOW BRIDGE CONDOMINIUMS - PHASE X

6.04 ACRE TRACT, 1.00 ACRE TRACT, 8.05 ACRE TRACT OFFICIAL RECORD 710, PAGE 550, TRACTS I, II AND III


0.868 ACRE TRACT OFFICIAL RECORD 740, PAGE 620

VIRGINIA MILITARY SURVEY 4990 CITY OF BELLEFONTAINE LAKE TOWNSHIP LOGAN COUNTY, OHIO

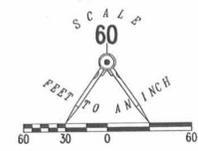

| CURVE | DELTA ANGLE | RADIUS | ARC LENGTH | CHORD BEARING | CHORD LENGTH |
|-------|-------------|---------|------------|---------------|--------------|
| C1 | 15°04'58" | 88.00' | 23.17' | S 76°42'24" E | 23.10' |
| C2 | 33°57'12" | 100.00' | 59.26' | S 22°03'33" W | 58.40' |
| C3 | 18°45'04" | 50.00' | 16.36' | S 14°27'29" W | 16.29' |
| C4 | 35°40'10" | 88.00' | 54.78' | S 22°55'02" W | 53.90' |
| C5 | 18°35'57" | 62.00' | 20.13' | S 14°22'37" W | 20.04' |
| C6 | 16°59'17" | 88.00' | 26.09' | S 49°14'46" W | 26.00' |
| C7 | 74°50'42" | 62.00' | 80.99' | S 32°20'24" E | 75.35' |
| C8 | 20°08'21" | 62.00' | 21.81' | N 84°26'59" W | 21.70' |
| C9 | 49°12'53" | 62.00' | 53.28' | N 21°01'05" W | 51.63' |
| C10 | 51°52'12" | 112.00' | 101.39' | N 84°18'09" E | 97.97' |
| C11 | 52°29'51" | 88.00' | 80.63' | S 83°59'20" W | 77.84' |
| C12 | 24°19'33" | 112.00' | 47.55' | S 70°31'50" W | 47.20' |
| C13 | 21°40'03" | 62.00' | 23.45' | N 05°45'04" W | 23.31' |
| C14 | 18°24'21" | 162.00' | 43.56' | S 12°47'08" W | 43.43' |
| C15 | 18°09'08" | 162.00' | 51.32' | S 76°23'46" W | 51.11' |

- LEGEND:
- 1-1/4 INCH IRON PIPE FOUND
 - 5/8 INCH IRON ROD SET
 - 5/8 INCH IRON ROD FOUND
 - MAG NAIL SET
 - MAG NAIL FOUND
 - RAILROAD SPIKE SET
 - RAILROAD SPIKE FOUND
 - ▨ LIMITED COMMON AREA
 - 111 UNIT NUMBER

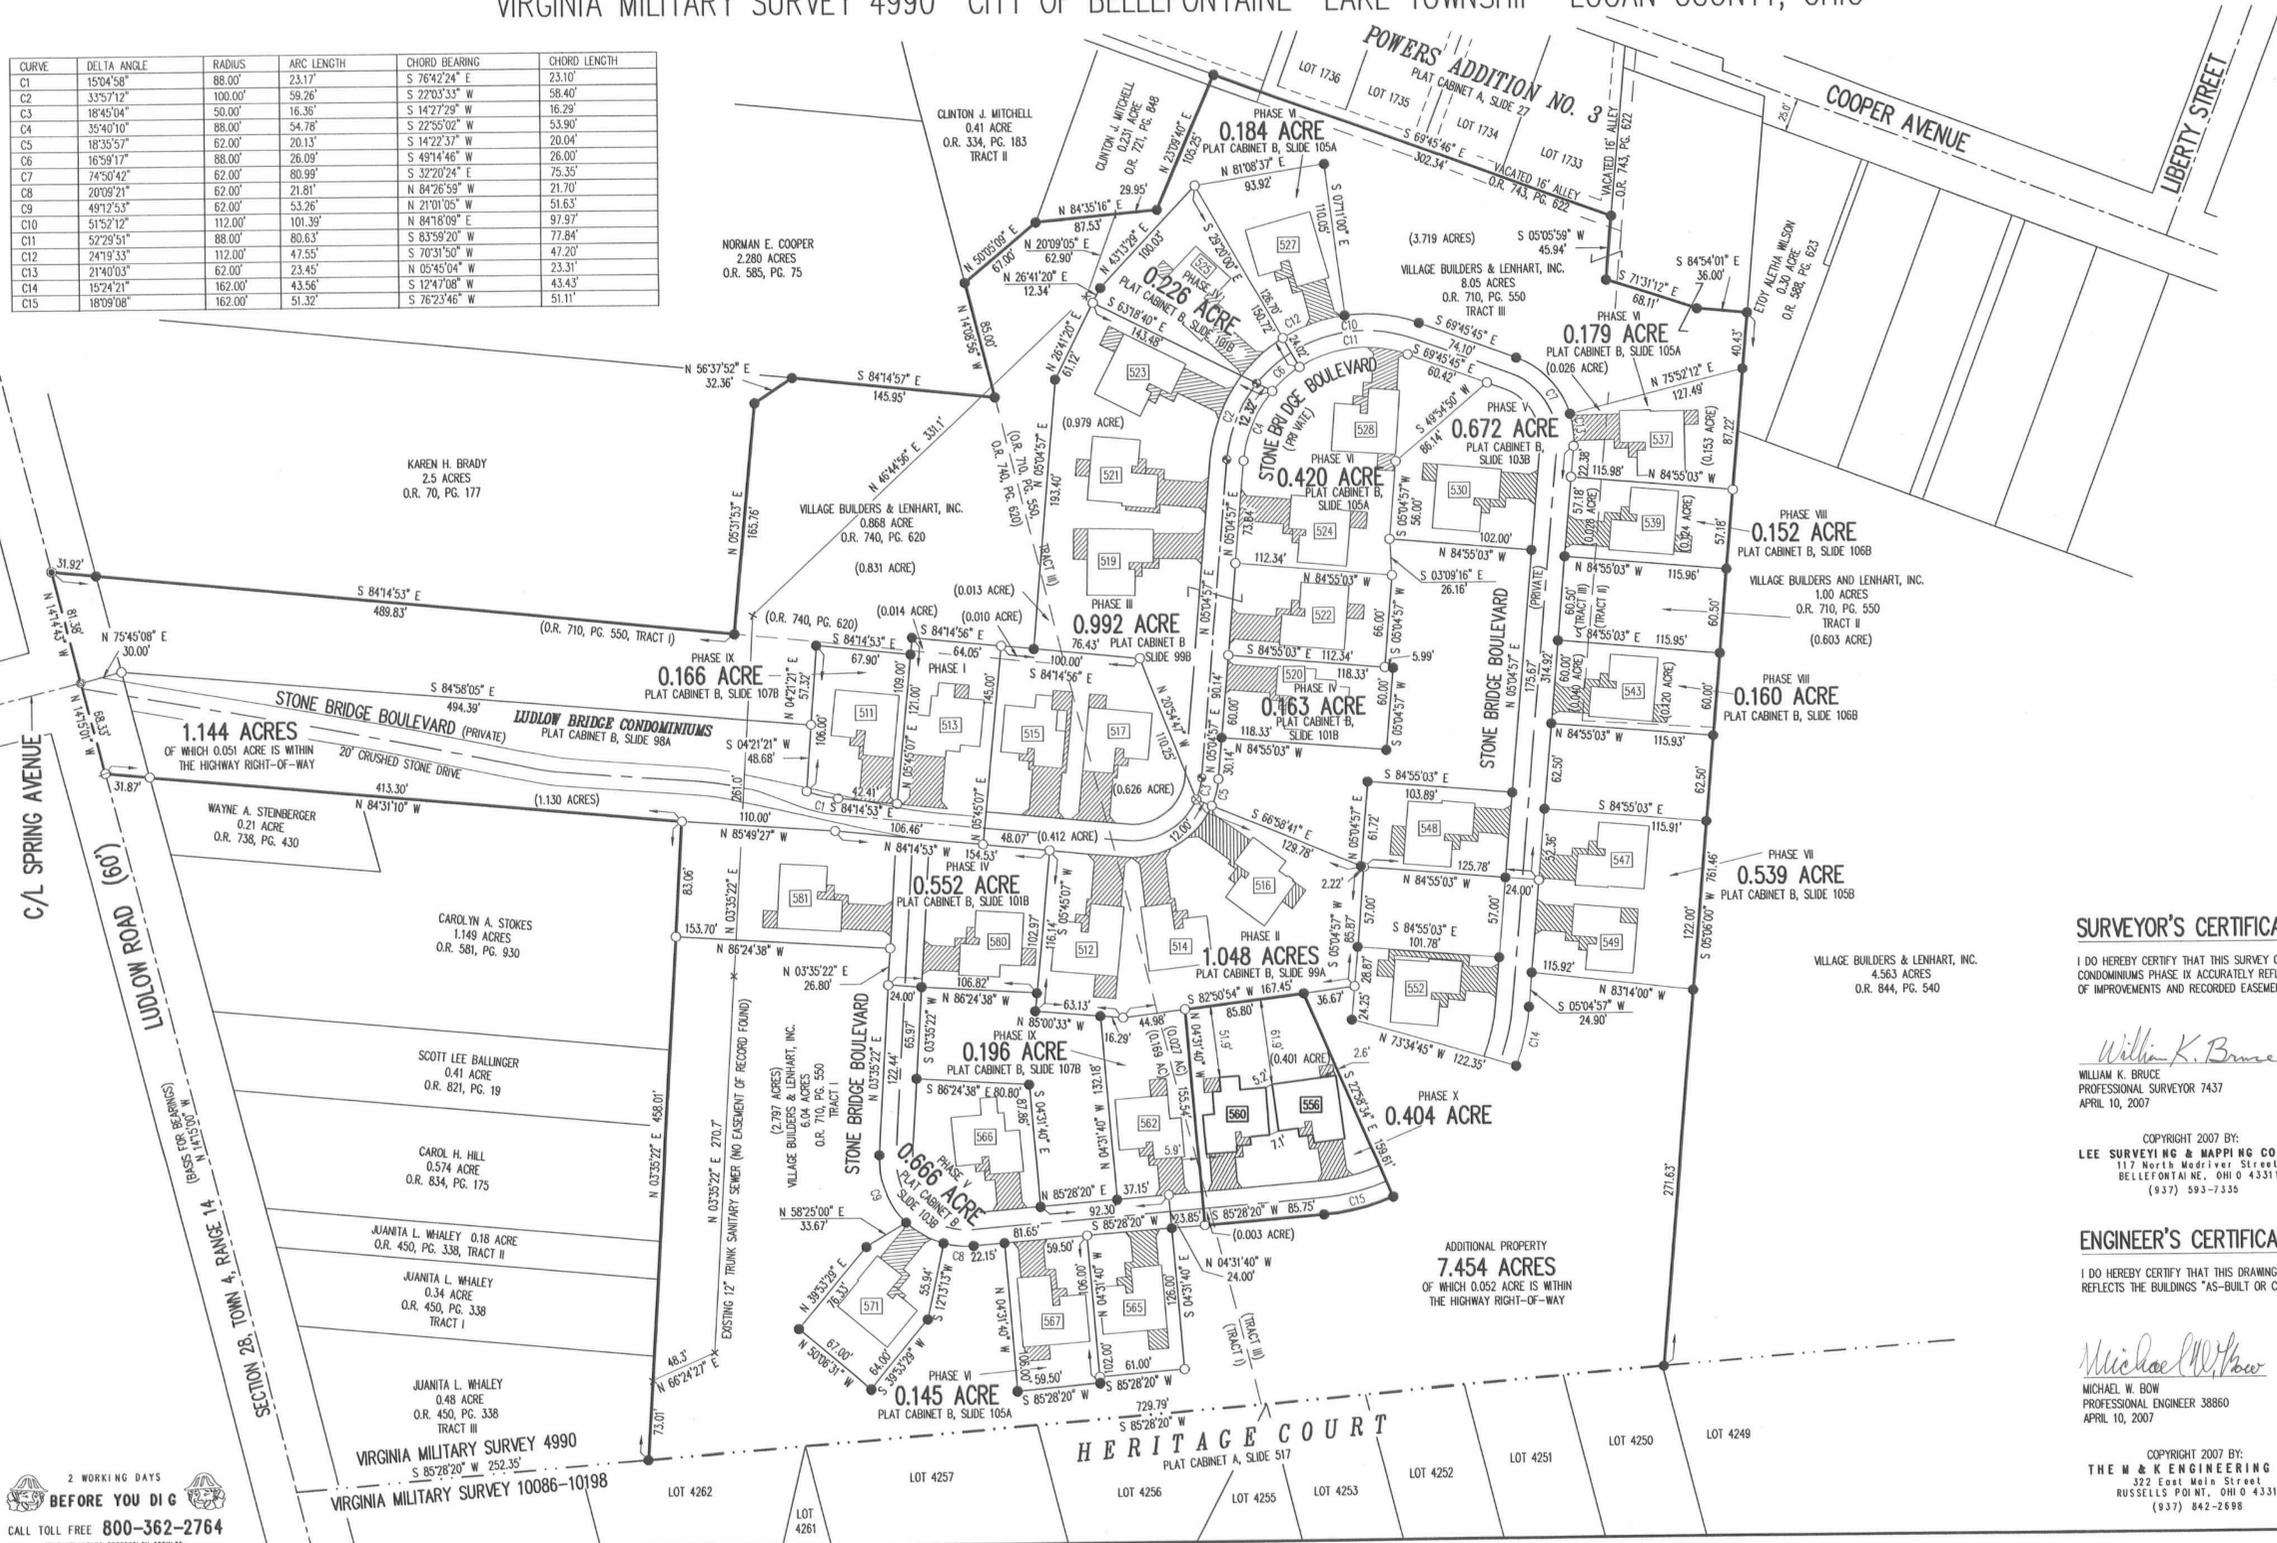

- NOTES:
- EASEMENTS IF SHOWN ARE AS PROVIDED BY DEVELOPER. THE SURVEYOR DID NOT SEARCH FOR ADDITIONAL EASEMENTS.
 - THE WORD "CERTIFY" IS INTENDED TO BE AS DEFINED IN OHIO ADMINISTRATIVE CODE 4733-35-04(C).
 - BUILDING HEIGHT FROM PEAK OF ROOF TO GROUND:
UNIT 556 IS 19.8'
UNIT 560 IS 19.6'

SURVEYOR'S CERTIFICATION:

I DO HEREBY CERTIFY THAT THIS SURVEY OF LUDLOW BRIDGE CONDOMINIUMS PHASE IX ACCURATELY REFLECTS THE LOCATION OF IMPROVEMENTS AND RECORDED EASEMENTS.

William K. Bruce
WILLIAM K. BRUCE
PROFESSIONAL SURVEYOR 7437
APRIL 10, 2007

COPYRIGHT 2007 BY:
LEE SURVEYING & MAPPING CO., INC.
117 North Medfield Street
BELLEFONTAINE, OHIO 43311
(937) 593-7335

ENGINEER'S CERTIFICATION:

I DO HEREBY CERTIFY THAT THIS DRAWING ACCURATELY REFLECTS THE BUILDINGS "AS-BUILT OR CONSTRUCTED".

Michael W. Bow
MICHAEL W. BOW
PROFESSIONAL ENGINEER 38860
APRIL 10, 2007

COPYRIGHT 2007 BY:
THE M & K ENGINEERING CO.
322 East Main Street
RUSSELLS POINT, OHIO 43311
(937) 842-2698



PRE-APPROVAL *J.C. [Signature]* 4-13-07
 PLAT CHECKED *J.C. [Signature]* 4-13-07
 TRANSFERRED THIS 13th DAY OF April, 2007
 AUDITOR, LOGAN COUNTY, OHIO *Michael E. [Signature]*
 RECORDED IN PLAT CABINET B, SLIDE 108A
 RECEIVED FOR RECORD AT 2:16 O'CLOCK P.M.
 THIS 13th DAY OF April, 2007
 RECORDER, LOGAN COUNTY, OHIO *Linda Hanson*

2 WORKING DAYS
BEFORE YOU DIG
CALL TOLL FREE 800-362-2764
OHIO UTILITIES PROTECTION SERVICE


EXHIBIT B TO DECLARATION AND BYLAWS OF

LUDLOW BRIDGE CONDOMINIUMS - PHASE V


6.04 ACRE TRACT, 1.00 ACRE TRACT, 8.05 ACRE TRACT OFFICIAL RECORD 710, PAGE 550, TRACTS I, II AND III

0.868 ACRE TRACT OFFICIAL RECORD 740, PAGE 620

VIRGINIA MILITARY SURVEY 4990 CITY OF BELLEFONTAINE LAKE TOWNSHIP LOGAN COUNTY, OHIO

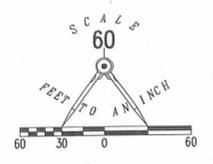

| CURVE | DELTA ANGLE | RADIUS | ARC LENGTH | CHORD BEARING | CHORD LENGTH |
|-------|-------------|---------|------------|---------------|--------------|
| C1 | 15°04'58" | 88.00' | 23.17' | S 76°42'24" E | 23.10' |
| C2 | 33°57'12" | 100.00' | 59.26' | S 22°03'33" W | 58.40' |
| C3 | 18°45'04" | 50.00' | 16.36' | S 14°27'29" W | 16.29' |
| C4 | 35°40'10" | 88.00' | 54.78' | S 22°55'02" W | 53.90' |
| C5 | 18°35'57" | 62.00' | 20.13' | S 14°22'37" W | 20.04' |
| C6 | 16°59'17" | 88.00' | 26.09' | S 49°14'46" W | 26.00' |
| C7 | 74°50'42" | 80.99' | 80.99' | S 32°20'24" E | 75.35' |
| C8 | 20°09'21" | 62.00' | 21.81' | N 84°26'59" W | 21.70' |
| C9 | 49°12'53" | 62.00' | 53.26' | N 21°01'05" W | 51.63' |
| C10 | 51°52'12" | 112.00' | 101.39' | N 84°18'09" E | 97.97' |
| C11 | 52°29'51" | 88.00' | 80.63' | S 83°59'20" W | 77.84' |

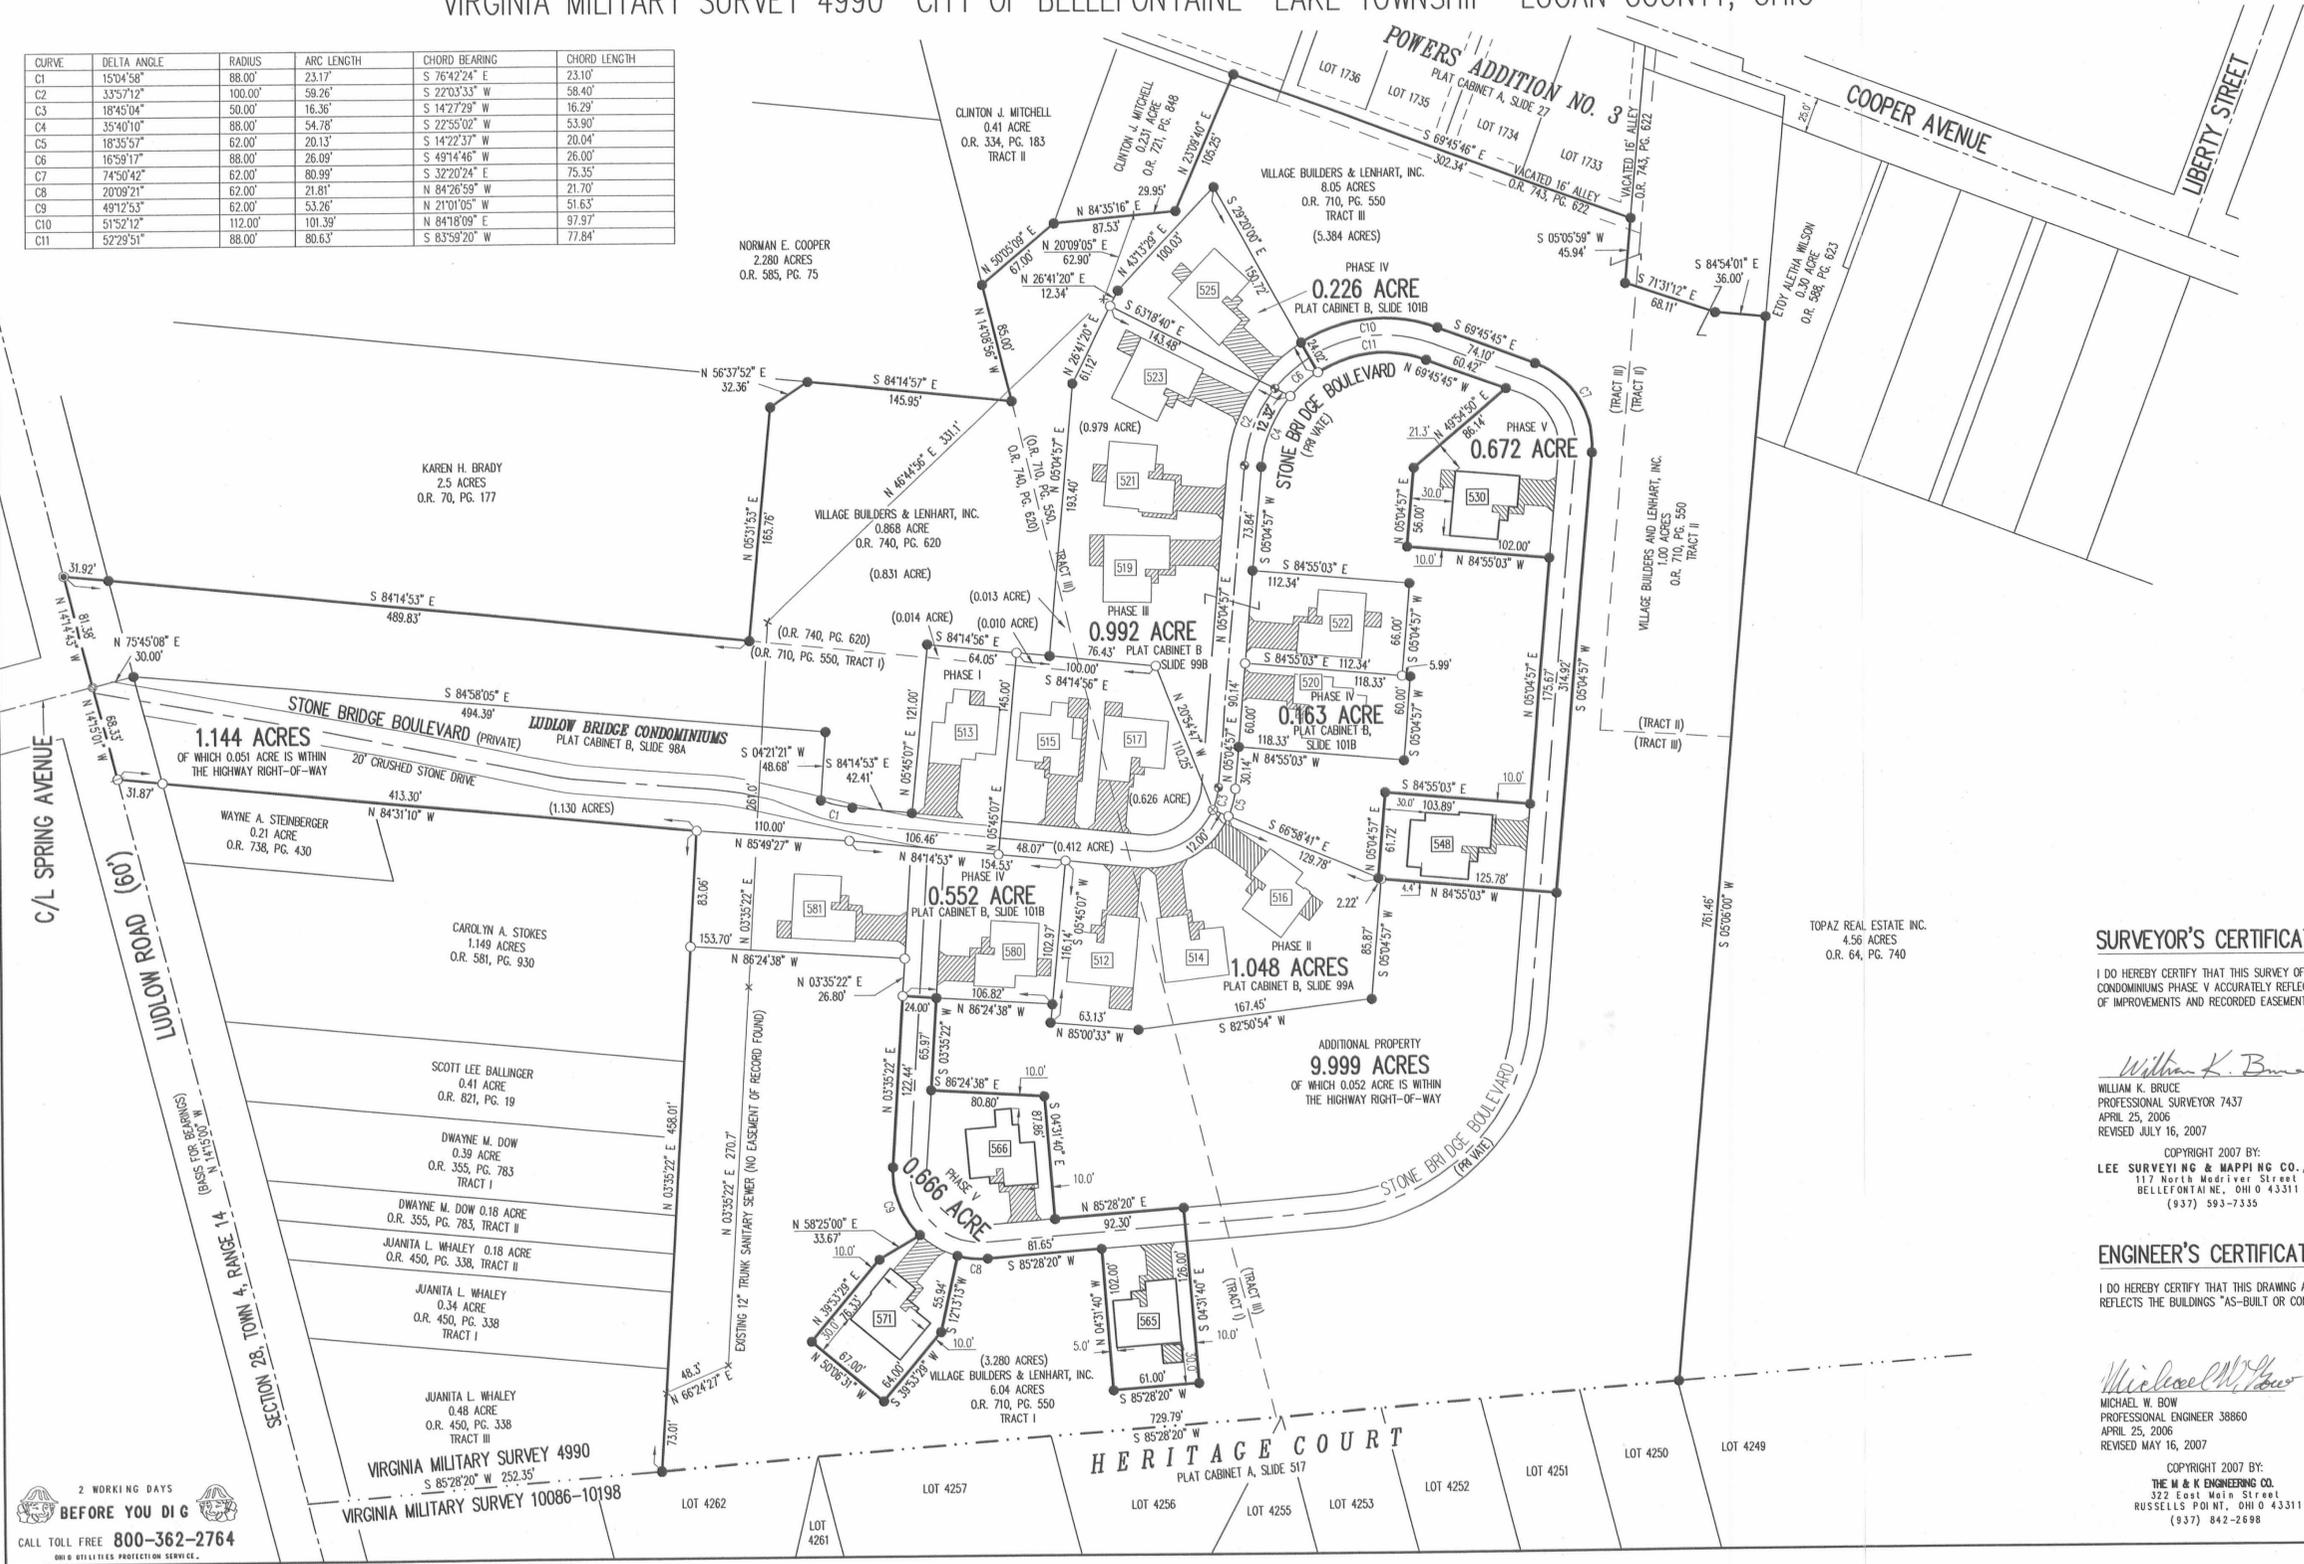

- LEGEND:
- 1-1/4 INCH IRON PIPE FOUND
 - 5/8 INCH IRON ROD SET
 - 5/8 INCH IRON ROD FOUND
 - MAG NAIL SET
 - MAG NAIL FOUND
 - RAILROAD SPIKE SET
 - RAILROAD SPIKE FOUND
 - ▨ LIMITED COMMON AREA
 - UNIT NUMBER

- NOTES:
- EASEMENTS IF SHOWN ARE AS PROVIDED BY DEVELOPER. THE SURVEYOR DID NOT SEARCH FOR ADDITIONAL EASEMENTS.
 - THE WORD "CERTIFY" IS INTENDED TO BE AS DEFINED IN OHIO ADMINISTRATIVE CODE 4733-35-04(C).
 - BUILDING HEIGHT FROM PEAK OF ROOF TO GROUND:
 UNIT 530 IS 23.9'
 UNIT 548 IS 21.0'
 UNIT 565 IS 19.8'
 UNIT 566 IS 21.1'
 UNIT 571 IS 19.5'

SURVEYOR'S CERTIFICATION:

I DO HEREBY CERTIFY THAT THIS SURVEY OF LUDLOW BRIDGE CONDOMINIUMS PHASE V ACCURATELY REFLECTS THE LOCATION OF IMPROVEMENTS AND RECORDED EASEMENTS.

William K. Bruce
 WILLIAM K. BRUCE
 PROFESSIONAL SURVEYOR 7437

APRIL 25, 2006
 REVISED JULY 16, 2007
 COPYRIGHT 2007 BY:
 LEE SURVEYING & MAPPING CO., INC.
 117 North Madison Street
 BELLEFONTAINE, OHIO 43311
 (937) 593-7335



ENGINEER'S CERTIFICATION:

I DO HEREBY CERTIFY THAT THIS DRAWING ACCURATELY REFLECTS THE BUILDINGS "AS-BUILT OR CONSTRUCTED".

Michael W. Bow
 MICHAEL W. BOW
 PROFESSIONAL ENGINEER 38860

APRIL 25, 2006
 REVISED MAY 16, 2007
 COPYRIGHT 2007 BY:
 THE M & K ENGINEERING CO.
 322 East Main Street
 RUSSELLS POINT, OHIO 43311
 (937) 842-2698




PRE-APPROVAL *J.C.H.* 8-6-07
 PLAT CHECKED *J.C.H.* 8-6-07
 TRANSFERRED THIS 6th DAY OF August, 2007
 AUDITOR, LOGAN COUNTY, OHIO
 RECORDED IN PLAT CABINET B, SLIDE 109B
 RECEIVED FOR RECORD AT 1:32:58 O'CLOCK P.M.
 THIS 6th DAY OF August, 2007
Linda Hanson
 RECORDER, LOGAN COUNTY, OHIO

2 WORKING DAYS
BEFORE YOU DIG
 CALL TOLL FREE 800-362-2764
 OHIO UTILITIES PROTECTION SERVICE

2007005930


LUDLOW BRIDGE CONDOMINIUMS - PHASE XI

EXHIBIT B TO DECLARATION AND BYLAWS OF
 6.04 ACRE TRACT, 1.00 ACRE TRACT, 8.05 ACRE TRACT OFFICIAL RECORD 710, PAGE 550, TRACTS I, II AND III
 0.868 ACRE TRACT OFFICIAL RECORD 740, PAGE 620
 VIRGINIA MILITARY SURVEY 4990 CITY OF BELLEFONTAINE LAKE TOWNSHIP LOGAN COUNTY, OHIO

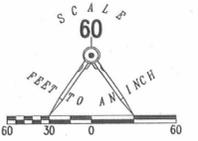

- LEGEND:
- 1-1/4 INCH IRON PIPE FOUND
 - 5/8 INCH IRON ROD SET
 - 5/8 INCH IRON ROD FOUND
 - MAG NAIL SET
 - MAG NAIL FOUND
 - ⊗ RAILROAD SPIKE SET
 - ⊗ RAILROAD SPIKE FOUND
 - ▨ LIMITED COMMON AREA
 - ▭ UNIT NUMBER

| CURVE | DELTA ANGLE | RADIUS | ARC LENGTH | CHORD BEARING | CHORD LENGTH |
|-------|-------------|---------|------------|---------------|--------------|
| C1 | 15°04'58" | 88.00' | 23.17' | S 76°42'24" E | 23.10' |
| C2 | 33°57'12" | 100.00' | 58.26' | S 22°03'33" W | 58.40' |
| C3 | 18°45'04" | 50.00' | 16.36' | S 14°27'29" W | 16.29' |
| C4 | 35°40'10" | 88.00' | 54.78' | S 22°55'02" W | 53.90' |
| C5 | 18°35'57" | 62.00' | 20.13' | S 14°27'37" W | 20.04' |
| C6 | 16°59'17" | 88.00' | 26.09' | S 49°14'46" W | 26.00' |
| C7 | 74°50'42" | 62.00' | 80.99' | S 32°20'24" E | 75.35' |
| C8 | 20°09'21" | 112.00' | 101.39' | N 84°26'59" W | 21.70' |
| C9 | 49°12'53" | 62.00' | 53.26' | N 21°01'05" E | 51.63' |
| C10 | 51°52'12" | 112.00' | 101.39' | N 84°18'09" E | 97.97' |
| C11 | 52°29'51" | 88.00' | 80.63' | S 83°59'20" W | 77.84' |
| C12 | 24°19'33" | 112.00' | 47.55' | S 70°31'50" W | 47.20' |
| C13 | 21°40'03" | 62.00' | 23.45' | N 05°45'04" W | 23.31' |
| C14 | 15°24'21" | 162.00' | 43.56' | S 12°47'06" W | 43.43' |
| C15 | 18°09'08" | 162.00' | 51.32' | S 76°23'46" W | 51.11' |
| C16 | 46°49'54" | 162.00' | 132.41' | S 43°54'15" W | 128.76' |

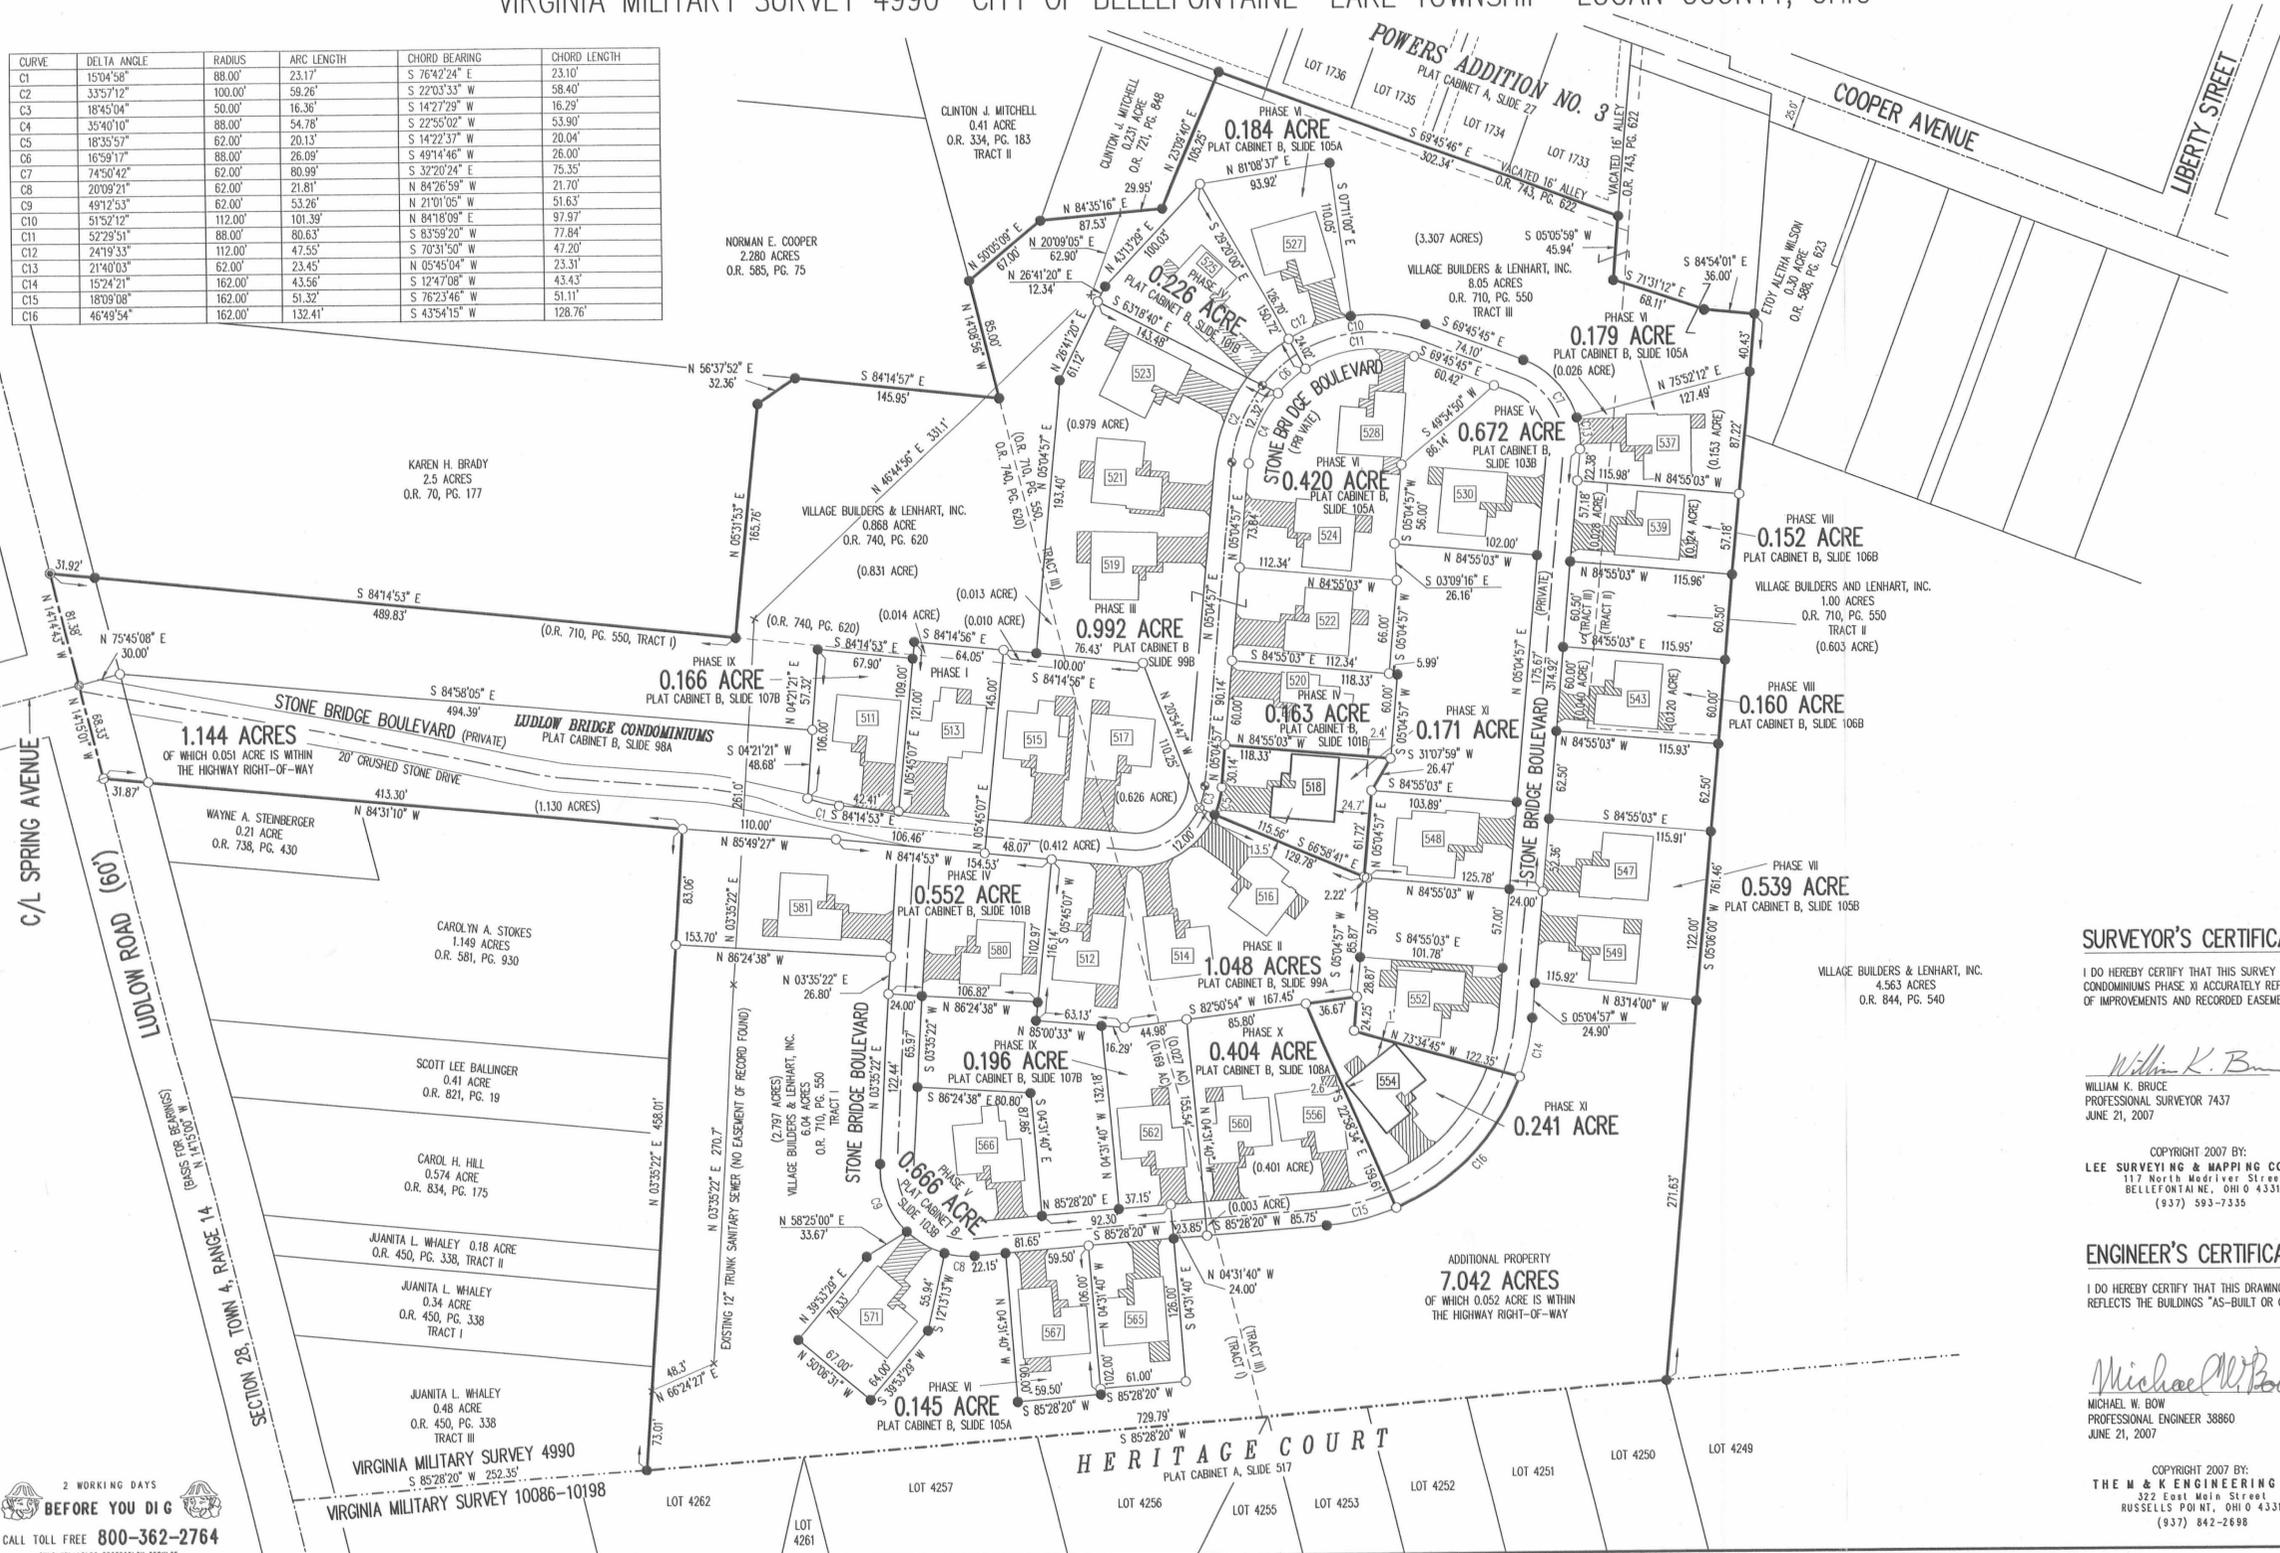

- NOTES:
1. EASEMENTS IF SHOWN ARE AS PROVIDED BY DEVELOPER. THE SURVEYOR DID NOT SEARCH FOR ADDITIONAL EASEMENTS.
 2. THE WORD "CERTIFY" IS INTENDED TO BE AS DEFINED IN OHIO ADMINISTRATIVE CODE 4733-35-04(C).
 3. BUILDING HEIGHT FROM PEAK OF ROOF TO GROUND:
 UNIT 518 IS 20.0'
 UNIT 554 IS 20.1'

SURVEYOR'S CERTIFICATION:

I DO HEREBY CERTIFY THAT THIS SURVEY OF LUDLOW BRIDGE CONDOMINIUMS PHASE XI ACCURATELY REFLECTS THE LOCATION OF IMPROVEMENTS AND RECORDED EASEMENTS.

William K. Bruce
 WILLIAM K. BRUCE
 PROFESSIONAL SURVEYOR 7437
 JUNE 21, 2007

COPYRIGHT 2007 BY:
 LEE SURVEYING & MAPPING CO., INC.
 117 North Medivler Street
 BELLEFONTAINE, OHIO 43311
 (937) 593-7335

ENGINEER'S CERTIFICATION:

I DO HEREBY CERTIFY THAT THIS DRAWING ACCURATELY REFLECTS THE BUILDINGS "AS-BUILT OR CONSTRUCTED".

Michael W. Bow
 MICHAEL W. BOW
 PROFESSIONAL ENGINEER 38860
 JUNE 21, 2007

COPYRIGHT 2007 BY:
 THE M & K ENGINEERING CO.
 322 East Main Street
 RUSSELLS POINT, OHIO 43311
 (937) 842-2698

PRE-APPROVAL *J.C.H.* 8-15-07
 PLAT CHECKED *J.C.H.* 8-15-07
 TRANSFERRED THIS 15th DAY OF August, 2007
 AUDITOR, LOGAN COUNTY, OHIO
 RECORDED IN PLAT CABINET B, SLIDE 110A
 RECEIVED FOR RECORD AT 3:29 O'CLOCK P.M.
 THIS 15th DAY OF August, 2007
Linda Hanson
 RECORDER, LOGAN COUNTY, OHIO

2 WORKING DAYS
BEFORE YOU DIG
 CALL TOLL FREE 800-362-2764
 OHIO PROFESSIONAL SURVEYORS

20070619H