

SURVEY OF  
LOT 3715 & PT 3716

L.P. 2 ALLOT

BELLEFONTAINE

DODSON  
Geotin


34r. 9/5/64

36

COLTON  
3/4" pipe  
Found

HAMILTON


MADRIER

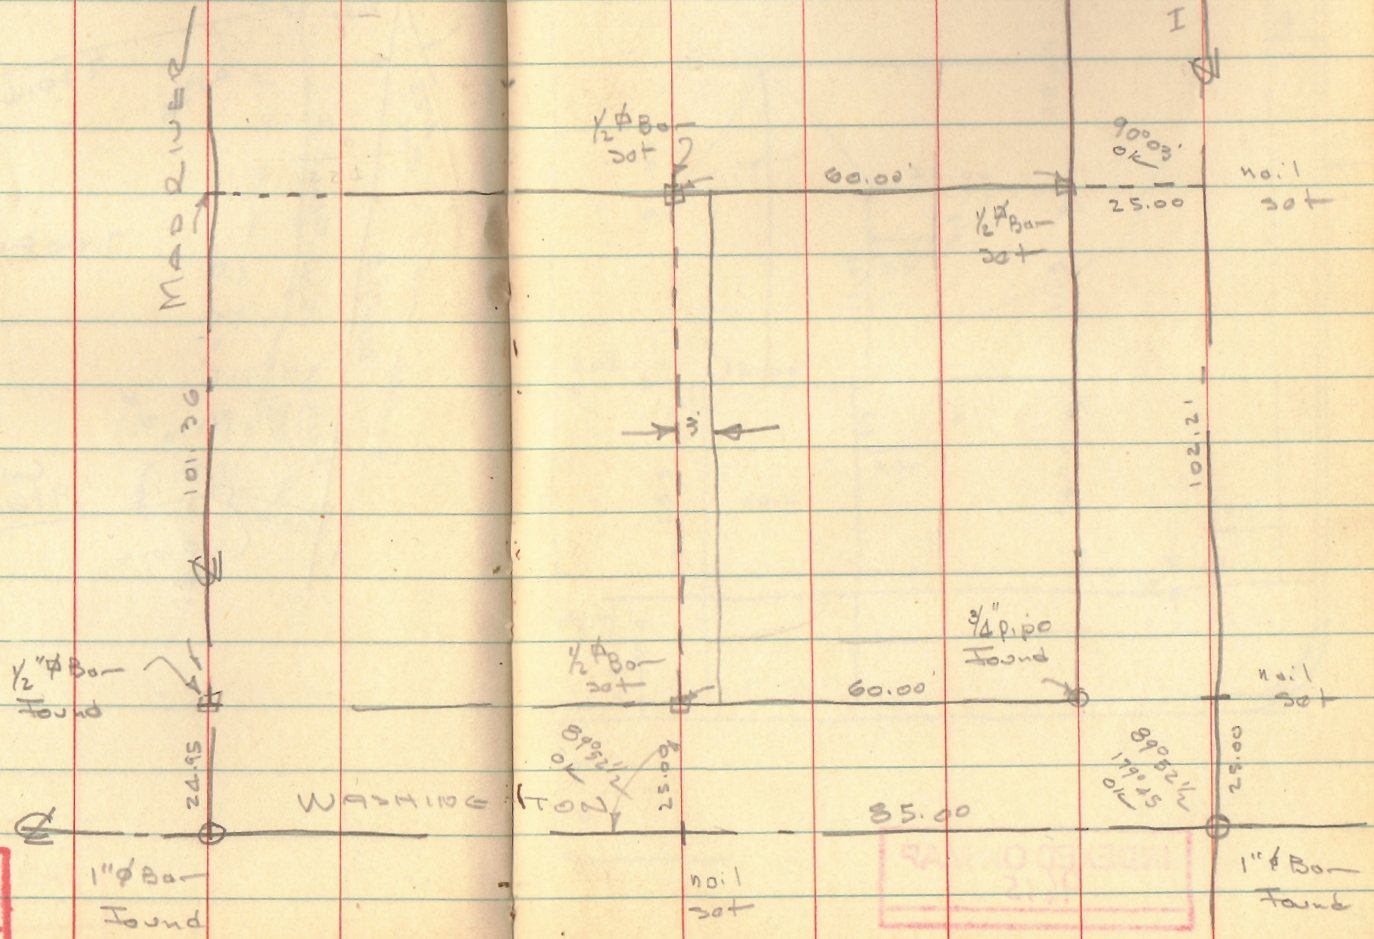

INDEXED ON MAP  
9615

9615

LOT 3715 & PT 3716  
 BELLE FONTAINE

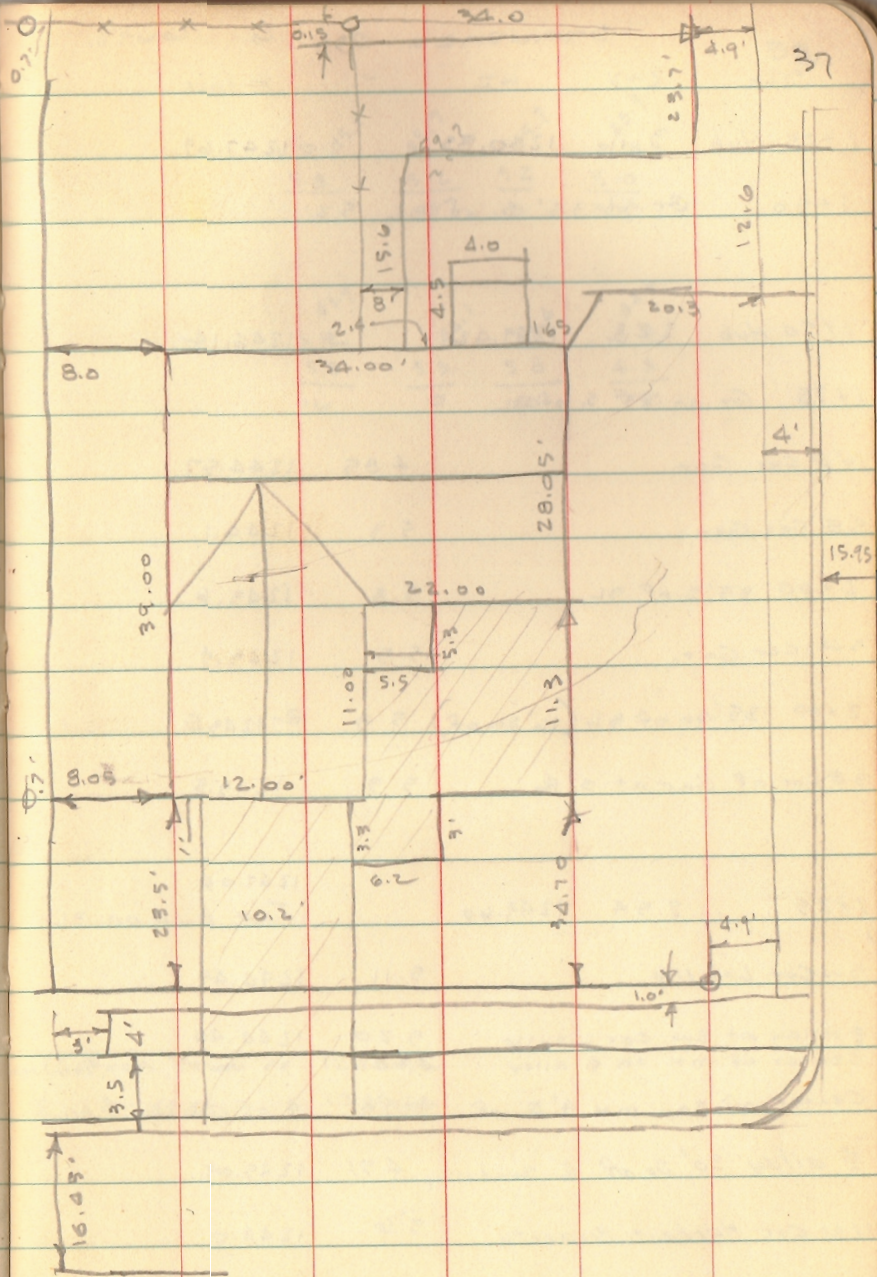

INDEXED ON MAP  
 9615