


Emma V. Hall Survey Bloomfield Township  
R 8 - T 7 Sec. 28



**INDEXED ON MAP**

Showing Witness To B

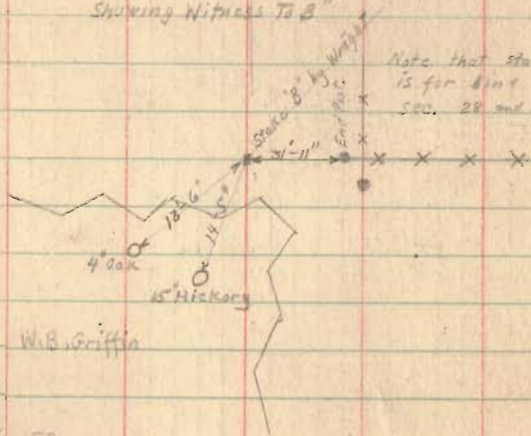


See Book 53  
and Box H in H<sub>2</sub>  
for 1906 Survey  
Box H<sub>1</sub> for 1924

43

May 16-1924  
Clear.

F. Wright

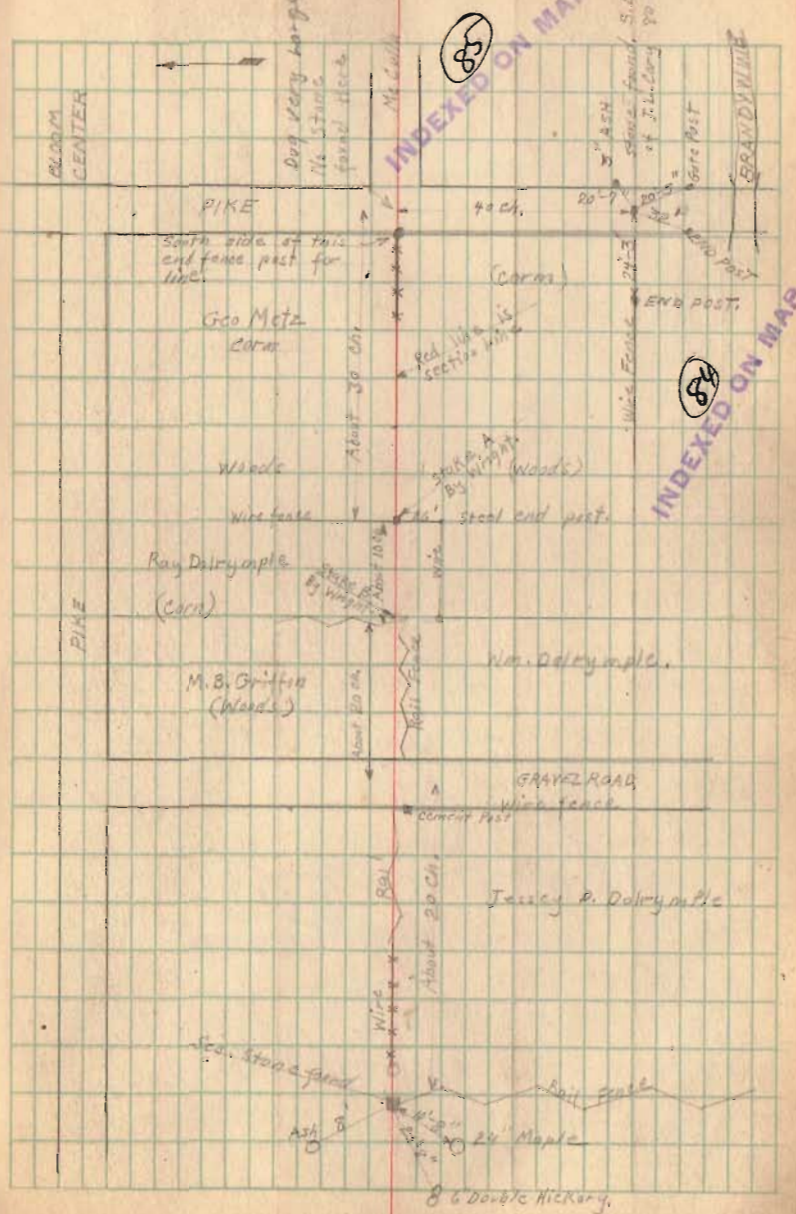

W.H. Luncheon