

264


E. R. Oak 15. 1D N 10 E 15 links. Hickory 6. 1D S 19 E 5 links.
 G. Bush 15. S 69 E 11 links. Ir. Wood. N 30 W 10 links.
 I. Ash 12. 1D. S 68 W 23 links. Elm 6. 1D N 48 E 35 links.
 H. R. Oak. 6. 1D N 89 W 41. Sugar 22. 1D N 80 E 47.5
 K. Bush & D. N 55.5 E 35 links. Ir. wood 3. 1D S 16 W 14 links.

I. corner of fraction. -

✓ Dark Hopkins Co. Land Co.

N. 360.

(9400)

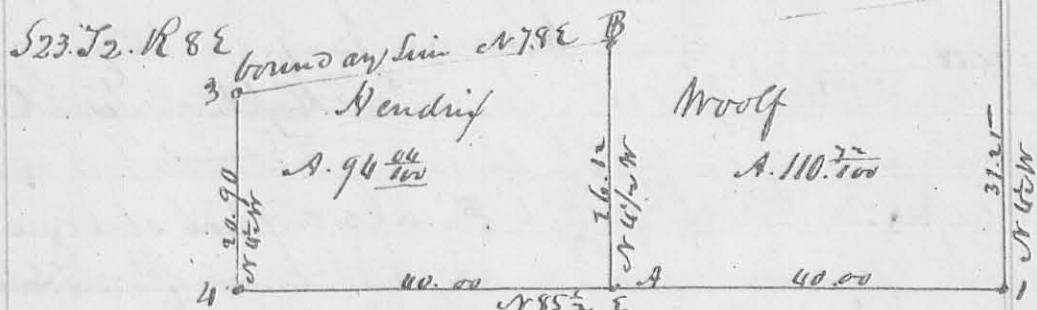

Description of corner at A. Bush 15. 1D N 12 W 23 links. Elm 22. 1D S 55 E 40 links.
 " B. Sugar 6. 1D S 53 W 6. 5. Hickory 2. 1D N 33 E 45 links.

at 1. 2. 3. 4. Origin at Section corner.

The foregoing Survey of S23-T2-R8E was made for Hendry & Wolf
 Jan'y 25. & 26. 1837.

✓ Dark Hopkins Co. Land Co.

Also at same time.

N 361

(8401)

Varying for James Person. the SW quarter of Section 28 T 5 S
 R 8 E. & divides the same as follows. Beginning at the South
 East corner of the same at an Elm 12. 1D S 53 W 10.
 links. thence N 30 W 33 ch. easterly a Creek to J. Dreierbach's
 S. E. corner. thence with his south line S 86° 10' W 39 ch. 80 links
 easterly a Creek at 6. 7. 310 ch. to the origin of quarter corner
 between S 28 T 2 S. a Beech S 61 W 40 L. Date 4 SD. No 3 E 25 links. thence
 S 35 E 38 ch. westerly to the SW corner of the same section. in the old
 boundary line. thence with said line N 78 E to the beginning
 The division line begins on the N. line of the quarter 19 ch 90
 links. from either corner at an Elm 8. 1D S 55 W 23 L. Beech W.
 W. N 68 E 45 links. thence S 35 E 35 ch. 62 link to sugar 2. 1D
 N 35.5 E 11 links. Beech 15. 1D S 10 E 21 links. in the boundary line.

✓ Dark Hopkins Co. Land Co.