

S.H. 579
(Old county Road No. 6)

10+00 Monument.

5+00 Monument.

1465

INDEXED ON MAP

Sec 12 T7 N8

Logan County

Stolby county

Large Spool Stone

25'-0" →

Jackson Center - New Bremen Road S.H. 579
Old Co. Road No. 6

Sec 13 T7 N8


March 31-1903
Clear - cold
Windy
No rain
Shade
Bitter
Cousins
Bridge

10

3-31-30

9

S.N. 579

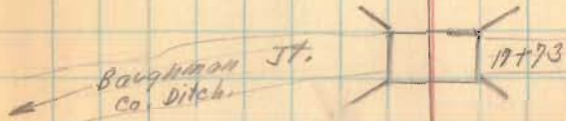

1465

INDEXED ON MAP

15 + 00 Monument.

S.H. 579,

29+00 Monument.

24+00 Monument.

Δ 23+40.4 0°-22' left.

21+00 Monument.

1465

INDEX MAP

3-7-30

10

old 1 Story Frame



Sec 7 T.7 R.8

1 1/2 story frame

30' x 50'

X X X X X 30' x 100'

8' cur

72.6
N. 22° E.

Co. Road # 23

← To Santa Fe

Stone 23+40.4

Co Road # 23

88.3
S. 55° W

98.3
S. 60° W.



S.N. 579

44+00 Monument

38+00 Monument

Δ 36+62 0°-00' Right

36+00 Monument

1465


INDEXED ON MAP

3-31-20

11



Barn

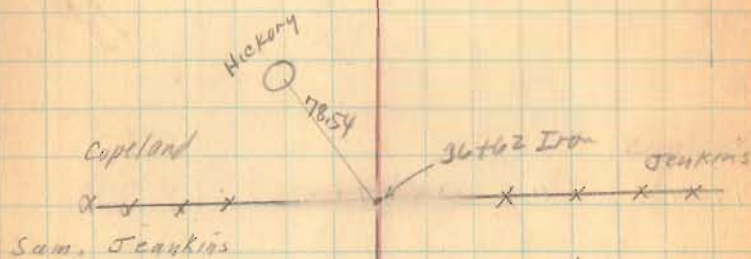

S.M. 579

56+00 Monument.

51+00 Monument.

49+84.8 0°-03' left.

49+00 Monument.


(1465)

INDEXED ON MAP

3-31-30

12


1 story
Frame.

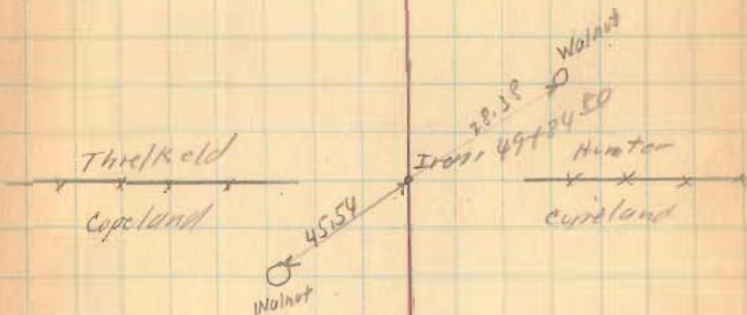

S.H. 579

9/1/00


Monument

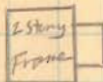

2 Story
Frame

6/1/00

Monument

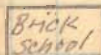

Brick
School

6/1/00

Monument



Shed

1465

3-31-30

14

S.H. 579

83+00 Monument


78+00 Monument

76+31⁶⁰ 0°-14' Right

75+00 Monument

(1865)

INDEXED ON MAP

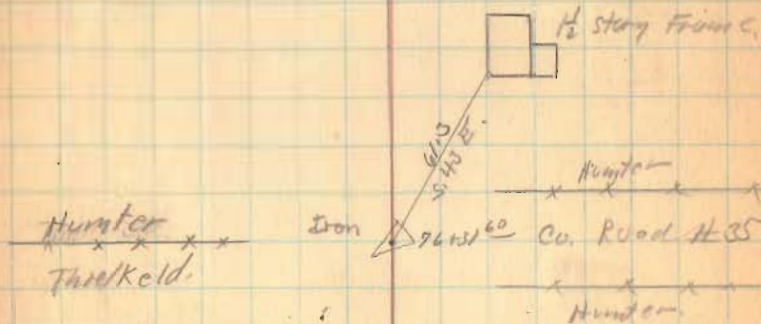

S.H. 579

3-31-20

15

Haver Co. Ditch

Hunter
x x x x 89160
Hunter

Briggs

H 89160

Hunter

89160 Monument

(1965)

INDEXED ON MAP

S.H. 579

114+00 Monument.

108+00 Monument

102+80²² No Angle.

102+00 Monument

97+00 Monument.

1465
INDEXED ON MAP

Wright

Co. Road # 53

Humber

Wright



Briggs

Hoover Co. Ditch

S.H. 599


124+00 Movement.

119+00 Movement.

116+06³⁰ No Angle.

April-1-1930
Cloudy Windy
Wing at
M^E Kink
Bair
Sgt to
Dredg.

17

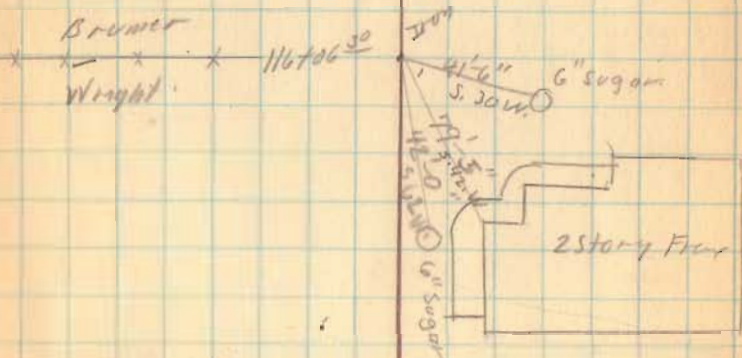

1465

INDEXED ON MAP

S.M. 579.



129+33³⁰ 0°-18' left.

127+00 Measurement.

(1465)
INDEX MAP

18

4-1-30

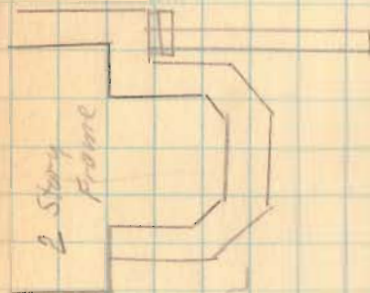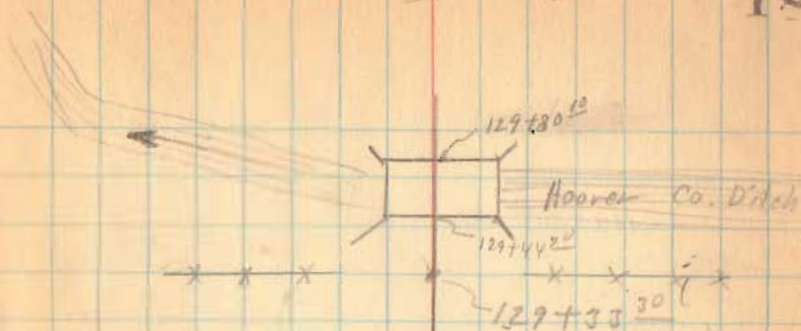

Measure

End

S.H. 579.


137+00 Monument.

132+00 Monument.

1465
INDEXED ON MAP

4-30

19

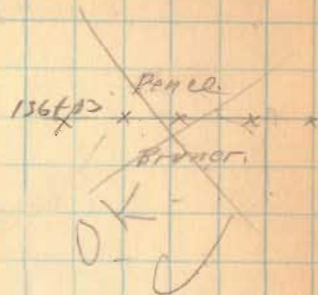

S.H. 579

149+00 Monument.

144+00 Monument.

142+70⁶⁰ 0°-05' Left

142+00 Monument.

146J

INDEXED ON MAP

4-1-30

20

End

Pence

x x x x

Brace

1 story
Frame

pena

Woods

~~pena~~

142+70⁶⁰ 0°-05' Left

x x x x

Stone

Penal

S.H. 579

165+00 Monument

159+00 Monument


152+00 Monument

1465

INDEXED ON MAP

4-1-30

21

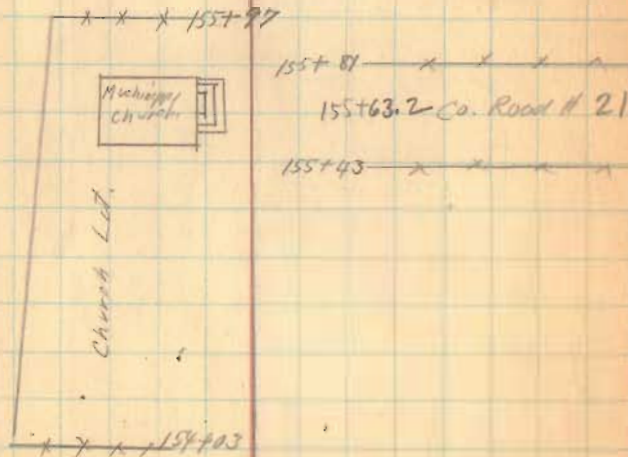


S.H. 579

192+00 Monument.

4-1-30

22

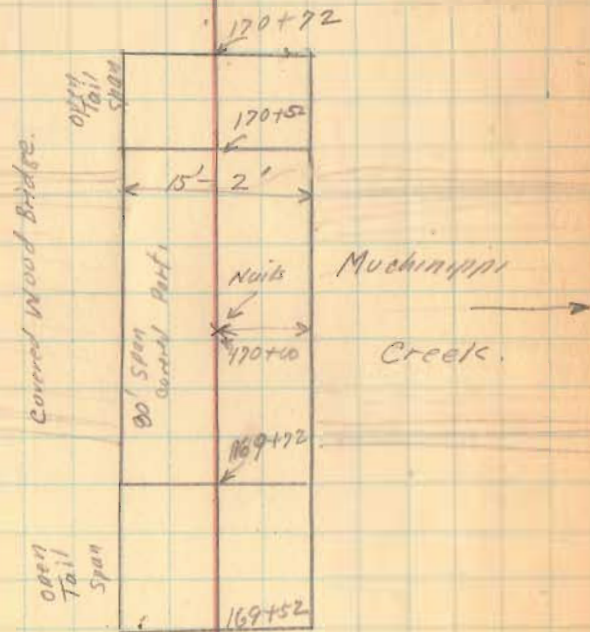

price

1465

INDEXED BY MAP

S.H. 579

April-2-1930

Fine Day

Wright


1930

Bridg.

Baird

Gossard

Shultz

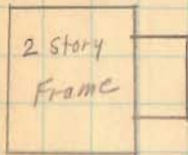

X X X
Co. Road. # 54

X X X

X X X
173764 & Co. Road. # 54

X X X

1974 Co. Monument

1465

INDEXED ON MAP

S.H. 579

187+00 Monument

182+79²⁰ No Angle

182+00 Monument

4-2-30

24

40.49 CH

1 1/2 story
Frame.

Lancaster.

X X X X

Wright.


182+79²⁰
LeSourd
Stone Pier
1/2" west
of present Pond
Line

1805

INDEXED ON MAP

S. H. 579.

203+00 Monument.

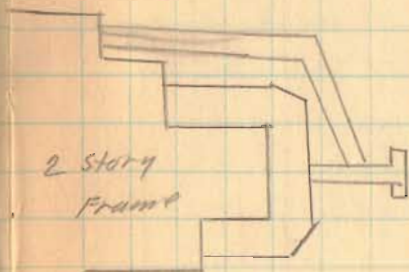

197+00 Monument

(curric)

Ins Co.

x x x x x
Lancaster

sta 195+94 No Angle
state

192+00 Monument.

1465

S.H. 579

218 + W Monument

213 + W Monument


1465

INDEXED ON MAP

208 + W Monument

4-2-30

26

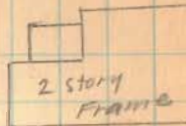

Mallon.

x x x x x

Wright.

Wright.

x x x

Ins. Co.

Wright.

x x x


209 + 52 Le. Sauter.
No Angle

S.H. 579

4-2-30

97

228+00 Monument.

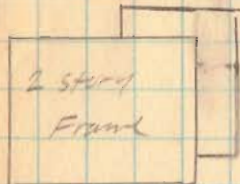

223+00 Monument

222+62³⁰ 0°-19' Right.

222+62³⁰
old stake
Woods
Wright

222+00 Monument

1465
INDEXED ON MAP

S.H. 579

243+00 Monument

237+00 Monument

225+90⁵⁰ 0°-05' Left.

235+00 Monument.

1465

INDEXED ON MAP

4-2-30

22

2 story
Frame

2d/c.

X X X X X

Mullon

235+90⁵⁰

section line

S.H. 579

248+00 Monument.

247+00 Monument

1465

INDEXED ON MAP

4-2-30

29


• 247+50 Road 3/4" Iron
0-24' Left

1 story
Frame

S.H. 529

253+00 Monument.

1465
INDEXED ON MAP

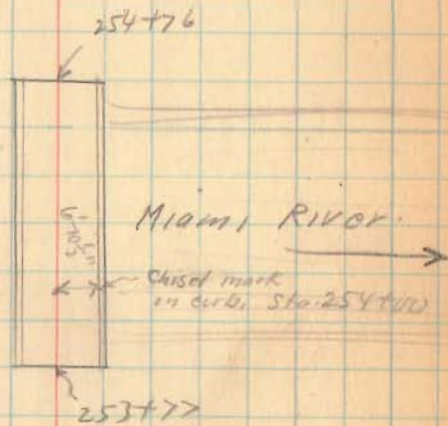

S.H. 579

266 T10

260 T10

(146)

INDEXED ON MAP

4-2-30

31

267 T07

267 T07
State Route 69

Miles
 $26707' = 51.05814$

~~X X X X 262 T03~~

Ed/c