

Road 60 Bloomfield Twp.

60' - Commis Journal Vol. 5 Page 97
" 5 " 183

stakes Placid on Life Ins co.
land. 25' N. of E.

45' Smith & Trout Pike. 1876

1865

INDEXED ON MAP

July 1-1935
cloudy
E. Wind Mt.
E. Cor.

16

1/2 Story Frame


The Mutual Benefit
Life Insurance Co

2 story Frame

Grace Knott

Geo. Metz

Jessie Darling

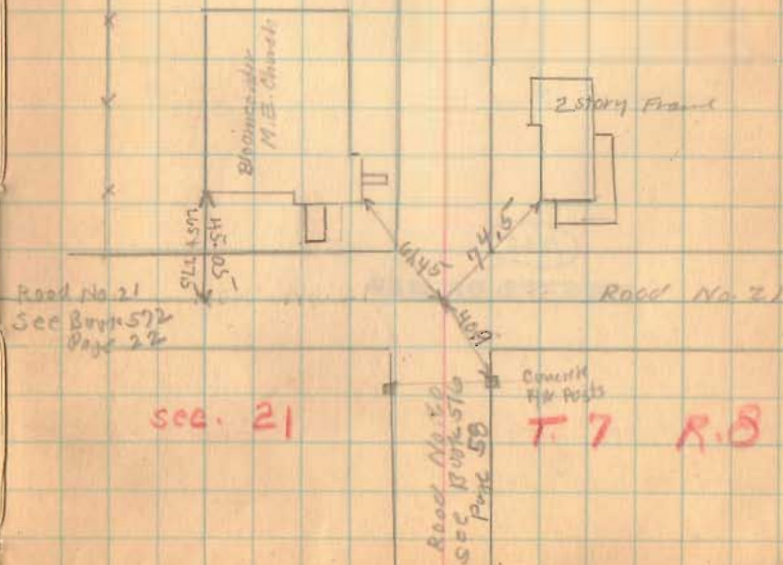

Road 60

1665
INDEXED ON MAP

9-1-75

17

↑ ↑ ↑
Haron Rex



↑ ↑ ↑ ↑

↑ ↑ ↑
The Mutual Benefit
Life Insurance Co.

↑ ↑ ↑
old church
lot

↑ ↑ ↑
Mr. Wobler

↑ ↑ ↑
The Mutual Benefit
Life Insurance Co.

Road 60


71-35

18

SEC. 20 T. 7



SEC. 21 T. 7

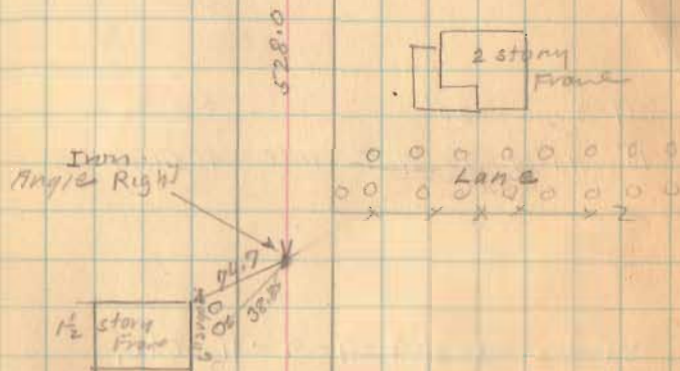

1665

INDEXED ON MAP