


208 Ct. Blue Ash to 6<sup>th</sup> NW 35. Map to 10<sup>th</sup> 133 E 25 links -  
 Benj<sup>r</sup> Ellis, George Hill ch. men Dan Hopkins Sur. D. C.  
 Nov. 20. 1835

N<sup>o</sup> 258. S 22<sup>o</sup> 1/2 R 8 E

(8337)

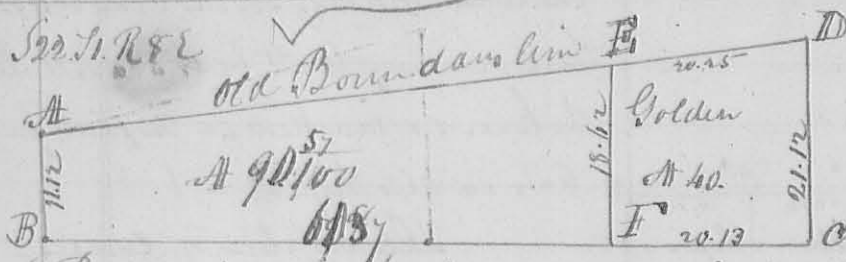

This plot represents the Survey & Sub. division of S 22<sup>o</sup> 1/2 R 8 E. for Edward Timmons, as follows.

Beginning at the NW corner of the section. At old original corner down marked Ironwood 4 ch. ds. N 75<sup>o</sup> 13<sup>o</sup> E links, and Elm 30 P 81<sup>o</sup> E 9 links, then S 4 E 11.12 to the SW corner, the bearing tree down, then N 85<sup>o</sup> 3/4 E 81.00 to Red corner, bearing tree, tree down, then N 4 W 21.12 to Back of 10<sup>th</sup> corner tree, as the boundary line, then with said line by 8 W to beginning, containing 130.37 acres. then cut off from east end of the foregoing survey, 40 acres for Golden. Begin at F. S 85<sup>o</sup> 3/4 W 20 ch. 12 links, from NE corner the section at a Back 10<sup>th</sup> N 68<sup>o</sup> E 28 links, 4 White Oaks 6<sup>th</sup> 1/2 186<sup>o</sup> W 27 links, then N 4 W 18.62 ch. to an Elm 24<sup>th</sup> 1/2 N 6 W 43 links, Swamp ash 20<sup>th</sup> 1/2 S 6 E 64 links, on the old boundary line -  
 Nov. 21. 1835  
 Dan Hopkins, D. C. Surveyor

N<sup>o</sup> 259

(8338)

Surveyed Dec. 10<sup>th</sup> 1834 for Mrs Rogan, the west half of the NW 1/4 of 15<sup>th</sup> 1/2 S. of R 8 E. Lewis & Resend Beginning at the original post on the west line of the section, then N 86<sup>o</sup> 10' E 20 ch. 12 links, to Back 15<sup>th</sup> 1/2 N 77<sup>o</sup> E 9 links, and a Beech 17<sup>th</sup> 1/2 1/2 E 44 links, then S 35<sup>o</sup> E 40<sup>o</sup> 25 links, crossing the creek at 29 ch. to Gray Ash 8<sup>th</sup> 1/2 140<sup>o</sup> W 2 links, Beech Eye 4<sup>th</sup> 1/2 133<sup>o</sup> E 12 links, then S 86<sup>o</sup> 10' W 20 ch. 12 links to the SW corner of the section, then N 3<sup>o</sup> 50' W 40 ch. 25 links, to the beginning (an Ironwood 10<sup>th</sup> 1/2 133<sup>o</sup> W 3 links, Red Elm 6<sup>th</sup> 1/2 158<sup>o</sup> E 22 links) containing 81. 3/4 acres.

H. Hopkins }  
 and Rogan } ch. men

Dan Hopkins, D. C. Surveyor

N<sup>o</sup> 260

(8141)

Surveyed Dec. 12<sup>th</sup> 1834 for Bowyer & Sigell part of line of 079950 Beginning at 2 White Oaks & Ash, N. E. corner to land surveyed by Mr Bowyer to John Harrod then N 12 W 22 poles, to 2 W. O. Sugar & Logwood, then N 7 E 42 1/2 poles, to 3 White O., then N 12 W 86 1/2 poles, to 2 White Oaks, then S 78 W 162 1/2 poles, crossing a Big road at 12. & branch at 126 poles, to a stake in a prairie in the west