


Survey W. N. Grabel.

In survey 9890. Rushcreek Tp.
September 7, 1911.

F. L. Williams }
I. B. Phillips } Chainmen.

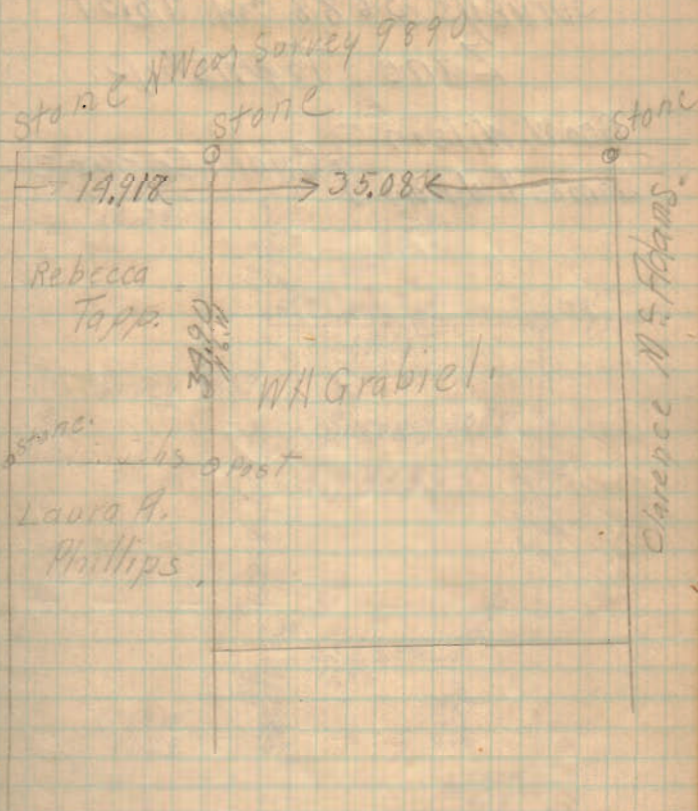

214