

The following described lands situated in Bokescreek Township, Logan County, Ohio, and in Virginia Military Survey 9891 and being all the lands now owned by William F. Bayliss and Joseph H. Bayliss in said survey.

Bounded and described as follows:

Commencing at a stone in the south line of the lands of Addison D. Male and at the north-east corner of the lands of Henry C. McGinnis;

Thence N. 81 E. with the south line of said Males land 137.2 rods to a stake;

Thence with the west line of Lewis Clarks land S. 9 E. 52.9 rods to the south-west corner thereof;

Thence with the said Clarks south line N 81 E. 38 rods to the north-west corner of Henry Hughes (at/al) land.

Thence S. 9 E. with said Hughes west line to the north-east corner of Elizabeth McGinnis' land.

Thence with the said McGinnis' north line S. 81 W. 75.8 rods to the north-west corner thereof;

Thence S. 9 E. 12.16 rods to the center of the Flatwoods' pike;

Thence with the said pike S. 81 W. 78.4 rods to the south-east corner of Henry C. McGinnis' land;


Thence with the said McGinnis' east line N. 9 W. 41.1 rods to a stake;

Thence S. 81 W. 22.22 rods to a stake;

Thence N. 9½ W. 62.9 rods to a stone, the place of beginning ⁹

Containing 86.80 acres.

Addison
Male.

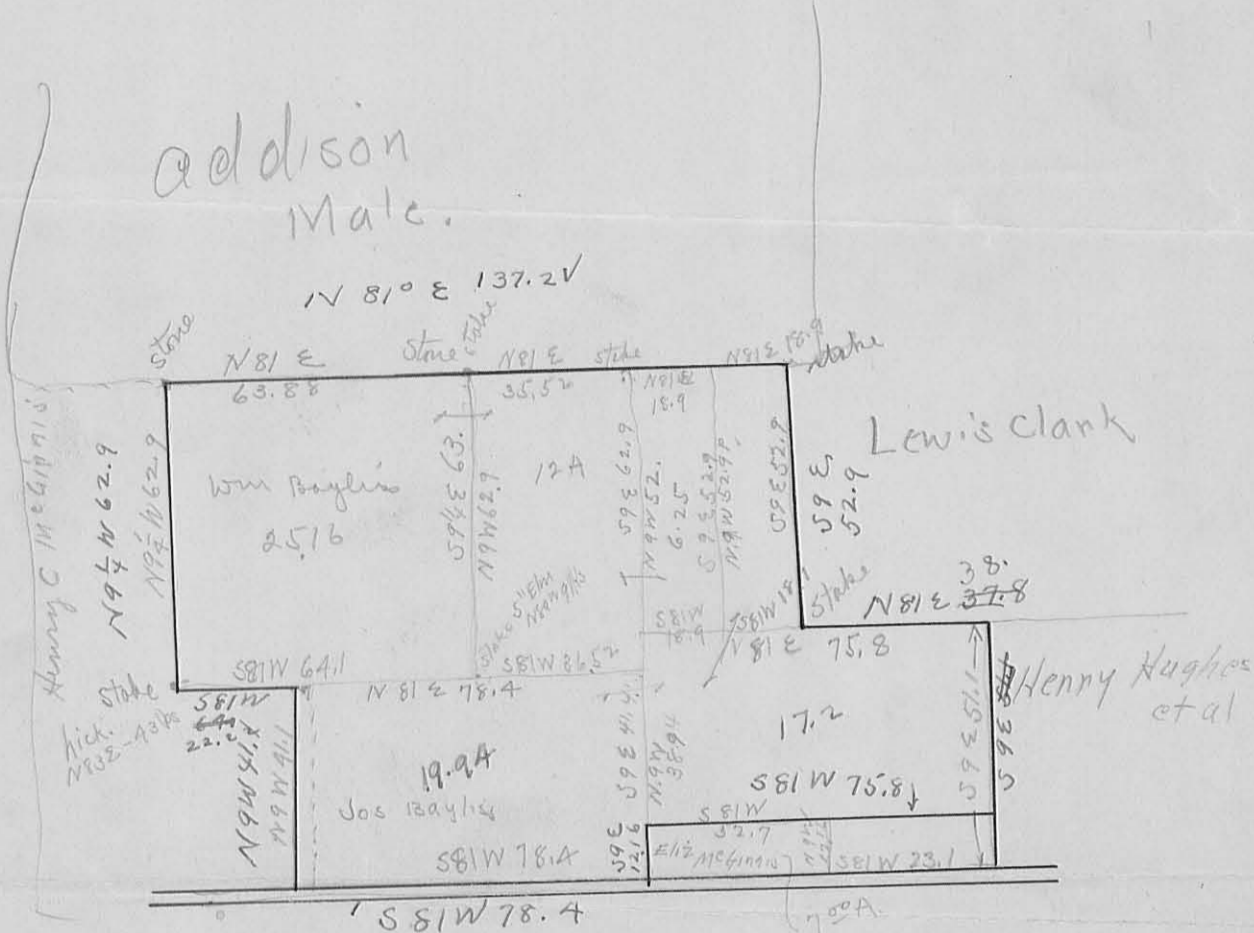

12.5
12.0
25.16
19.94
17.20

86.80

24.2
7

INDEXED ON MAP

538 1P

Baylies survey
B. B. B. B. B.
V. M. S. 9 2 9 1