


Benj Fisher Survey
Dokes Creek Tp.

(844) 1P

INDEXED ON MAP

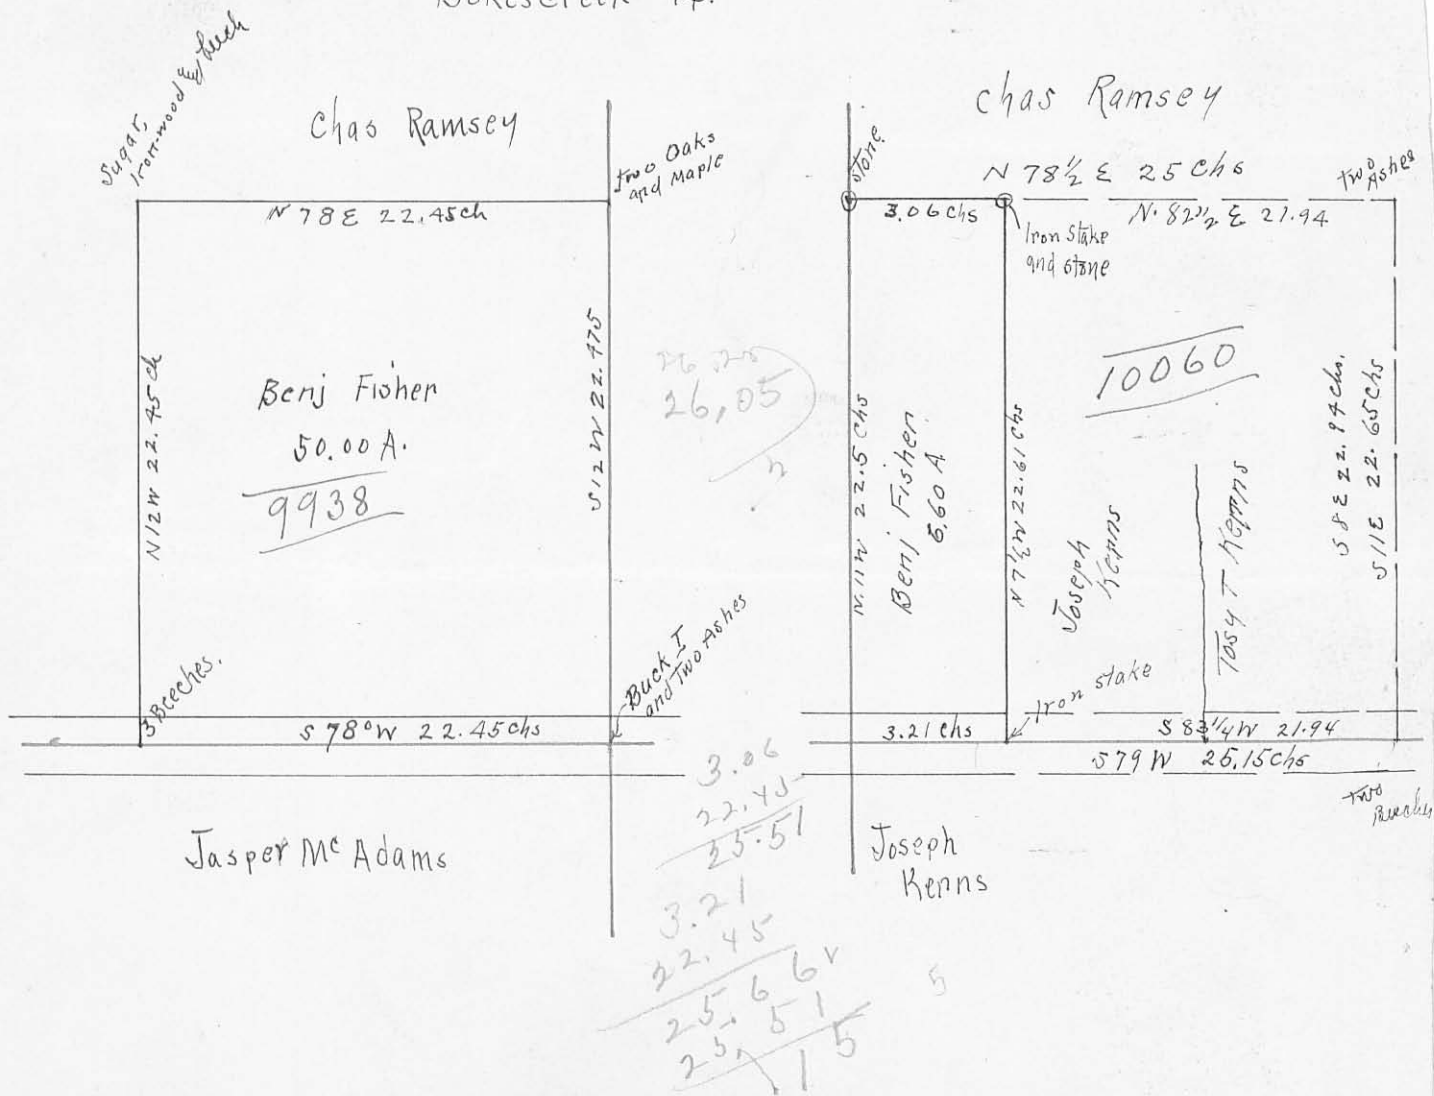

Stakes
Ironwood & Birch

Two Oaks
and Maple

stone

Two Pines

N 1/2 W 22.45 ch

N 78 E 22.45 ch

S 1/2 W 22.475

Benj Fisher
50.00 A.
9938

26.20
26.05

N 78 1/2 E 25 chs

3.06 chs

Iron Stake
and stone

N 82 1/2 E 21.94

N 1/2 W 22.5 chs

Benj Fisher
5.60 A.

N 7 1/2 W 22.61 chs

Joseph
Higgins

Tosy T Higgins

S 8 E 22.97 chs

S 1 E 22.65 chs

3 Birches.

Buck I
and Two Pines

S 78° W 22.45 chs

3.21 chs

Iron stake

S 83 1/4 W 21.94

S 79 W 25.15 chs

Jasper Mc Adams

Joseph
Kennis

Two
Birches