


FB 689

CH #26 - stakes for
Telephone line

C. E. Keyser
D. Dawson
V. Detrick
D. South

April 14, 1950
Snow 44

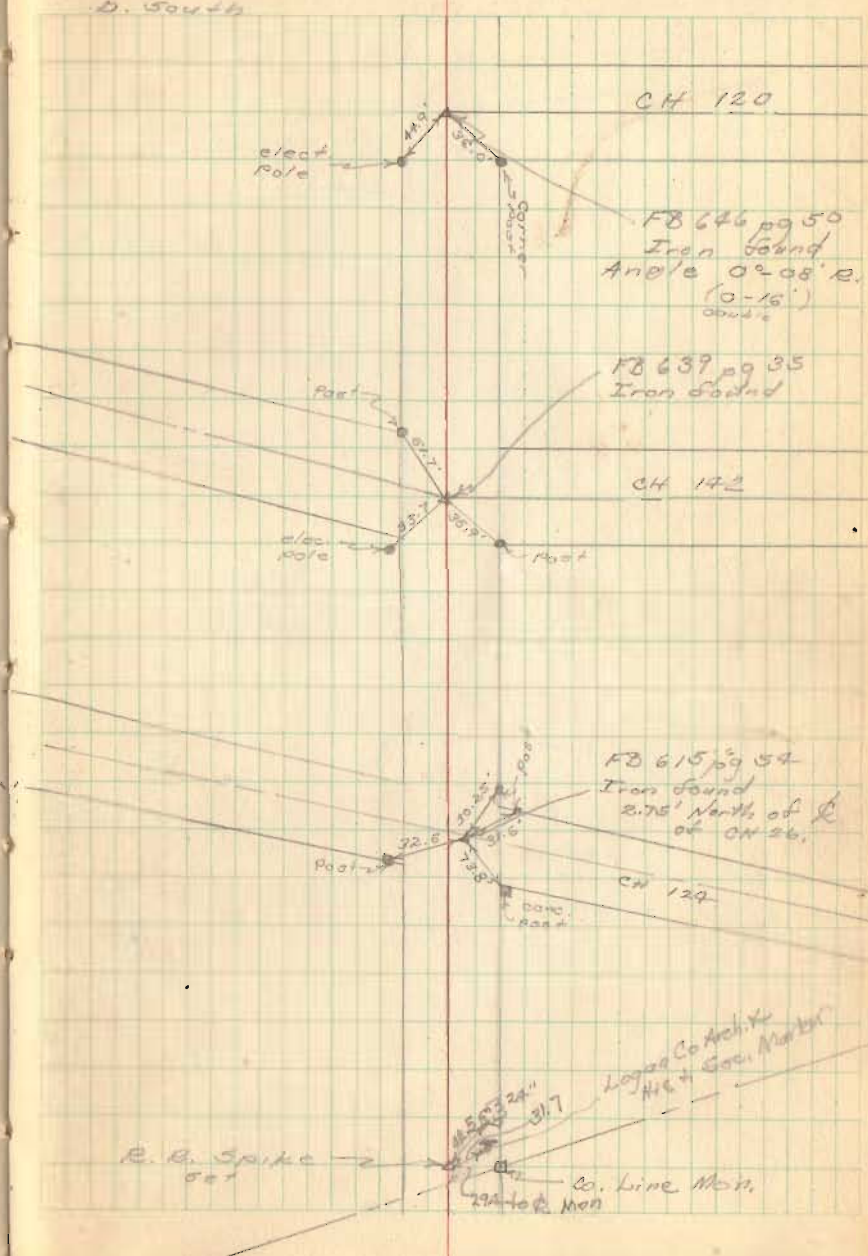

2061 INDEXED ON MAP

FB 689

C.H. # 26 (contd)

M.E. Church

April 17, 1920

45

