FREDERICK SURVEY September 22, 1973

The following described real estate situated in Virginia
Military Survey No. 9958, Bokescreek Township, Logan County, Ohio
and being more particularly described as follows:


Beginning at an iron pipe in the intersection of C.R.117 with S.R.292; thence with said S.R.292 N.7°23'W. 661.85 feet to an iron bar in a westerly corner of Hazel Parsons' 47.15 acre tract; thence with said Parsons' line N.83°02'E. 175.0 feet to an iron bar; thence S.7°23'E. 661.80 feet to an iron bar in the centerline of C.R.117; thence with said road N.83°00'W. 175.00 feet to the place of beginning.

Containing 2.66 acres more or less.

The above described 2.66 acres being on the west side of Robert C. Frederick's 9.75 acre tract.

I hereby certify that the above is a true and accurate description of a survey made by me.

Leslie H. Geeslin Reg. Surveyor 5248

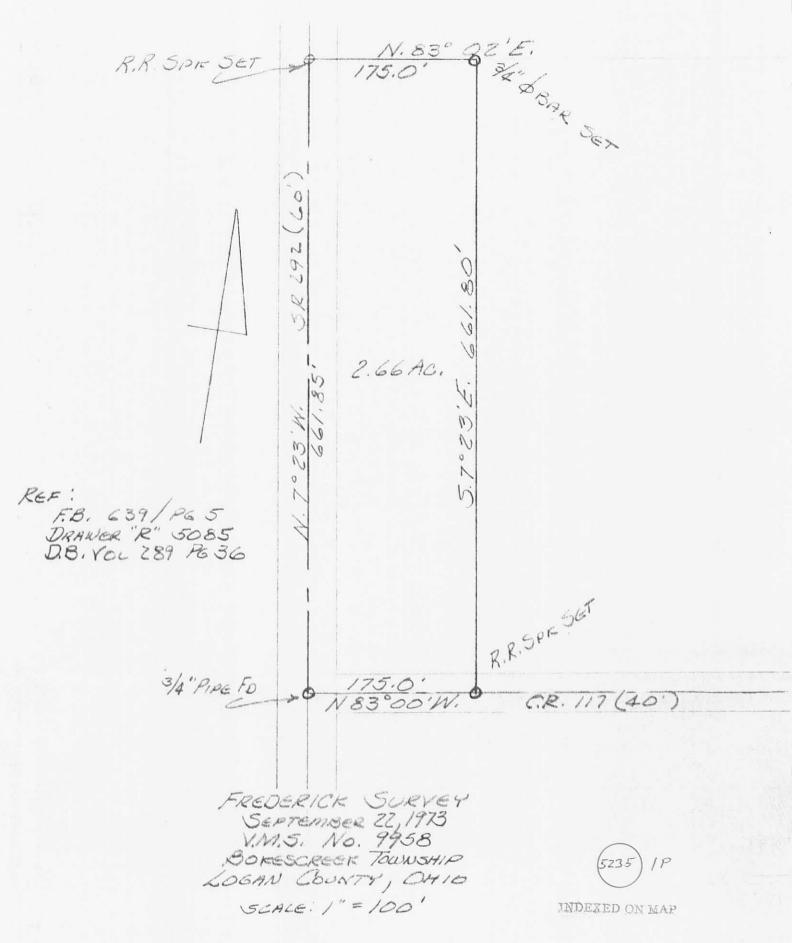

LESLIE H. GEESLIN REG. SURVEYOR 5248

41 . .