

Received 12-9-86 Ok (C.R.)

SOLT TO MOUSER SURVEY

The following described real estate situated in the Township of Bokescreek, County of Logan, State of Ohio and being a part of Virginia Military Survey No 10060 and being more particularly described as follows:

Beginning at a stone found at the northwest corner to W. E. Solt Farms, Inc. 67.290 Acre tract as described in Official Record Volume 16 Pages 351-353 (3-18-1986) and being the northeast corner to R. & B. Mouser Farms, Inc. 164.13 Acre tract as described in Official Record Volume 17 Pages 821-822 (4-16-1986) and being in the centerline of C. H. No. 117 and also being the north line of V. M. S. No. 10060;

Thence with the centerline of C. H. No. 117 and the north line of V. M. S. No. 10060, N. 82° 58' 54" E. 365.90 feet to a R. R. Spike set (Note: This line is the basis of bearing for this survey);

Thence S. 40° 25' 54" W. 491.06 feet to an 5/8" x 30" Rebar set in the west line of Solts' farm and the east line of Mousers' farm; passing through an 5/8" x 30" Rebar set at 40.72 feet;

Thence with the line between Solt and Mouser, N. 7° 44' W. 332.10 feet to the place of beginning, containing 1.395 Acres, more or less.

Of the above described tract, there is 0.24 Acres in the right of way of C. H. No. 117.


I hereby certify that this is a true and accurate description of a field survey made by me on December 6, 1986 of the above described tract which is out of the northwest corner of W. E. Solt Farms, Inc. present 67.290 Acre tract as recorded in Official Record Volume 16 Pages 351-353 (3-18-1986) and being Permanent Parcel No. 05-027-00-00-034.

Daniel E. Gilbert

Daniel E. Gilbert, P.S.
Reg. Sur. No. 5402
400 N. Park St.
Bellefontaine, Ohio 43311
513-593-1428



INDEXED ON MAP
7581 1D

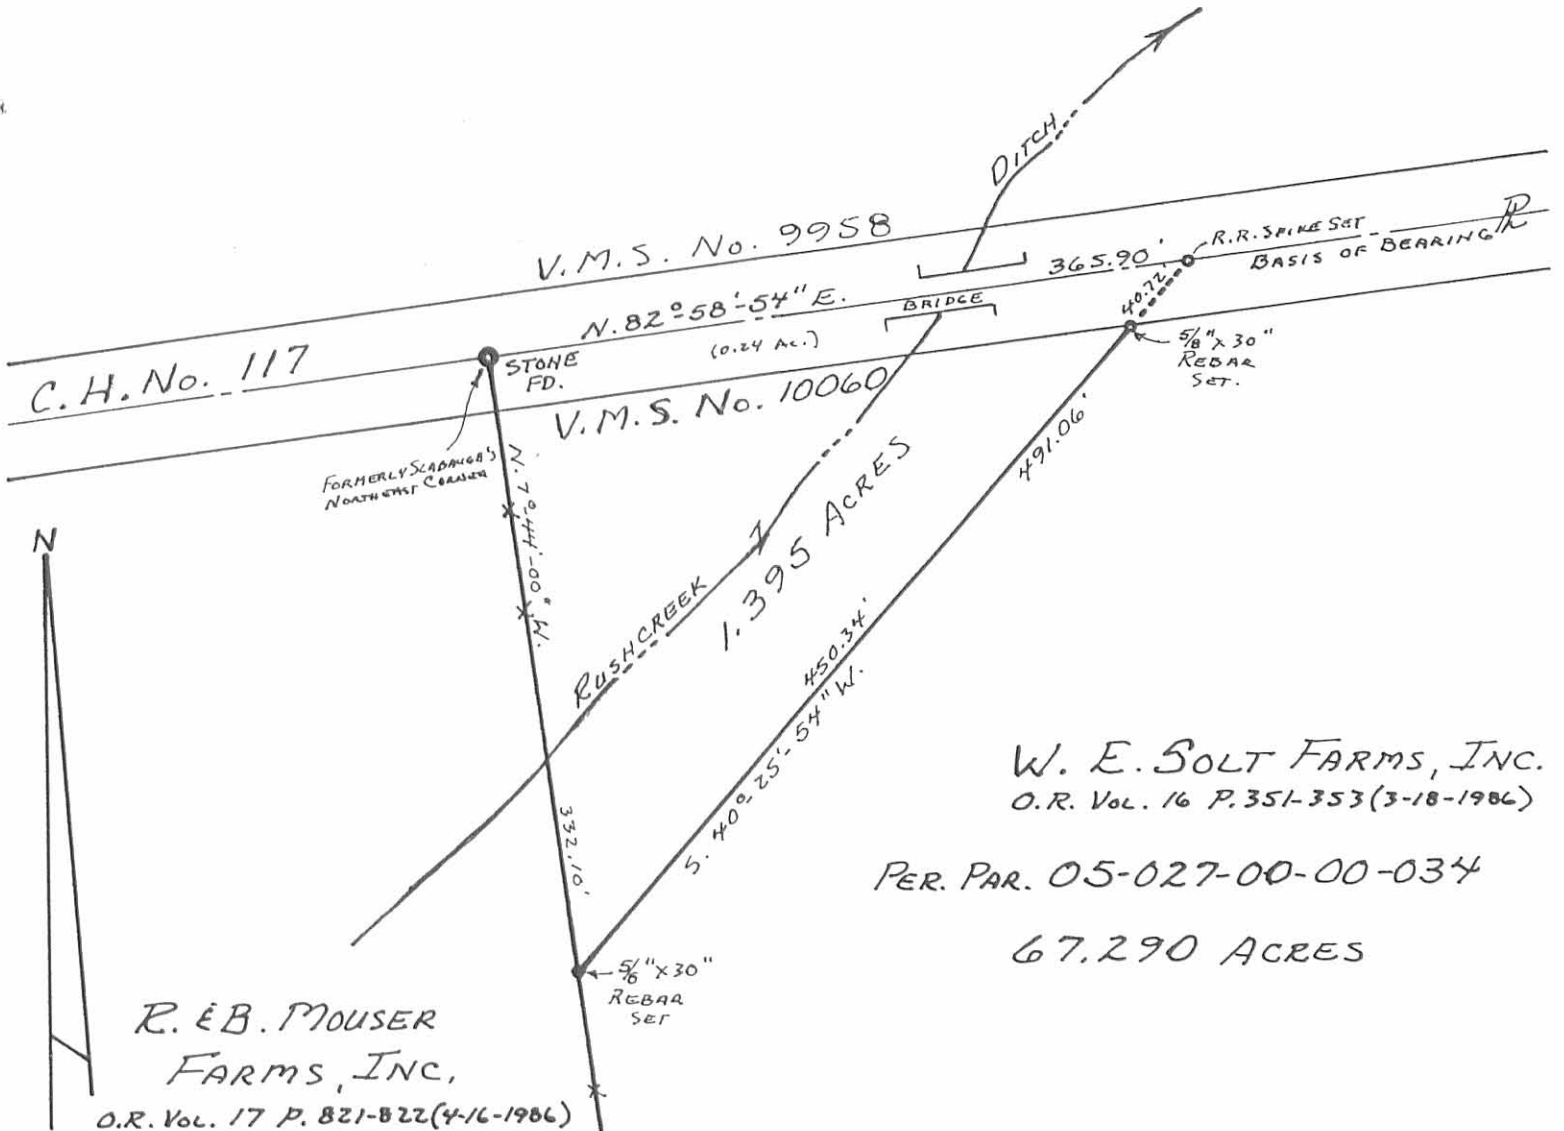

W. E. SOLT FARMS, INC.
O.R. Vol. 16 P. 351-353 (3-18-1986)

PER. PAR. 05-027-00-00-034

67.290 ACRES

R. E. B. MOUSER
FARMS, INC.

O.R. Vol. 17 P. 821-822 (4-16-1986)

PER. PAR. 05-041-00-00-008

164.13 ACRES



Daniel E. Gilbert

DANIEL E. GILBERT, P.S.
REG. SUR. No. 5402
400 N. PARK ST.
BELLEFONTAINE, OHIO 43311
513-593-1428

SOLT TO MOUSER
SURVEY
V.M.S. No. 10060
BOKESCREEK TOWNSHIP
LOGAN COUNTY, OHIO
DECEMBER 6, 1986

INDEXED ON MAP
75811P

SCALE: 1" = 100'

086-031