

Received 7-8-3  
O & GCH

LESLIE H. GEESLIN  
REGISTERED SURVEYOR NO 5248  
P. O. BOX 274  
RUSHSYLVANIA, OHIO 43347

TELEPHONE: (513) 468-2793

RICHARDSON SURVEY

July 2, 1993

The following described real estate situated in the State of Ohio, County of Logan, Township of Bokescreek, being part of Virginia Military Survey 9958 and more particularly described as follows:

Beginning at a cap and nail set in the centerline of Township Road 117 at the southeast corner of the Early Cemetary said cap and nail being N.  $81^{\circ} 07' 00''$  E. 1356 feet from the intersection of said centerline with the east line of the T. & O. C. Railroad.

Thence with the east line of said cemetary N.  $2^{\circ} 34' 17''$  E. 142.58 feet to a 3 inch steel post found.

Thence N.  $4^{\circ} 05' 16''$  W. 465.50 feet to a 5/8 inch iron bar set.

Thence S.  $86^{\circ} 06' 17''$  W. 104.78 feet to a 5/8 inch iron bar set.

Thence N.  $5^{\circ} 27' 20''$  W. 121.92 feet to a 5/8 inch iron bar set.

Thence N.  $64^{\circ} 17' 26''$  E. 79.41 feet to a 5/8 inch iron bar set.

Thence N.  $6^{\circ} 31' 47''$  W. 167.41 feet to a 5/8 inch iron bar set.

Thence N.  $80^{\circ} 27' 22''$  E. 188.01 feet to a 5/8 inch iron bar set.


Thence S.  $71^{\circ} 50' 50''$  E. 77.63 feet to a 5/8 inch iron bar set.

Thence N.  $80^{\circ} 21' 48''$  E. 158.18 feet to a 5/8 inch iron bar set.

Thence S.  $5^{\circ} 02' 15''$  E. 151.95 feet to a 5/8 inch iron bar set.

Thence S.  $85^{\circ} 12' 10''$  W. 211.54 feet to a 5/8 inch iron bar set.

Thence S.  $55^{\circ} 26' 06''$  W. 57.01 feet to a 5/8 inch iron bar set.

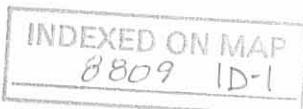

Thence S.  $22^{\circ} 44' 59''$  W. 119.12 feet to a 5/8 inch iron bar set.

Thence S.  $12^{\circ} 30' 52''$  W. 87.16 feet to a 5/8 inch iron bar set.


Thence S.  $4^{\circ} 07' 30''$  E. 551.71 feet to a cap and nail set in the centerline of Township Road 117.

Thence with said centerline S.  $81^{\circ} 07' 00''$  W. 55.73 feet to the place of beginning.

Containing 2.749 acres more or less of which 0.037 acre is in the right-of-way of Township Raod 117.

The above described 2.749 acre tract being part of Sara Richardson's 228.41 acre tract as described in D. B. Vol. 383 page 388.


Bearings are based on an assumed bearing (S.  $81^{\circ} 07' 00''$  W.) for the centerline of Township Road 117 as established from F. B. 639 Page 13 in this field survey by Leslie H. Geeslin, Reg. Surveyor 5248 on July 2, 1993.

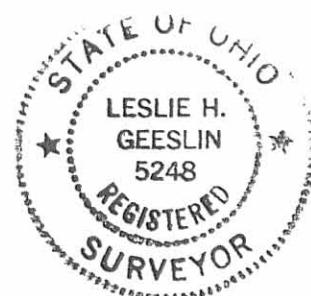

*Leslie H. Geeslin*

SARA RICHARDSON  
228.41 AC  
D 3 VOL. 383 PG 388

S. 71°50'50"E  
77.63'

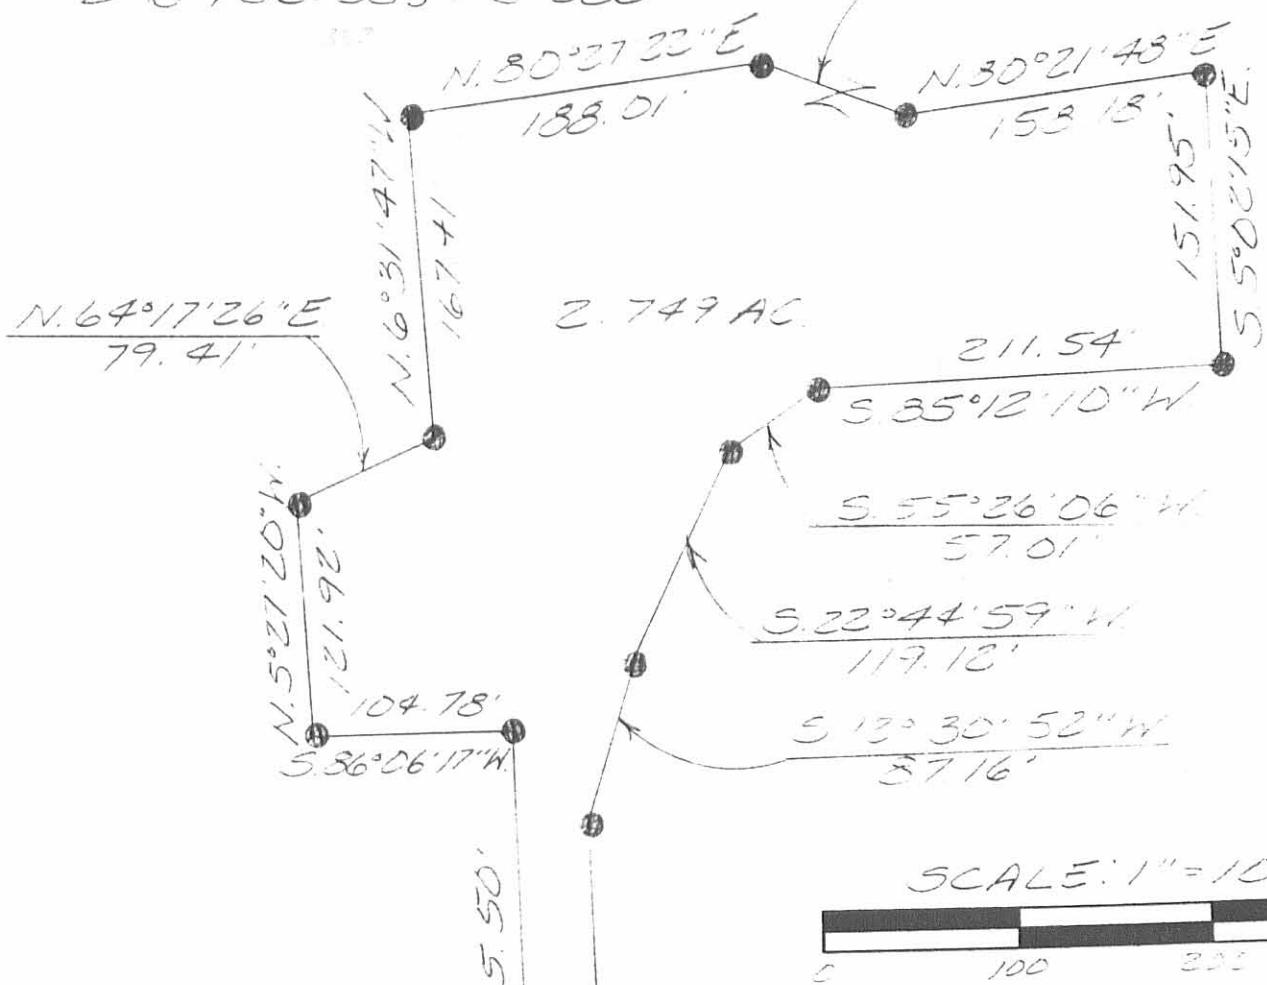

SURVEY OF 2.749 ACRES  
OUT OF 228.41 ACRES IN  
VIRGINIA MILITARY SURVEY  
9953, BOKESCREEK TOWNSHIP,  
LOGAN COUNTY,  
OHIO FOR SARA RICHARDSON  
JULY 2, 1993

