



Main St. De Graff  
NS H.I. -S ELEV

B.M. Iron Post old School Yard  
1008.71

Apparent  $\Phi$  used. No transit work

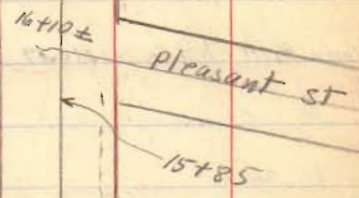

Witness to  
Iron from  
Book 516  
Page 63

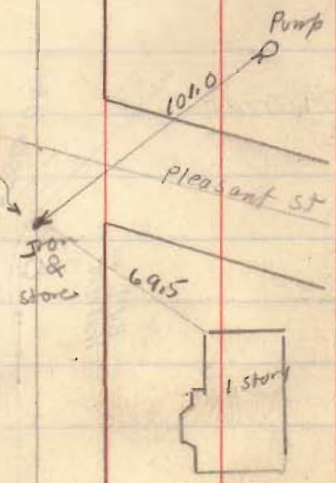

4429

Sec. 7 T. 2 R. 14

Miami St.

Sec. 12 T. 3 R. 13

