

Hooley Survey Description
November, 1973

Being situated in the Village of DeGraff, and in Miami Township, Logan County, Ohio; and being a part of Section 12, Town 3, Range 13, and being a part of Village Lot 73 that is described as follows:

Beginning at a chiseled cross in the sidewalk at the northeast corner of Village Lot 73.


Thence with the east line of Village Lot 73 (also the west line of Main Street) S $25^{\circ} - 00'E$ 22.0 feet to a chiseled cross in the sidewalk.

Thence parallel with the north line of Lot 73 S $64^{\circ} - 19'W$ 60.0 feet to a chiseled cross in concrete.


Thence N $25^{\circ} - 00'W$ 22.0 feet to a iron in the north line of Lot 73 (also the south line of a 16.5 foot alley).

Thence with the north line of Lot 73 (the south line of the alley) N $64^{\circ} - 19'E$ 60.0 feet to the place of beginning.

Owen K. Shirk
Surveyor 4271

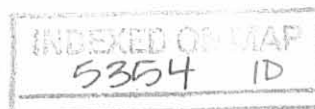

HOOLEY SURVEY - LOT 73 - DEGRAFF
MIAMI TOWNSHIP, LOGAN CO., OHIO
SECTION 12, TOWN 3, RANGE 13 - CHISELED

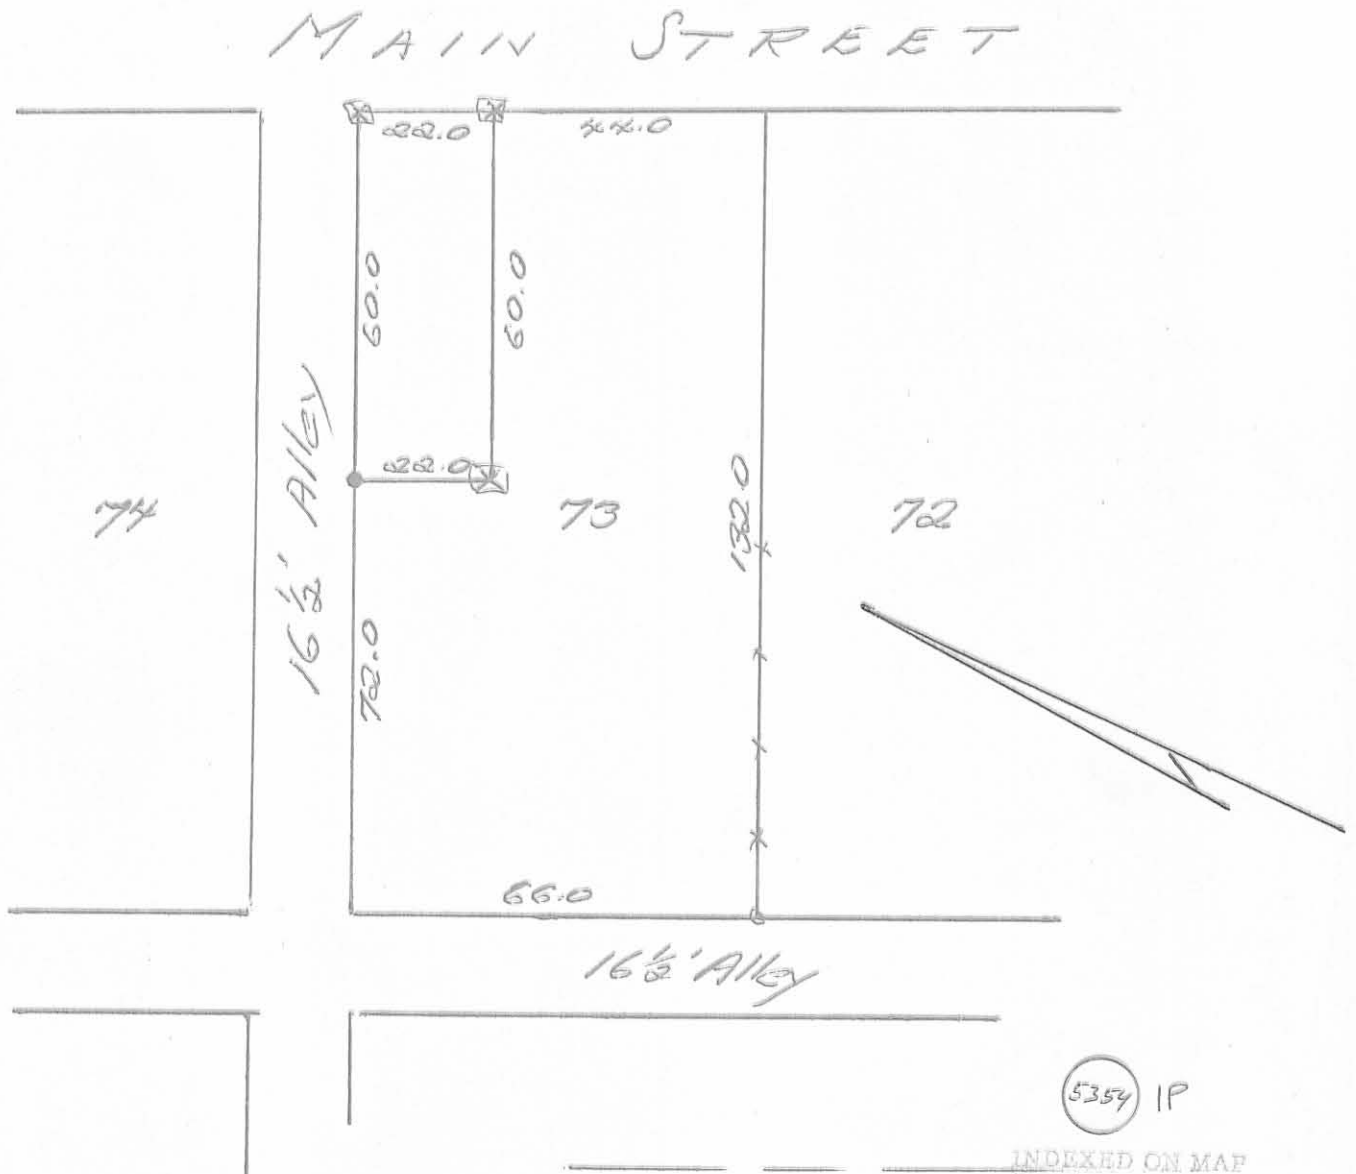

INDEXED ON MAP

Owen K. Stirk
Surveyor 4271
11-17-73