

Smith Description
December, 1975

Being situated in the Village of DeGraff, and in Miami Township,
Logan County, Ohio; and being a part of Section 6, Town 3, Range 15.

Beginning at the point of intersection of the centerline of
State Route 508 with the west line of Section 6.

Thence with the west line of Section 6 S $5^{\circ} - 18'$ W 446.4 feet
to an iron.

Hence N $52^{\circ} - 40'$ E 302.5 feet to the center of State Route 508,
passing thru an iron at 272.5 feet.


Thence with the center of State Route 508 N $37^{\circ} - 20'$ W 328.3
feet to the place of beginning.

Containing 1.08 acres in the corporation of DeGraff and 0.06
of an acre outside the Corporation for a total of 1.14 acres more
or less. The Auditor carries this as 0.95 of an acre in the
Corporation of DeGraff and 1.13 acres outside the Corporation.


Owen K. Shirk
Surveyor 4271


INDEXED ON MAP
5847 ID

SMITH SURVEY - DE GRAFF
 MIAMI TWP., LOGAN CO., OHIO
 SEC. 6, T-3, R-13 - 1" = 100'

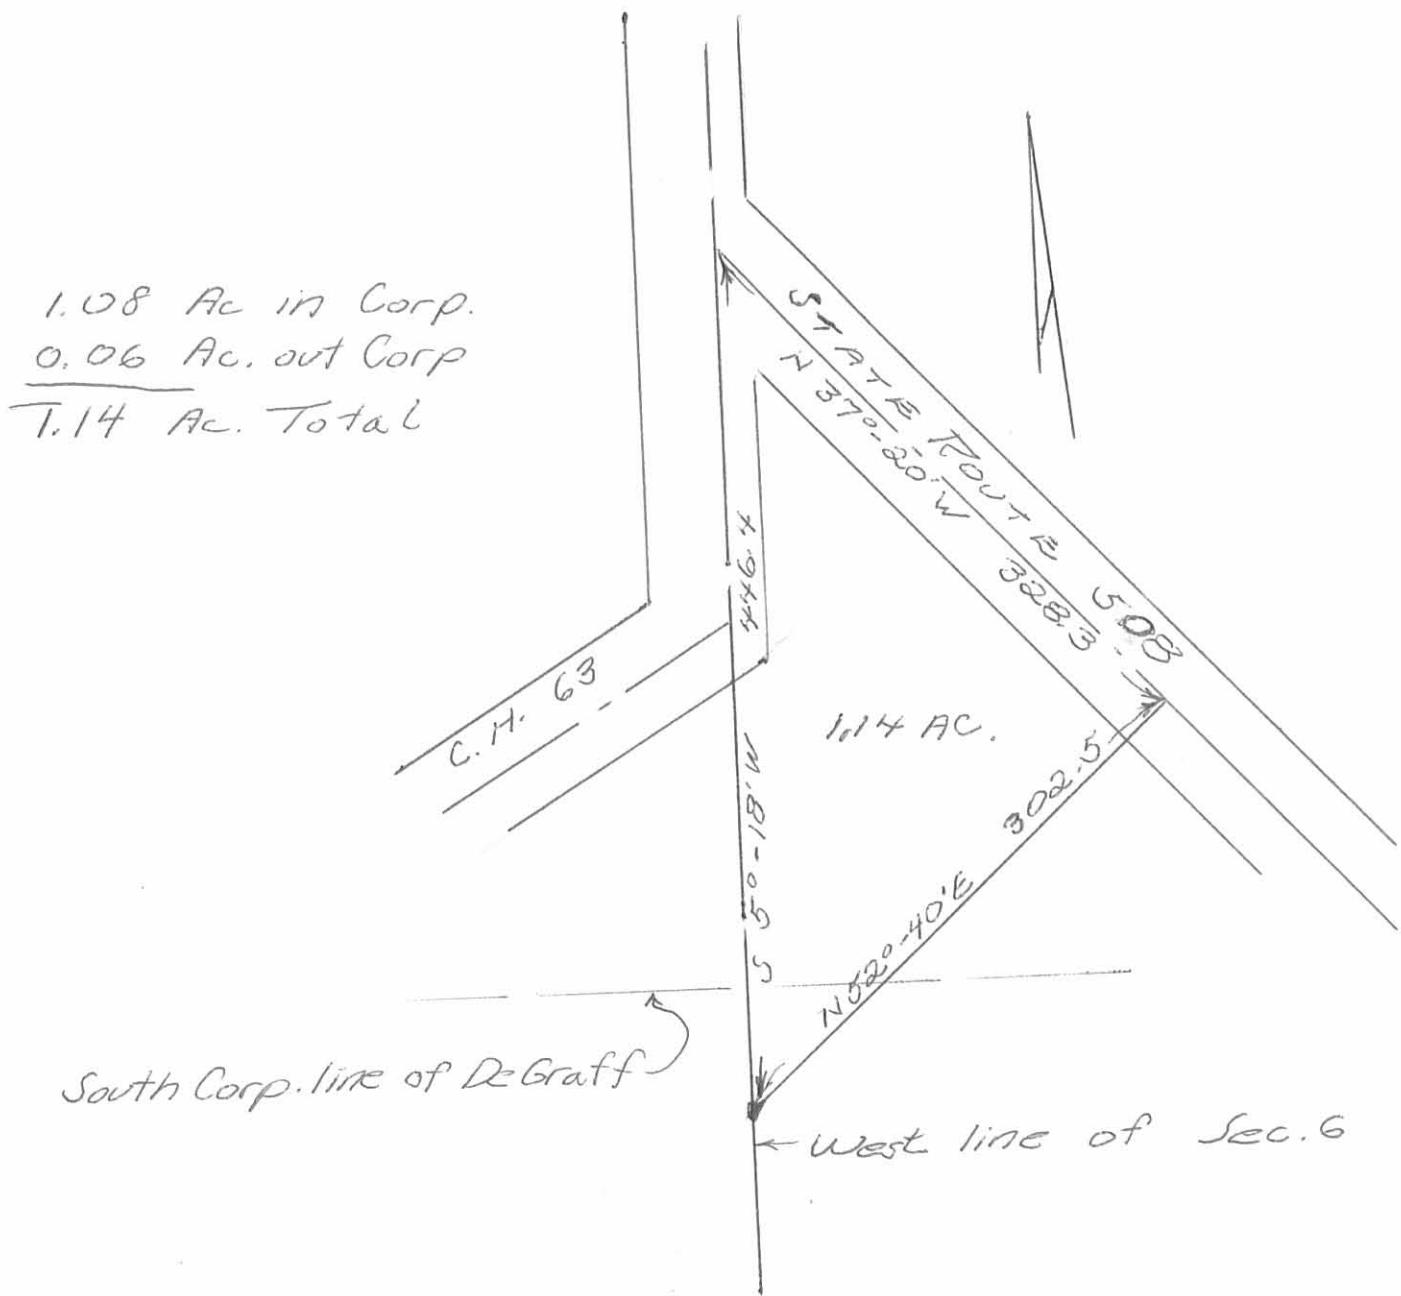

Owen K. Shirk
 Surveyor 4271
 Dec., 1975

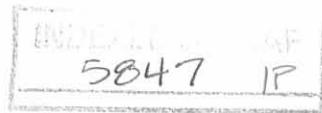

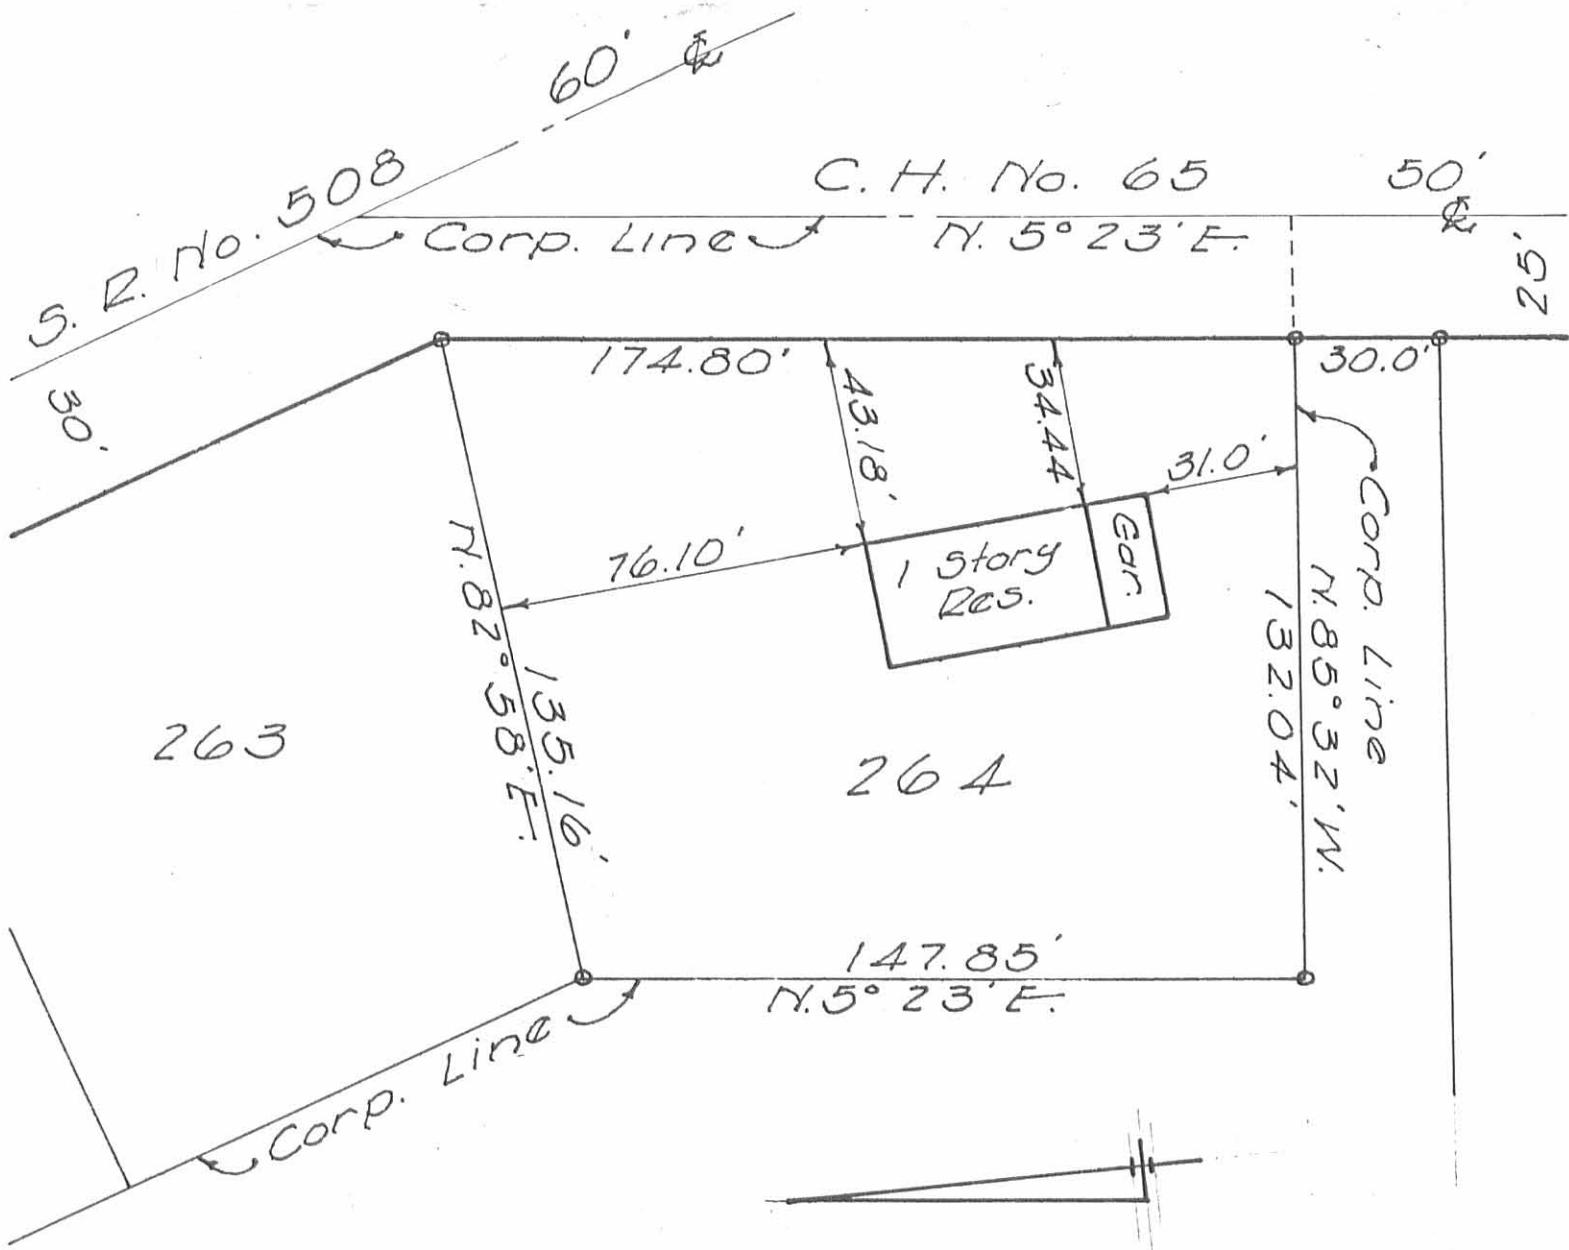

SURVEY OF LOT No. 264

VILLAGE OF DEGRAFF

MIAMI TOWNSHIP

LOGAN COUNTY, OHIO

APRIL 1, 1967

SCALE 1"=40'

○ = PIPE FOUND

I hereby certify that this plat is a correct representation of a survey made by me and that the same shows the improvements as located on the premises.

The improvements are entirely within the property lines and there are no encroachments on the premises by improvements on the adjoining premises.

Dan L. Dodson

Reg. Surveyor 4270
Bellefontaine, Ohio

