


Kerns Survey survey 3164
 East Liberty Ohio

(15)
 INDEXED ON MAP

Survey at East Liberty 11/17/24

W. H. Montgomery

Wm Smucker

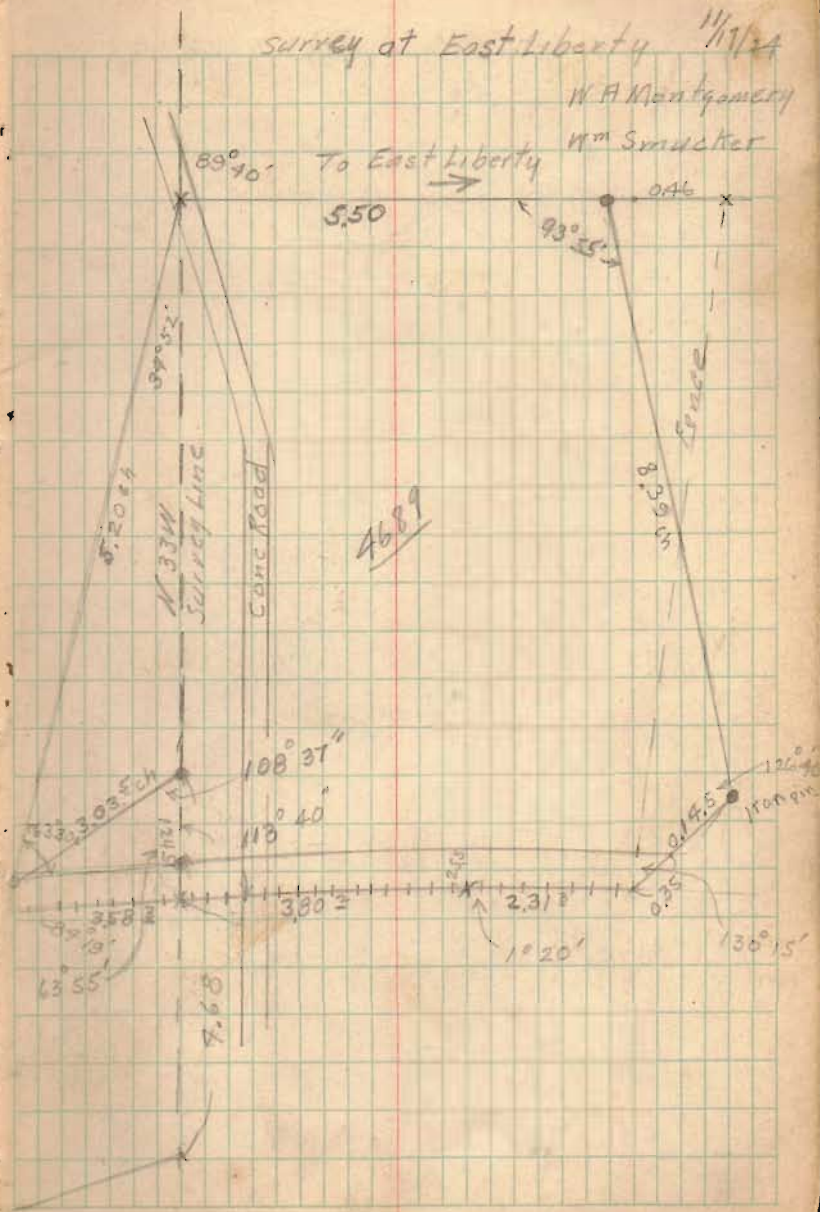

W 33 W
 3.035
 0.2044
 0.33