


Jacobs Swank Survey
 J. Hudson
 Harrison Township
 Sec. 23 Town 3 Range 14

11/7/23
 Clear
 Windy

Wright
 Mr. Swank
 Mr. Hudson

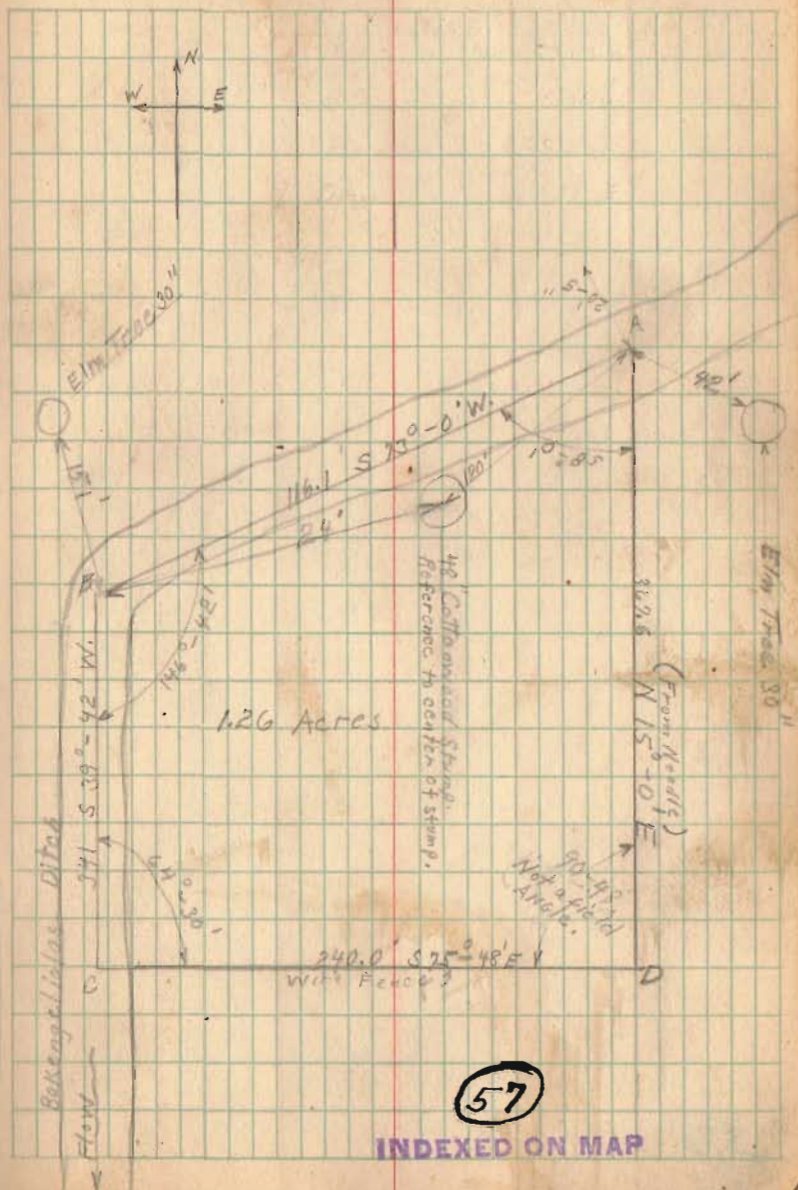

57

INDEXED ON MAP

Jacob Swank, Survey.

J. Hudson "

Sec. 23 Town 3 Range 14

11/7/23

Line	Bearing	Length	Latitude North	South	Departure East	West	D.M.O.	Double	Area
CD	S 75-48 E	240.0		-58.9	+233.2		+ 233.2	+	13235.48
DA	N 45-0 E	303.6	+355.1		+ 95.1		+ 561.5	199388.65	
AB	S 70-0 W	116.1		-33.9		-111.0	+545.6		18485.84
BC	S 39-42 N	341.0		-262.4		-217.3	+217.3		56997.79
			+ 355.1	-355.1	+327.8	-327.8		+ 199388.7	89229.1
					+328.3	-328.3		- 89229.1	
							2	110157.6	
								55079.8	
								55079.8	1.26 Acres
								43560	