


# SURVEY YMCA at SILVER LAKE

1773  
Sec 16 ~~74~~ R14  
August 1720

(231)  
INDEXED ON MAP

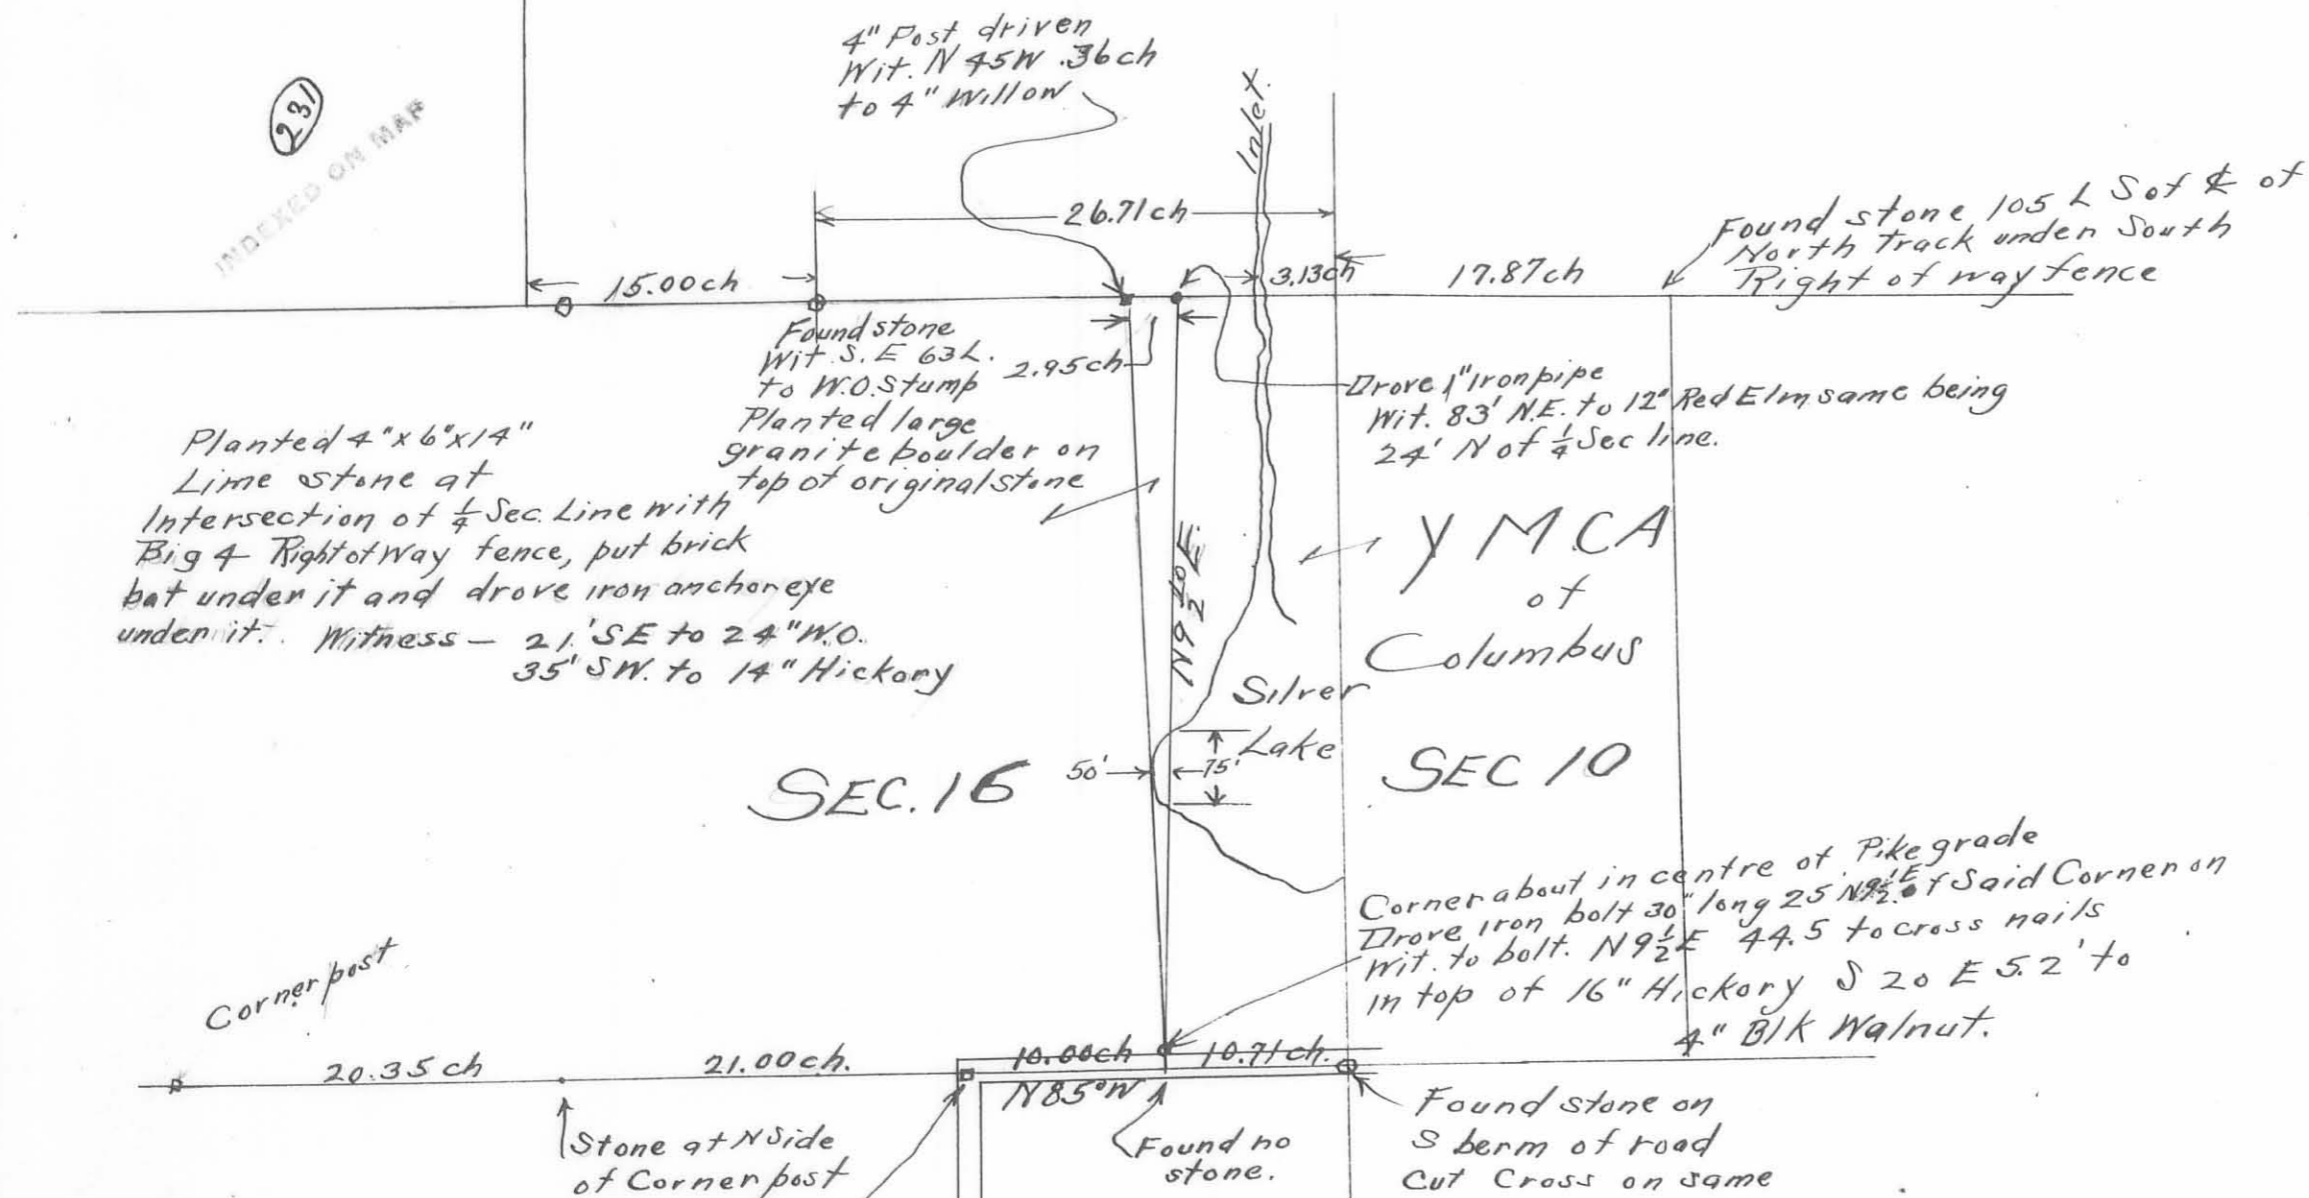

Surveyed Aug 24, 26 and  
27th by  
E. H. Newell  
Deputy Co. Surveyor

SEC 15

SEC 9