

M^c Kenzie Harrison Twp.


Sec. 5 T. 3 R. 14

- A - Cross on Concrete made by Wright.
- B " " " " " "
- C Stake Placed by Wright.
- D Stake and Stone (Stake Placed by Wright)
- E Old Stone Found.

591
INDEXED ON MAP

April - 30 - 1926
Very Windy
Wright
Smucker

41

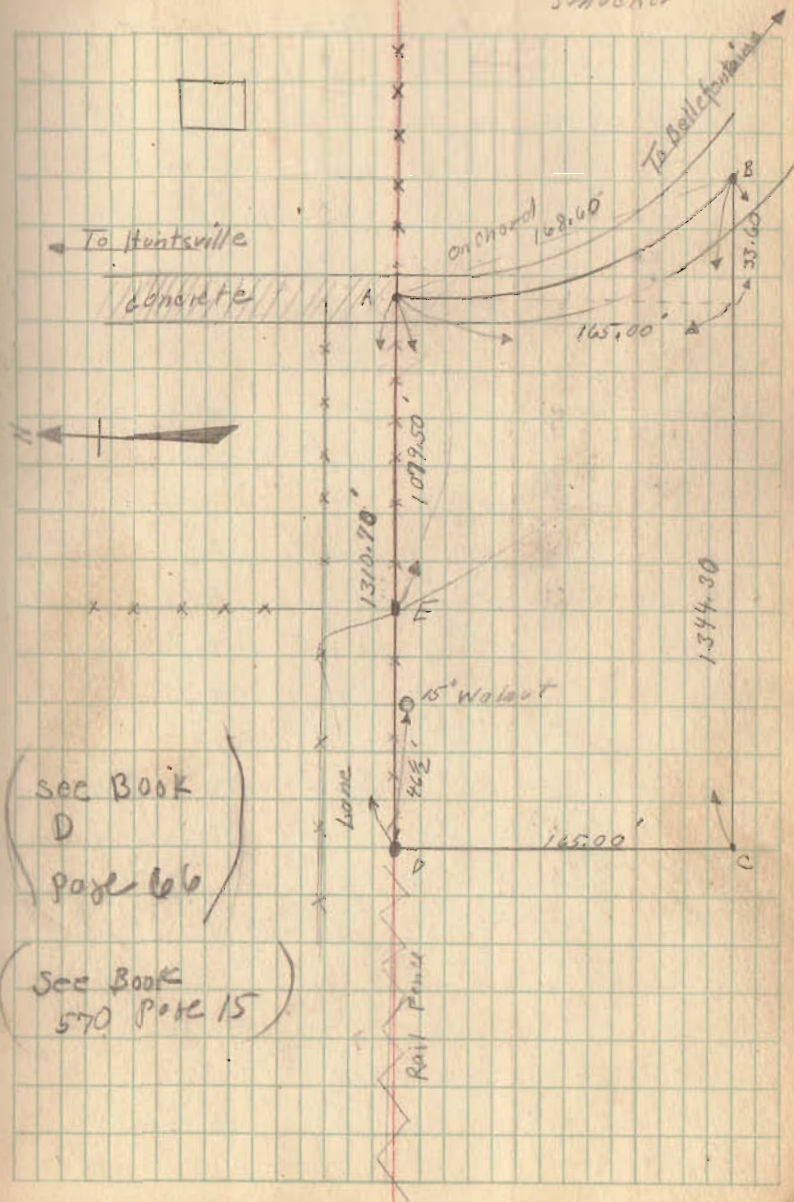

(see Book
D
page 66)

(see Book
570 page 15)