

Road. 216  
Lake and Harrison Twp's


35' - Road Record No. 3 Page 104  
109

1667  
INDEXED ON MAP

Road 200

July - 12 - 1935  
cloudy  
E. core 26

W. E.

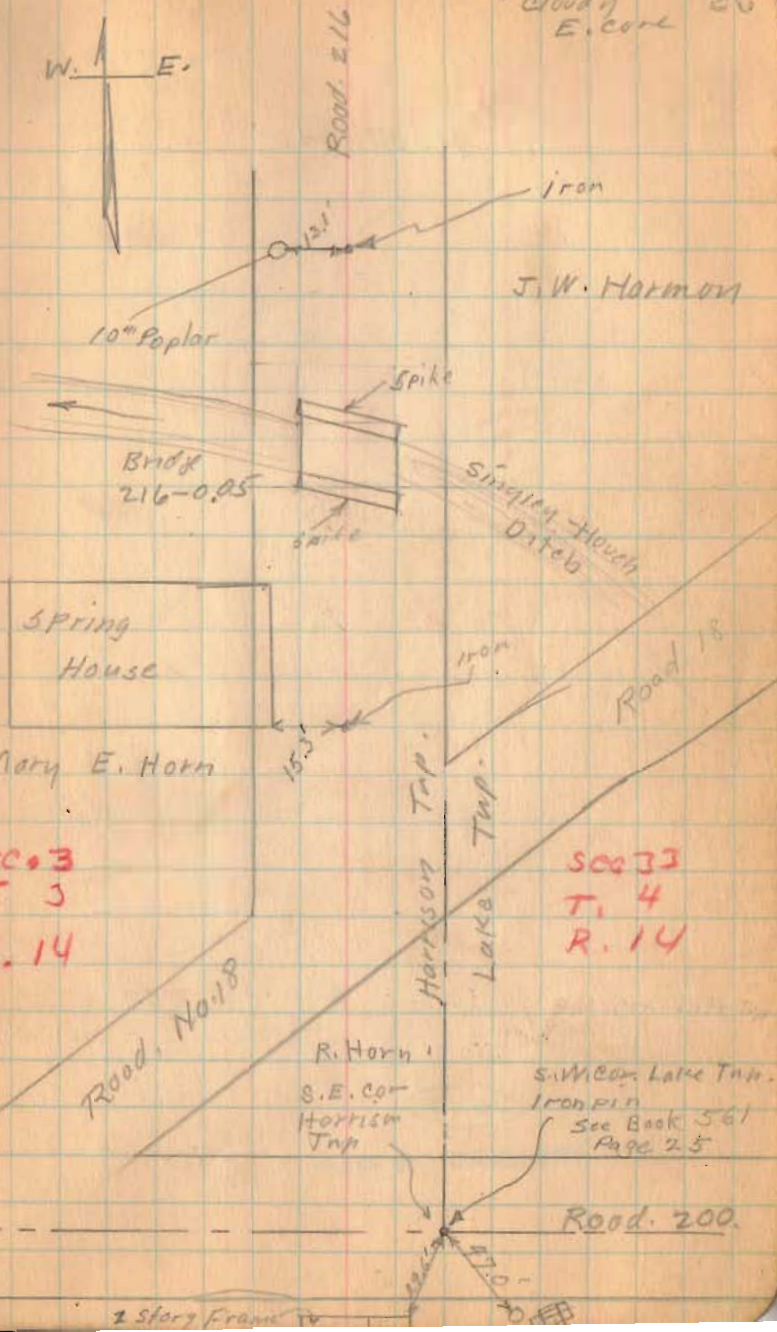

Sec. 3  
T. 3  
R. 14

Sec. 3  
T. 4  
R. 14

R. Horn  
S.E. cor  
Harrison  
Twp

S.W. cor. Lake Twp.  
Iron Pin  
See Book 561  
Page 25

Road 200

2 story frame

Road. 216

A. J. Detrick.

steel post  
x x x  
clarence Kerr.

36.2'

Harrison Twp.

Lake Twp.

2' post  
Rail Fence  
Stone  
30" History

J. W. Harmon

17.5' x 17.5'

North  
N 6° E

1667

INDEXED ON MAP

7-12-35 27