

Oct. 24-1936  
 Fine day  
 F. Wright  
 & Pusey 23

Brown Survey  
 Harrison Township  
 Sec. 4 T. 3 R. 14

s.H. 234  
 Route 47  
 Sidney Pike

R/W. 200  
 500  
 400  
 400

N.W. cor of  
 N.W. 1/4 Sec. 4

163.4


500.4

Distances shown as per Deeds.

Note there is some question whether  
 distances begin in E or S. side of pike

See Survey 7 Book 492 Page 17

See Survey 1185 Book 521 Page 14

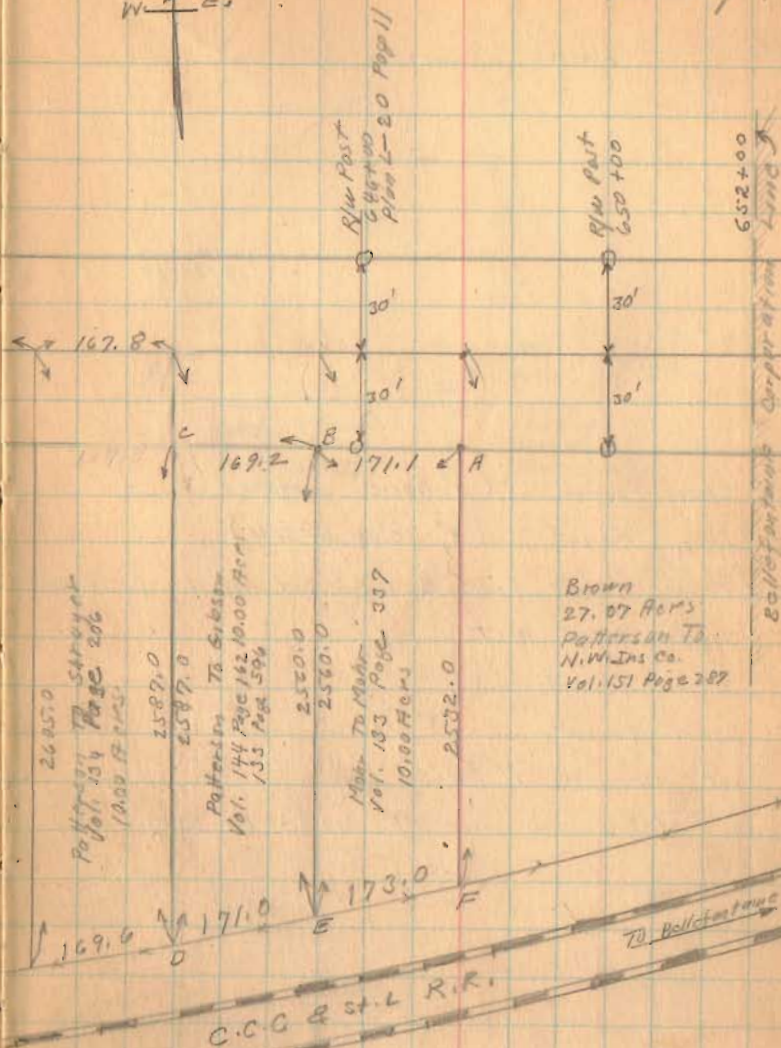

1757

(over)


Brown Survey

S.H. 239  
ROUTE 47

- A - Iron Found. (3" Above surface)
- B - Iron Found. (8" Below surface)
- C - Fence 169.2 from B O.K. Did not dig for Iron
- D - Square Wood Post
- E - Iron found.
- F - Iron found.

Did not measure N. and S. Lines

Set stakes on line AF approx 150' apart

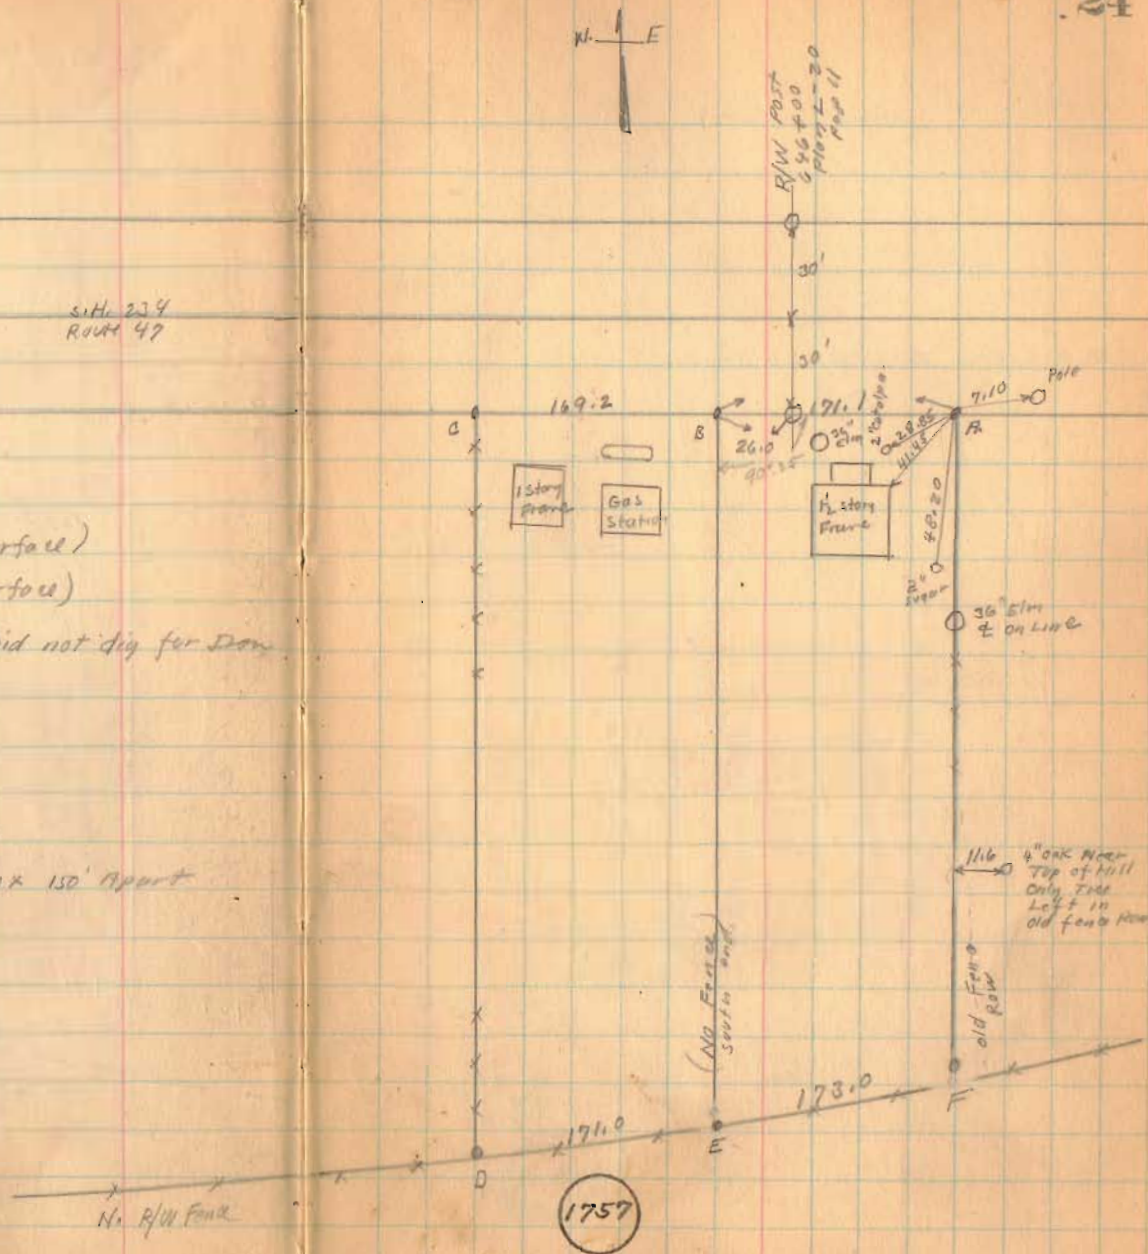

(over)

Brown Survey

Patterson, To NW Life Ins Co.  
Vol. Page.

