



SURVEY FOR
 THE LOGAN COUNTY COMMISSIONERS
 SEC. 12 T-3 R-14


HARRISON TOWNSHIP
 LOGAN COUNTY, OHIO
 MAY, 1979

SCALE 1" = 100'

CHESTER R. LULTZ LOGAN COUNTY ENGINEER

Surveyed by
 C. R. LULTZ
 Survey No. 4270
 5/79

INDEXED ON MAP
 20422P

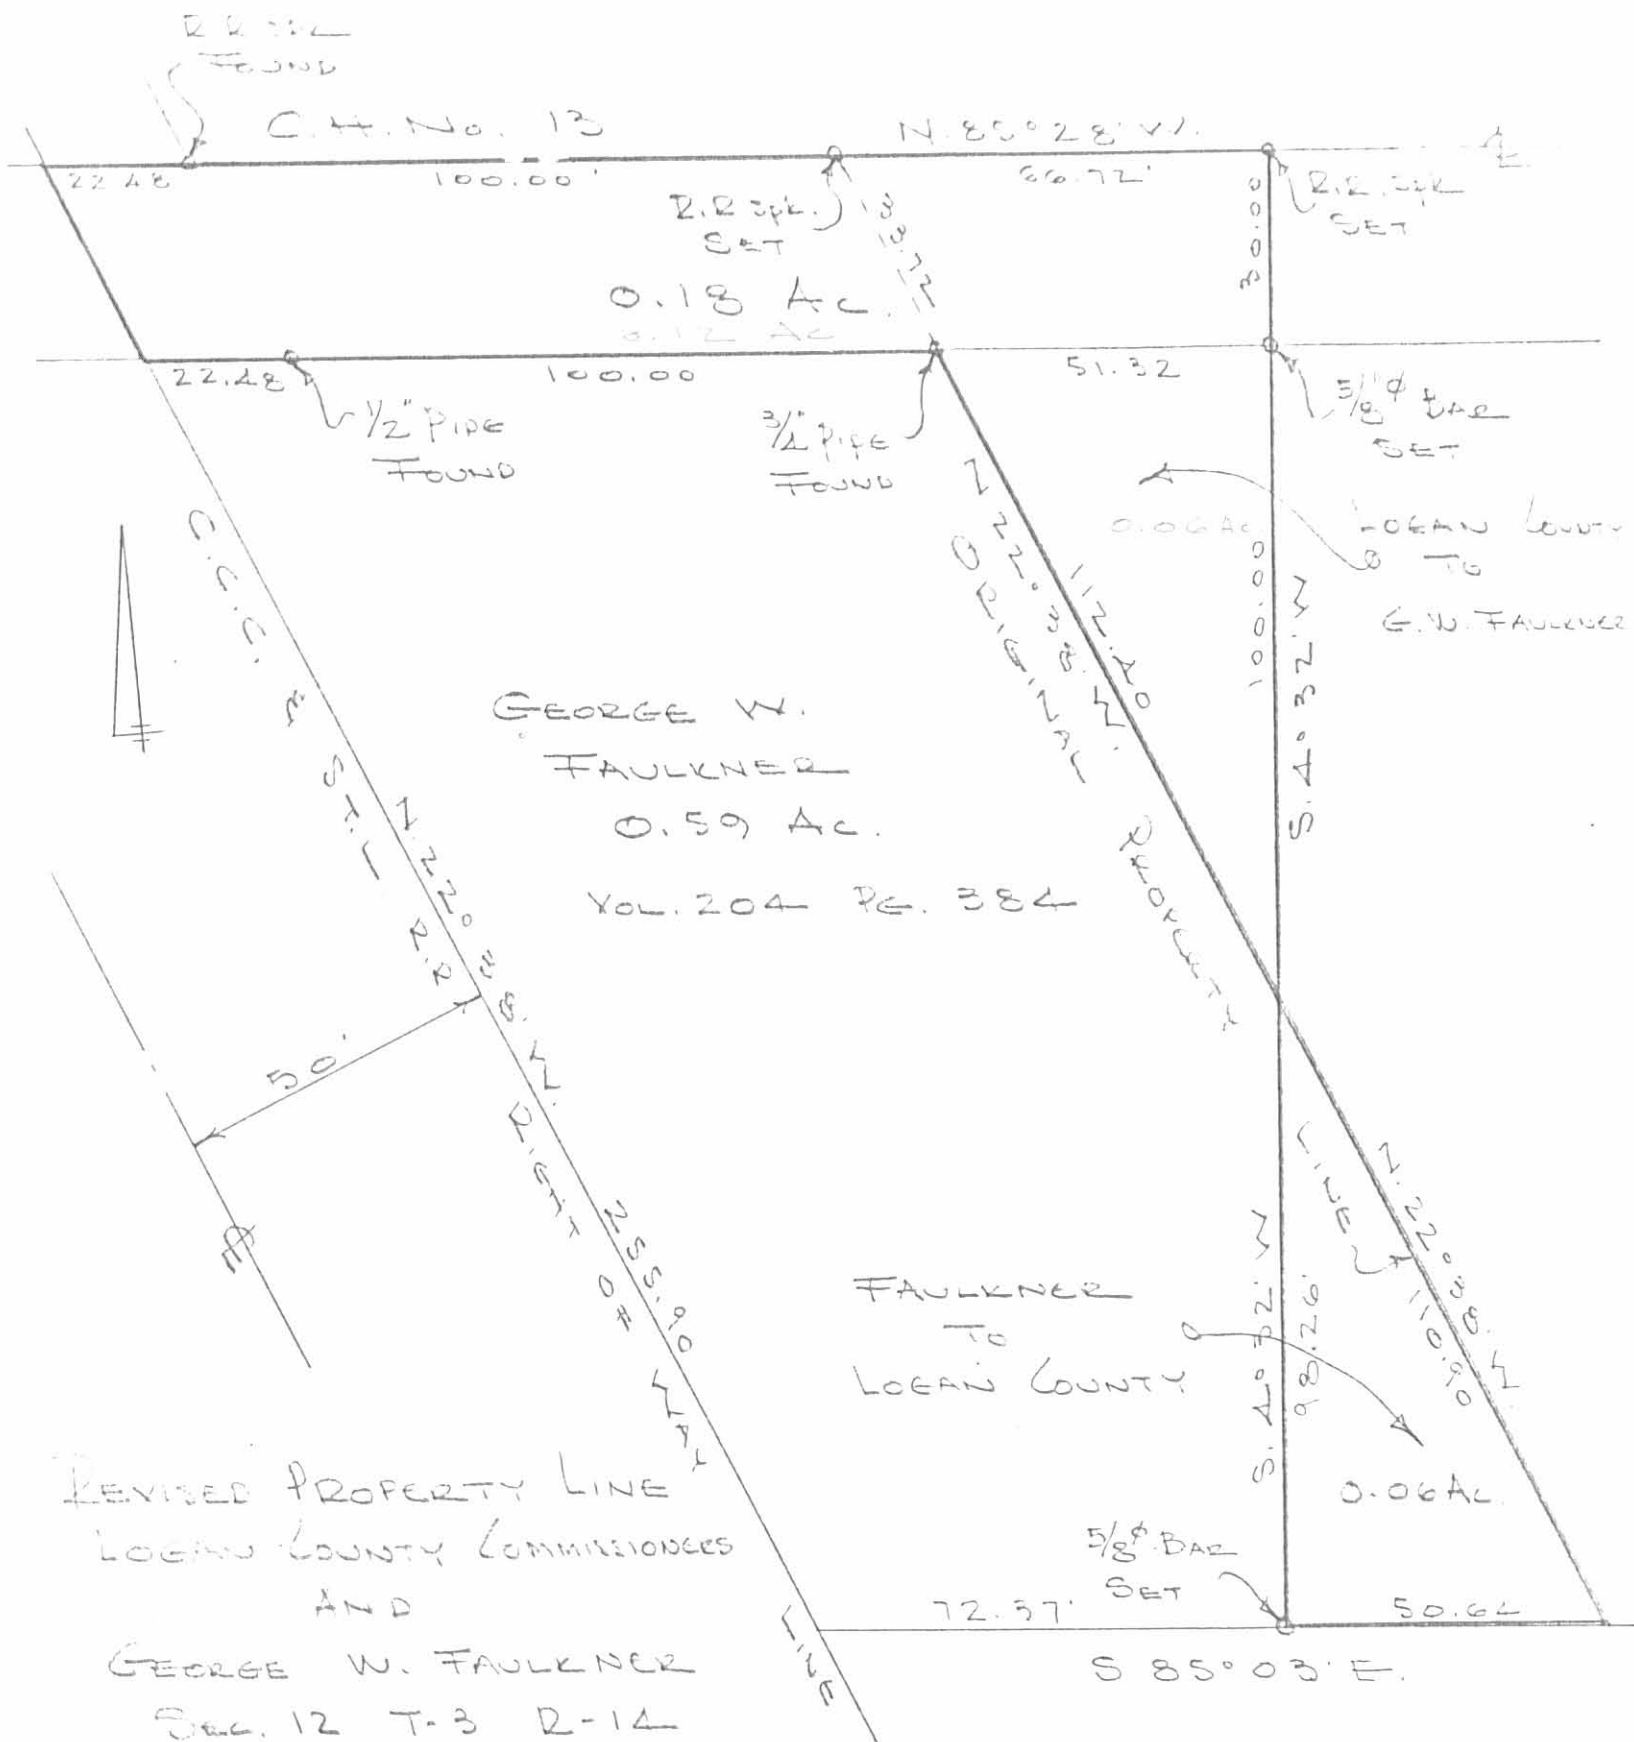

GEORGE W.
 FAULKNER
 0.59 Ac.
 VOL. 204 PG. 384

REVISED PROPERTY LINE
 LOGAN COUNTY COMMISSIONERS
 AND
 GEORGE W. FAULKNER
 SEC. 12 T-3 R-14
 HARRISON TOWNSHIP
 LOGAN COUNTY, OHIO
 OCTOBER, 1979
 SCALE 1" = 30'

INDEXED ON MAP
 2042 3P


DAN L. DOBSON
 REG. SURVEYOR 4270
 FEB. 697 PG. 15
 MAY 2, 1979

FB 697

RESURVEY OF 1.96 AC. TR.
SEC. 12 T-3 R-14.

HARRISON TOWNSHIP

- A = STONE FOUND @ C.H. 13 & C.H. 32
N.E. COR. OF S.E. 1/4 SEC 12-3-14
- B = R.R. SPIKE FOUND 4" deep
- C = R.R. SPIKE SET 1000.0' E. OF "B"
- D = 3/4" PIPE FOUND - SET BY W.V. SCOTT
- E = 3/4" Ø BAR FOUND " " " ?
- F = 1/2" PIPE FOUND " " " ?

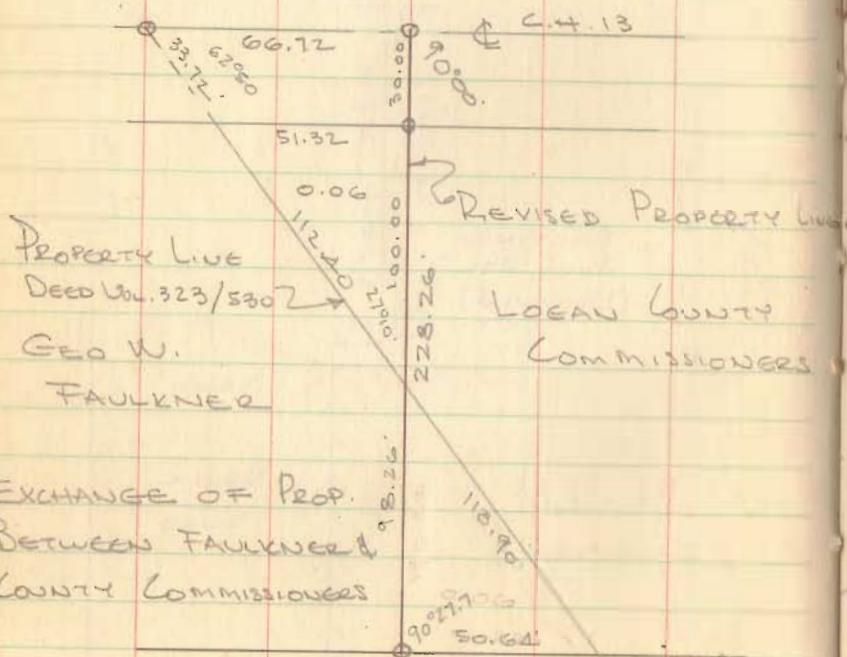

Dodson
Nichols
Pruitt

5/2/79

15

NOTE: LOT REVISED 7/11/79
to 143.0' Frontage.

