



2/23/43

City Engineers Record

Iron bar set in position of old section stone.

See City Engineer's Record

Iron pin  $1\frac{1}{8}$ " x 30" found witnessed by City Engineer's Records. Said iron bar removed and concrete Monument 48" long set approx. 0.3' below road surface at exact position of iron bar mentioned above and in City Engineer's Record.


Lawrence KERN

R. H. Reed

Monument drilled and stamped as directed above

RHR

3-23-43

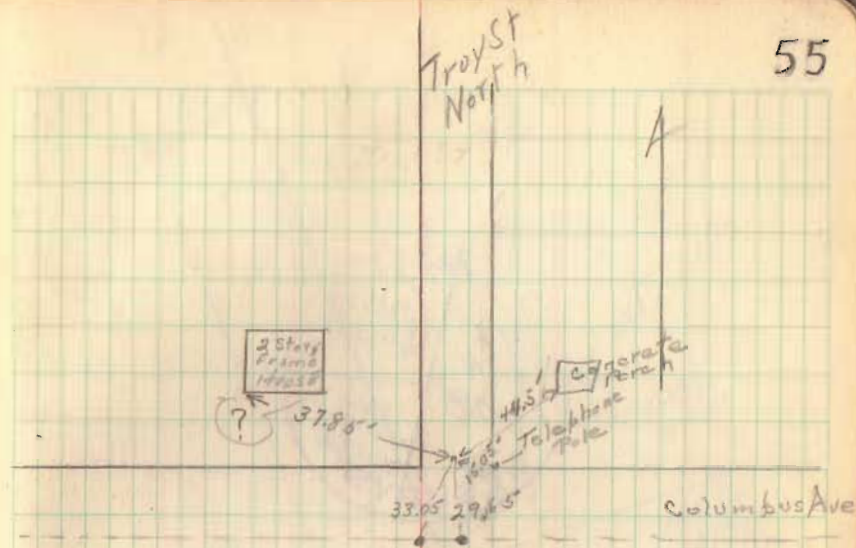

Harrison

Lake

2667

Witness from Thesis

O.S.U. 1943

INDEXED ON MAP

"Extension and Application of Horizontal Control"  
By Coray, Harper & Mavromatis

SEE Field Book

654-P28

Troy St  
South