

FB 687

Rd #46
Harrison Twp.

Sta

P.I. 26700

Iron found

P.C. 24+11.8

Hub set for 50' w

20+00

Hub set for 50' w

15+00

Hub set for 50' w

10+00

Hub set for 50' w

5+00

Hub set for 50' w

1+00

Hub set for 50' w

0+00


Iron pipe found

RIW Monuments set July 1952

June 28, 79

D. Shirk
M. Keyser
V. DeWick
B. Heeringer

13

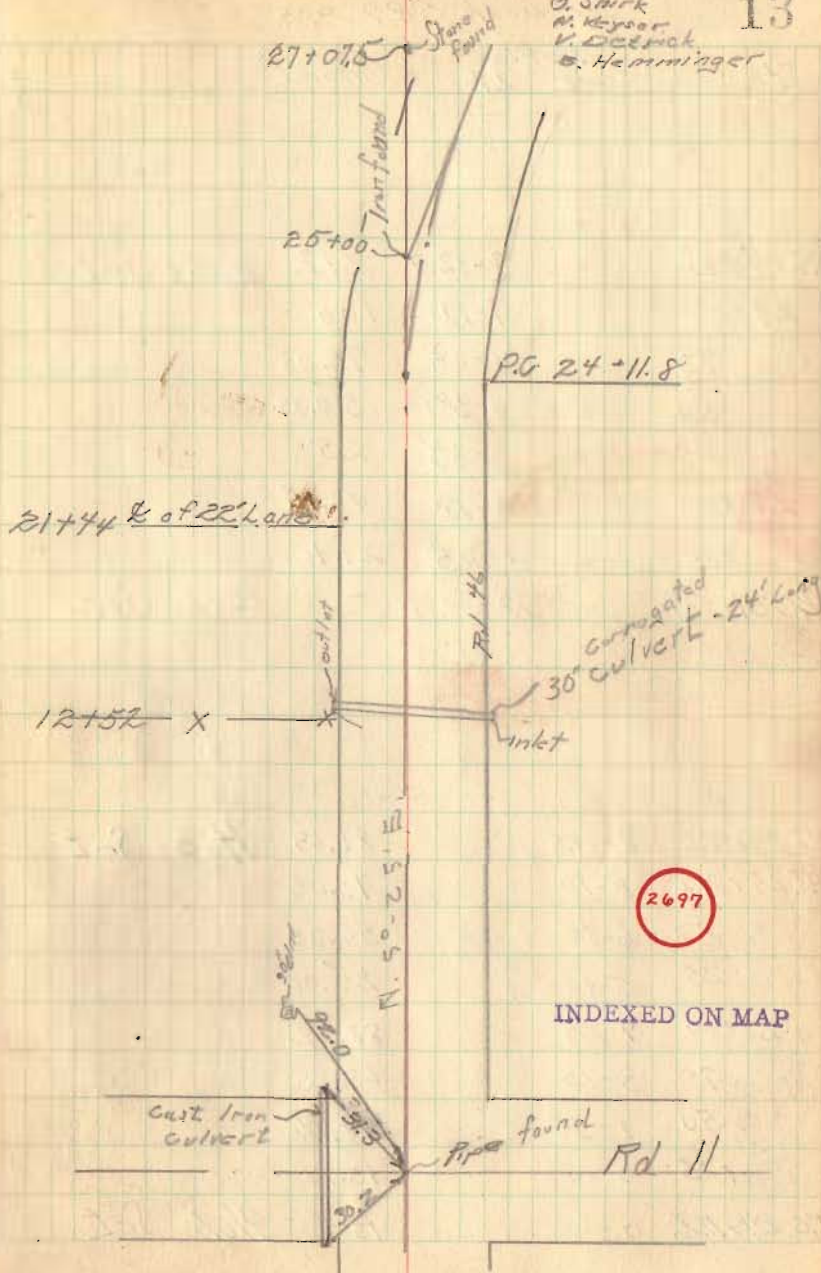

FB 687

Road # 46
Sec book 589 page 28

Sta	Dist. RL. Lt.	Chord	
PT. 29+24.2	8-32.5	24.2	Hubs Set
29+00	7-20	1.00	
75	6-05	75.05	
50	4-50	50.05	
25	3-35	25	
28+00	2-20	46.65	
75	1-05	21.6	
P.C. 27+53.4	0-00	-	Hubs Set
PT. 25+86.6	8-44.5	86.63	Hubs Set
75	8-10	75.05	
50	6-50	50.05	
25	5-40	25.02	
25+00	4-25	88.22	
75	3-10	63.75	
50	1-55	38.25	
75	0-40	13.2	
P.C. 24+11.8	0-00	15	Hubs Set

14

June 27 49
O. Shirk
H. Keyser
V. Detrick

