

Linkenhoker Survey Harrison Township Oct. 1961 1.00 Acre

The following described land in Harrison Township, Logan County, and being in Section 3 Town 3 Range 14

Beginning at an iron in the center of County Road Number 216 known as the Troy Road, at the S.E. corner of Maud G. Coover's 104.75 acres.

Thence with the center of said Troy Road S. 6 - 00 W. 208.75 feet to an iron for the beginning point of this survey.

Thence N. 84 - 26 W. 208.75 feet to an iron. The last described line passing an iron at the west side of said Troy Road at 17.50 feet. The last described line also being 208.75 feet south of and parallel with the south side of said Coover 104.75 acre tract.

Thence S. 6 - 00 W. 208.75 feet to an iron.

Thence S. 84 - 26 E. 208.75 feet to an iron in the center of said Troy Road. The last described line passing an iron at the west side of said Troy Road at 191.25 feet.

Thence with the center of said Troy Road N. 6 - 00 E. 208.75 feet to the place of beginning.

Said described tract contains 1.00 acre and is off of the east side of Humbert Linkenhoker's present 40.00 acre tract.

cc  
Logan County Engineer




2792  
ID  
INDEXED ON MAP  
G - Plat Book

Recd 6-2-05 OK JWB


LEGEND:

- ⊙ = 1/4" PIPE FOUND
- = 5/8" IRON BAR SET

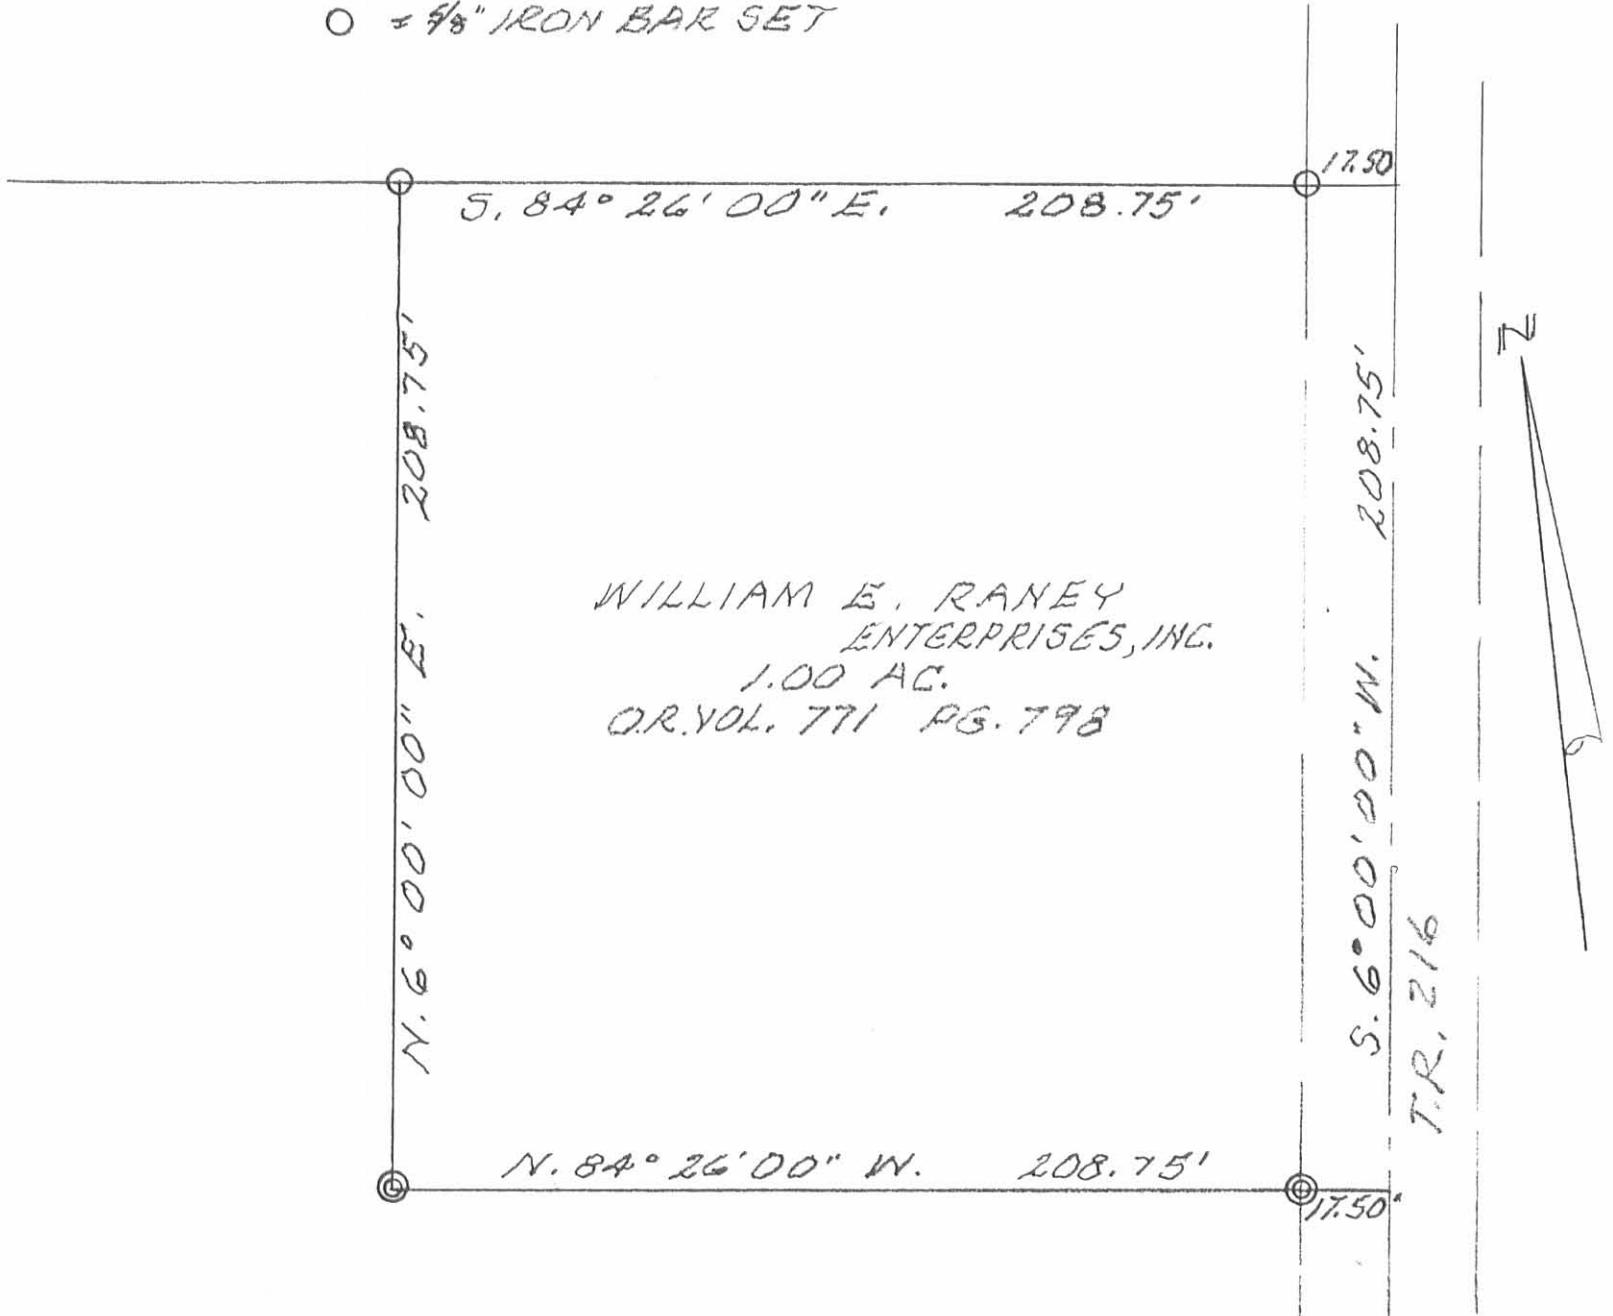

RESET N.E. & N.W. CORNERS OF RANEY 1.00 AC. TRACT. SECTION 3, TOWN 3, RANGE 14, HARRISON TOWNSHIP, LOGAN COUNTY, OHIO.

JUNE 1, 2005  
SCALE: 1" = 40'

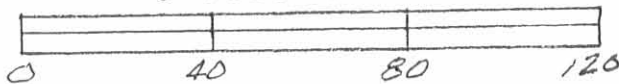

*Leslie H. Geeslin*  
LESLIE H. GEESLIN  
RUSHSVANIA, OHIO  
PH 937-468-7645

INDEXED ON MAP  
27922P