


✓
22+76.05 74°16'R Hub Found Set 3/4" Bar

✓
13+37.20 91°-36'L Hub Found Set 3/4" Bar
7/15/59 D.L.D.

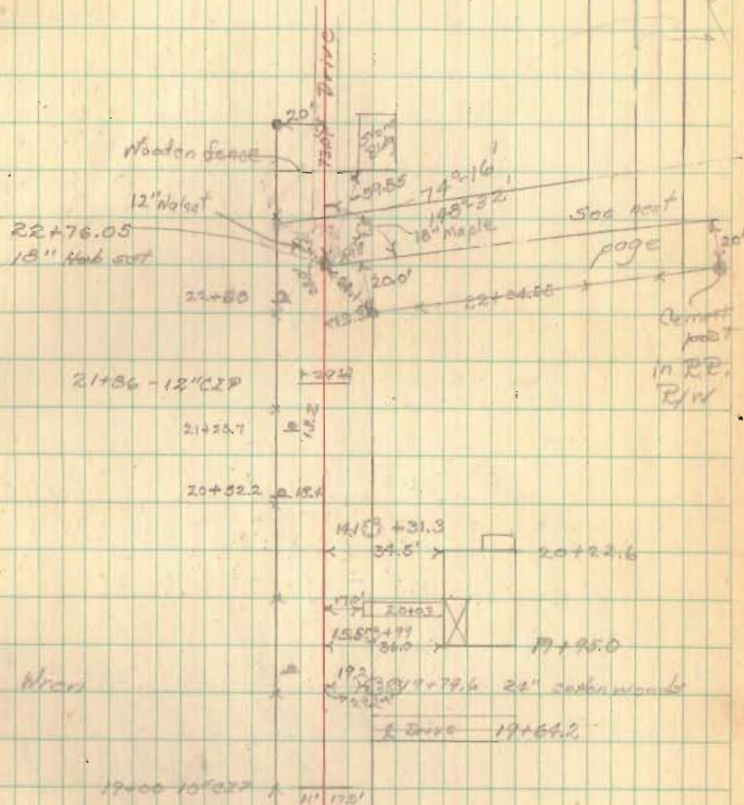

3592

Pd 11 (contd)


24+66.26 73°-27' L Hub Found, Set 3/4" Bar

22+76.05


22+76.05

12

24+66.25
22+76.05
490.20

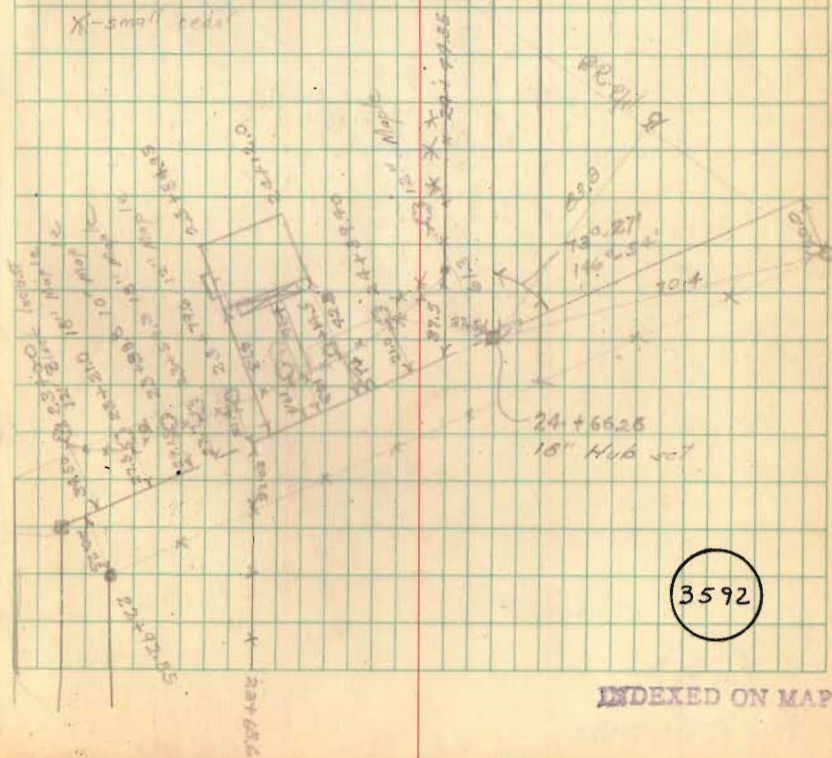

Rd 11 (cont'd)
 could not find

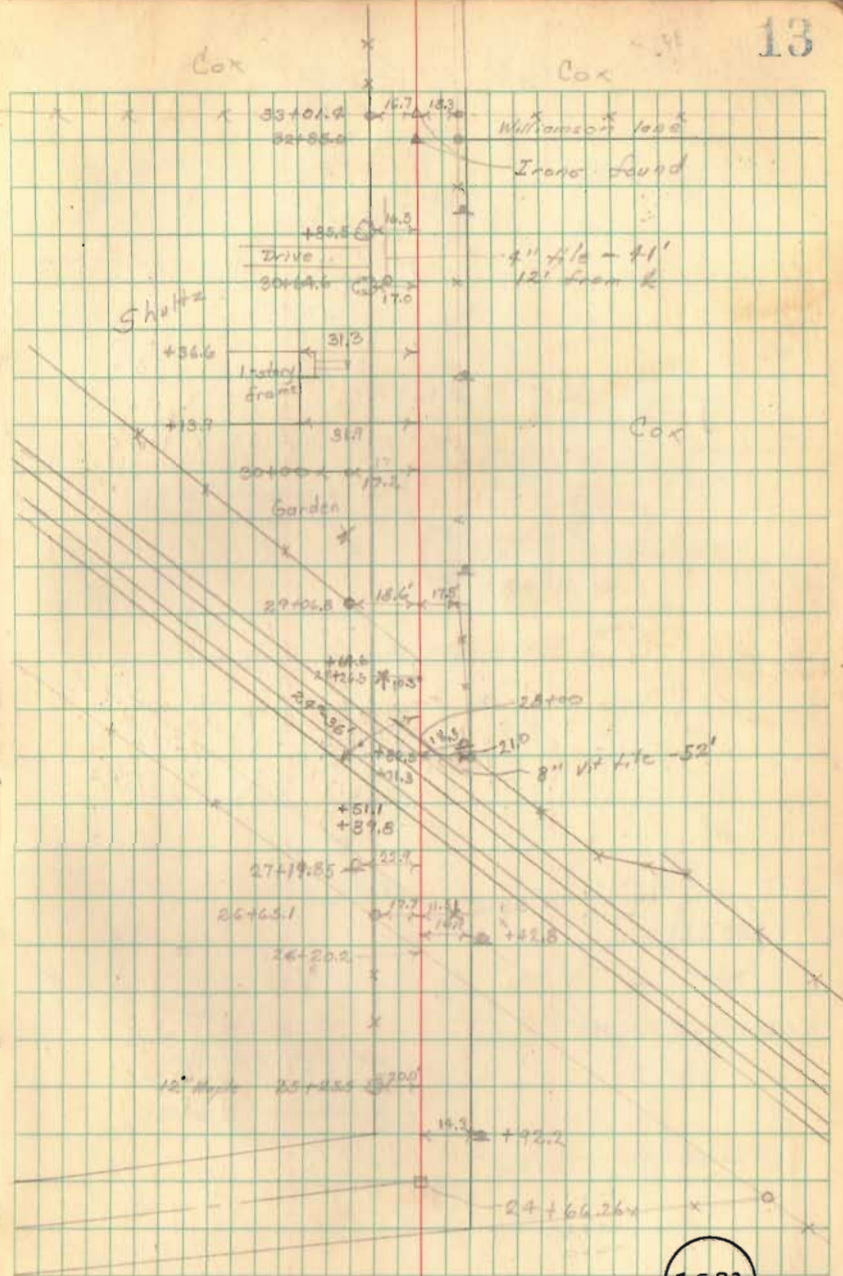

3592

Ed 11 (contd)

could not find

